


YARD N^o 83, — MIDSHIP SECTION — SCALE 1:25.

As built.

Midship Section
for

Odense Yard No 83.

Odense Skibskonstruktør $\frac{2}{5}$

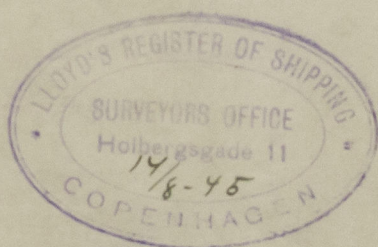


m/s. Caroline Marck.



Copenhagen Apt. No. 11757.

(1.)

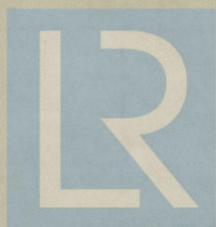

© 2020

Lloyd's Register
Foundation

002536-002542-0173