


12-5-23

6 x 5/8" or equivalent
Double angles, double riveted
See Sec 4 for 7/8"

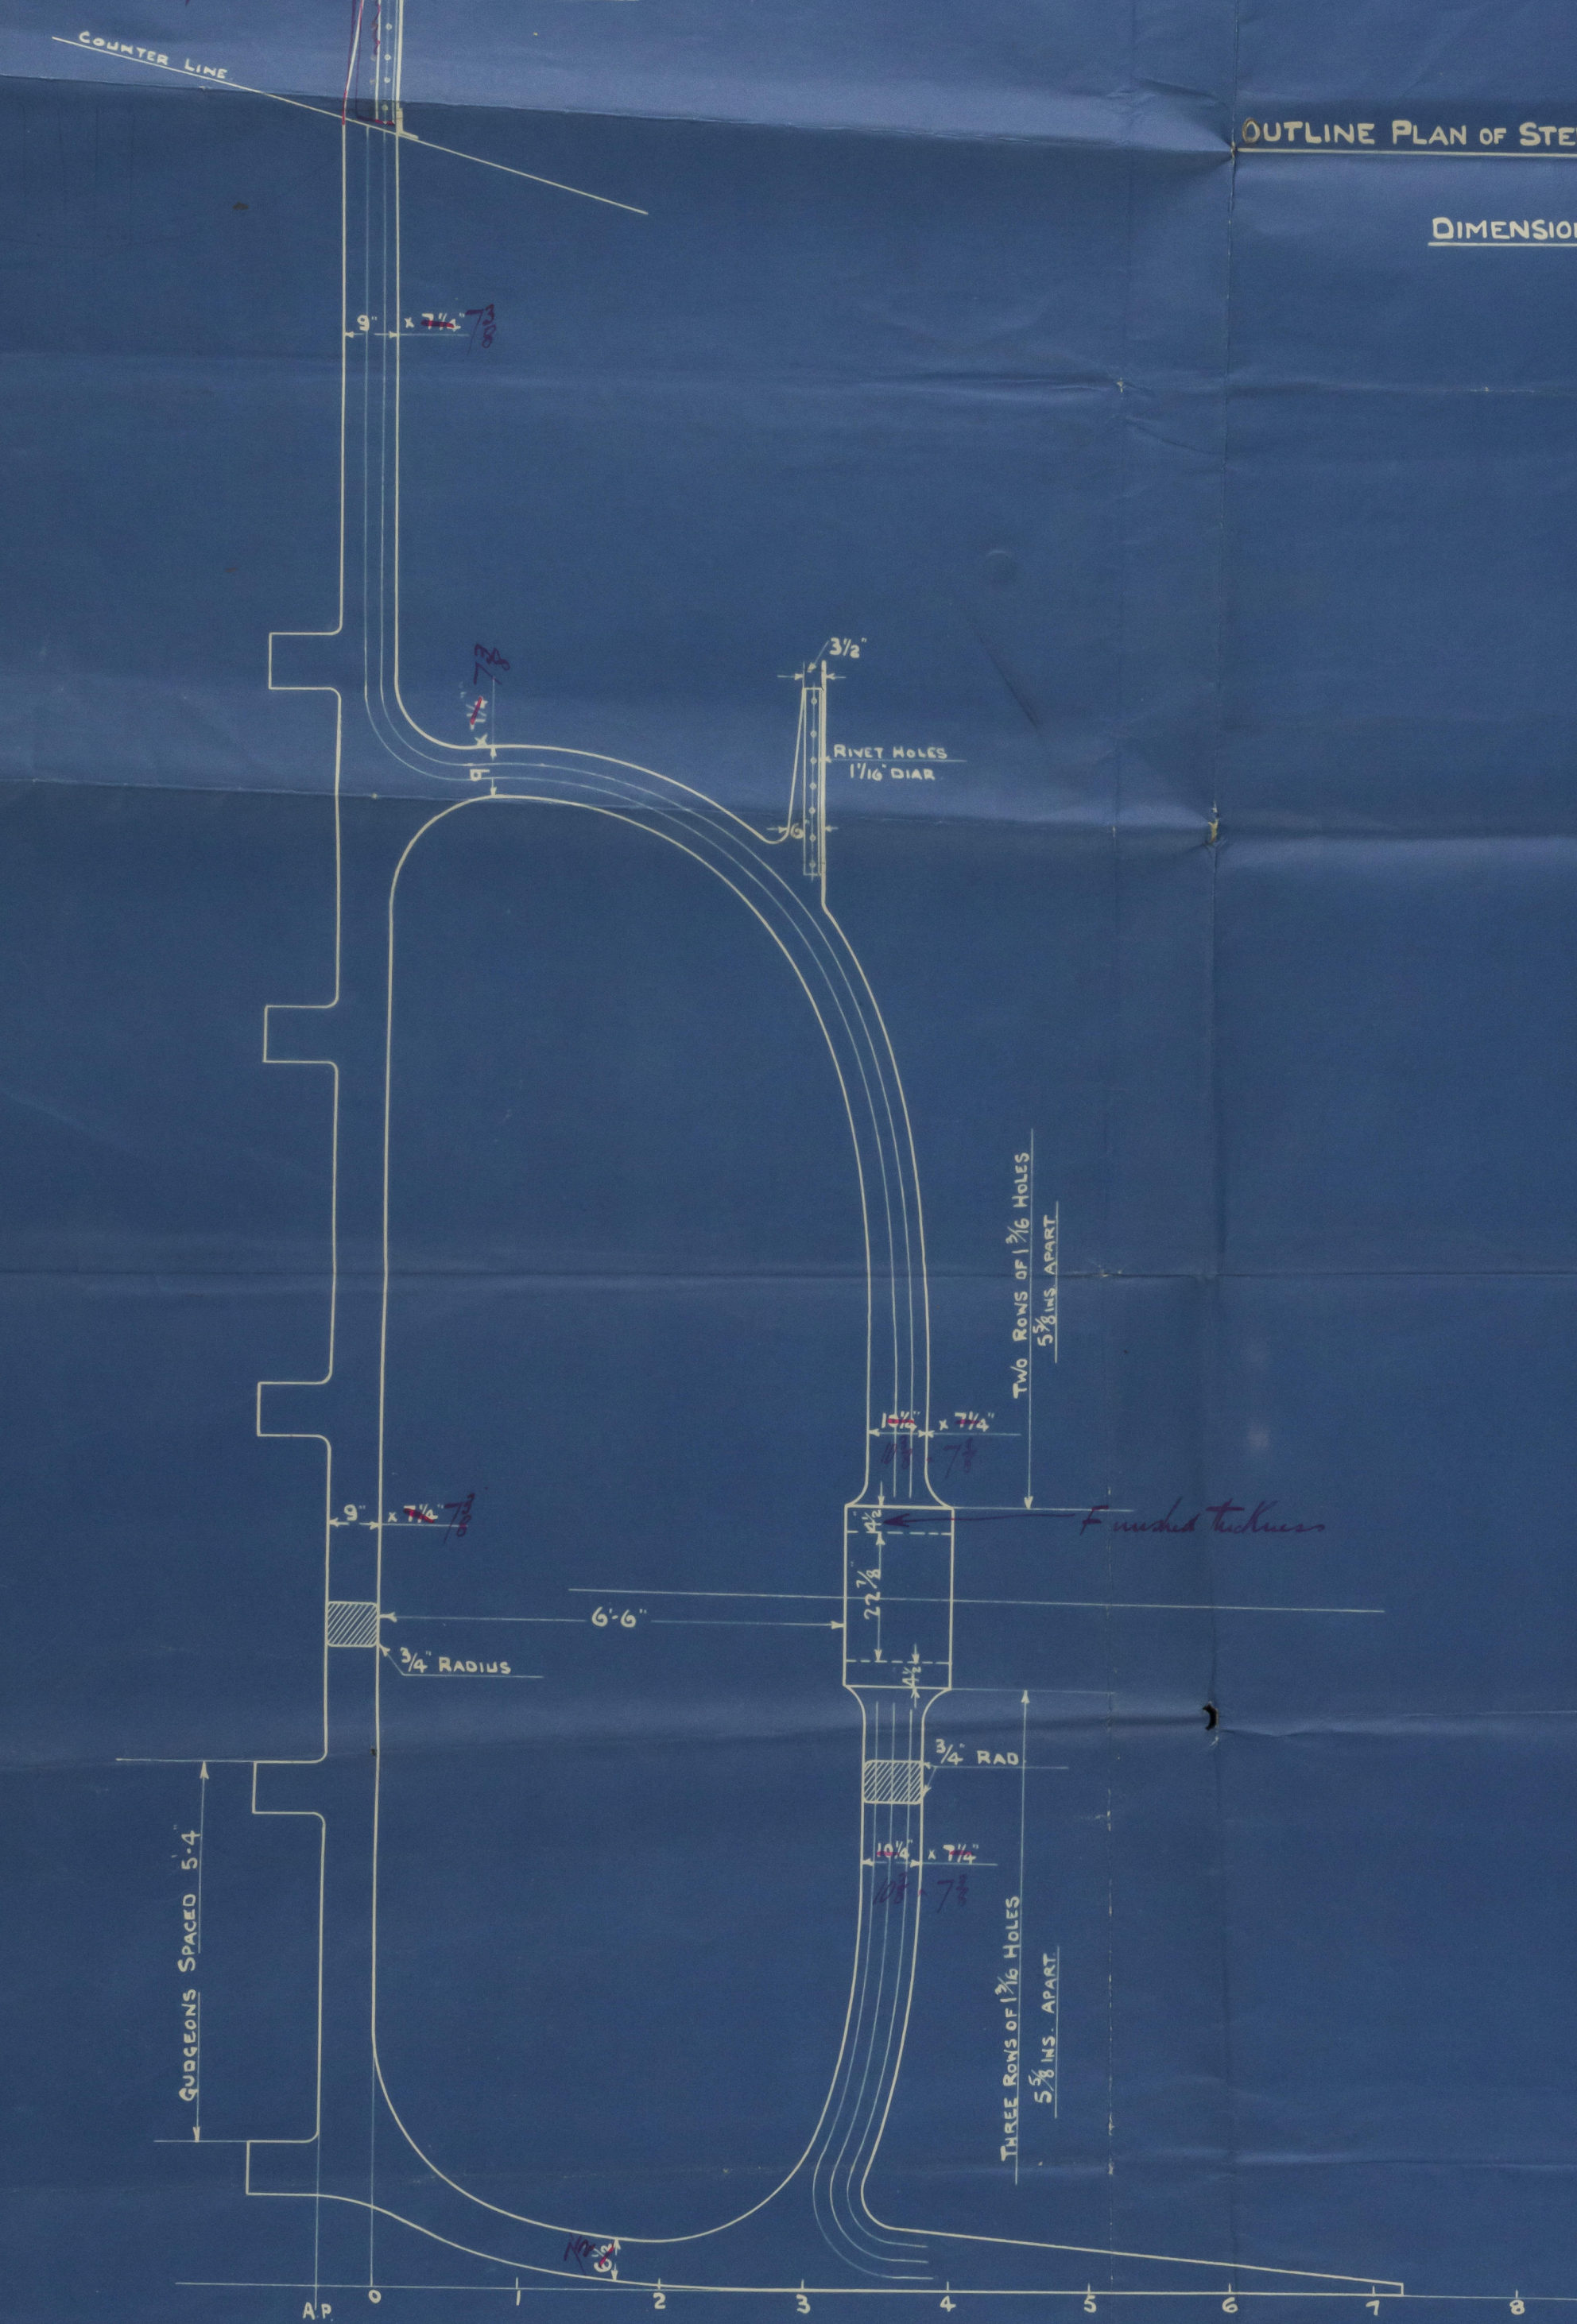



N° 469. 470 → 476

OUTLINE PLAN OF STERNFRAME PROPOSED SINGLE SCREW STEAMER.

DIMENSIONS 395'5" x 53'0" x 29'0" TO UPPER DECK.

SCALE 1/2" = 1 FOOT.

Finished thickness

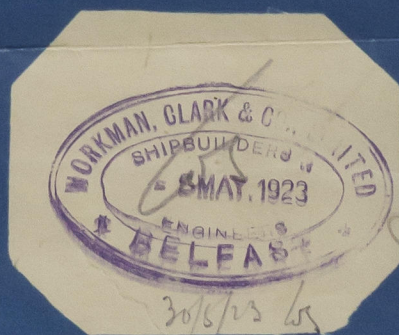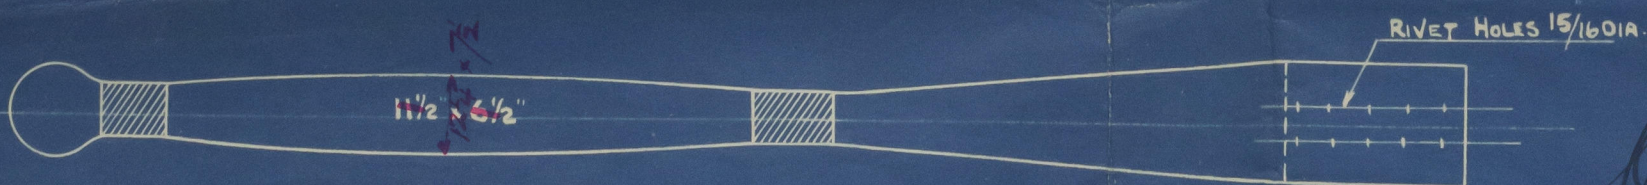

W. & A. Clark
12-5-23




Belfast.

Ss. Nos 469-70. & 476

Stem Frame.

469. ^u Ss. Arlington Court

Bel 9109

470 Ss. Barrington Court.

Bel. 9190

476. Errington Court-
Bel.



© 2020

Lloyd's Register

002543 002549-0131

Foundation