

PLAN N° 45.

N° 1307⁹


FRAMING PROFILE.

DIMENSIONS: 463'-0" B.P. x 61'-6" x 34'-0" MLD.

SCALE: 1/8" = 1 FOOT.


TO CLASS LLOYDS 100 A1 + CARRYING PETROLEUM IN BULK.
LONGITUDINAL FRAMING AT BOTTOM AND DECK.

ALL BULB ANGLE & CHANNEL SECTIONS ARE N.B.S.
ALL BULB PLATE SECTIONS ARE N.B.S.

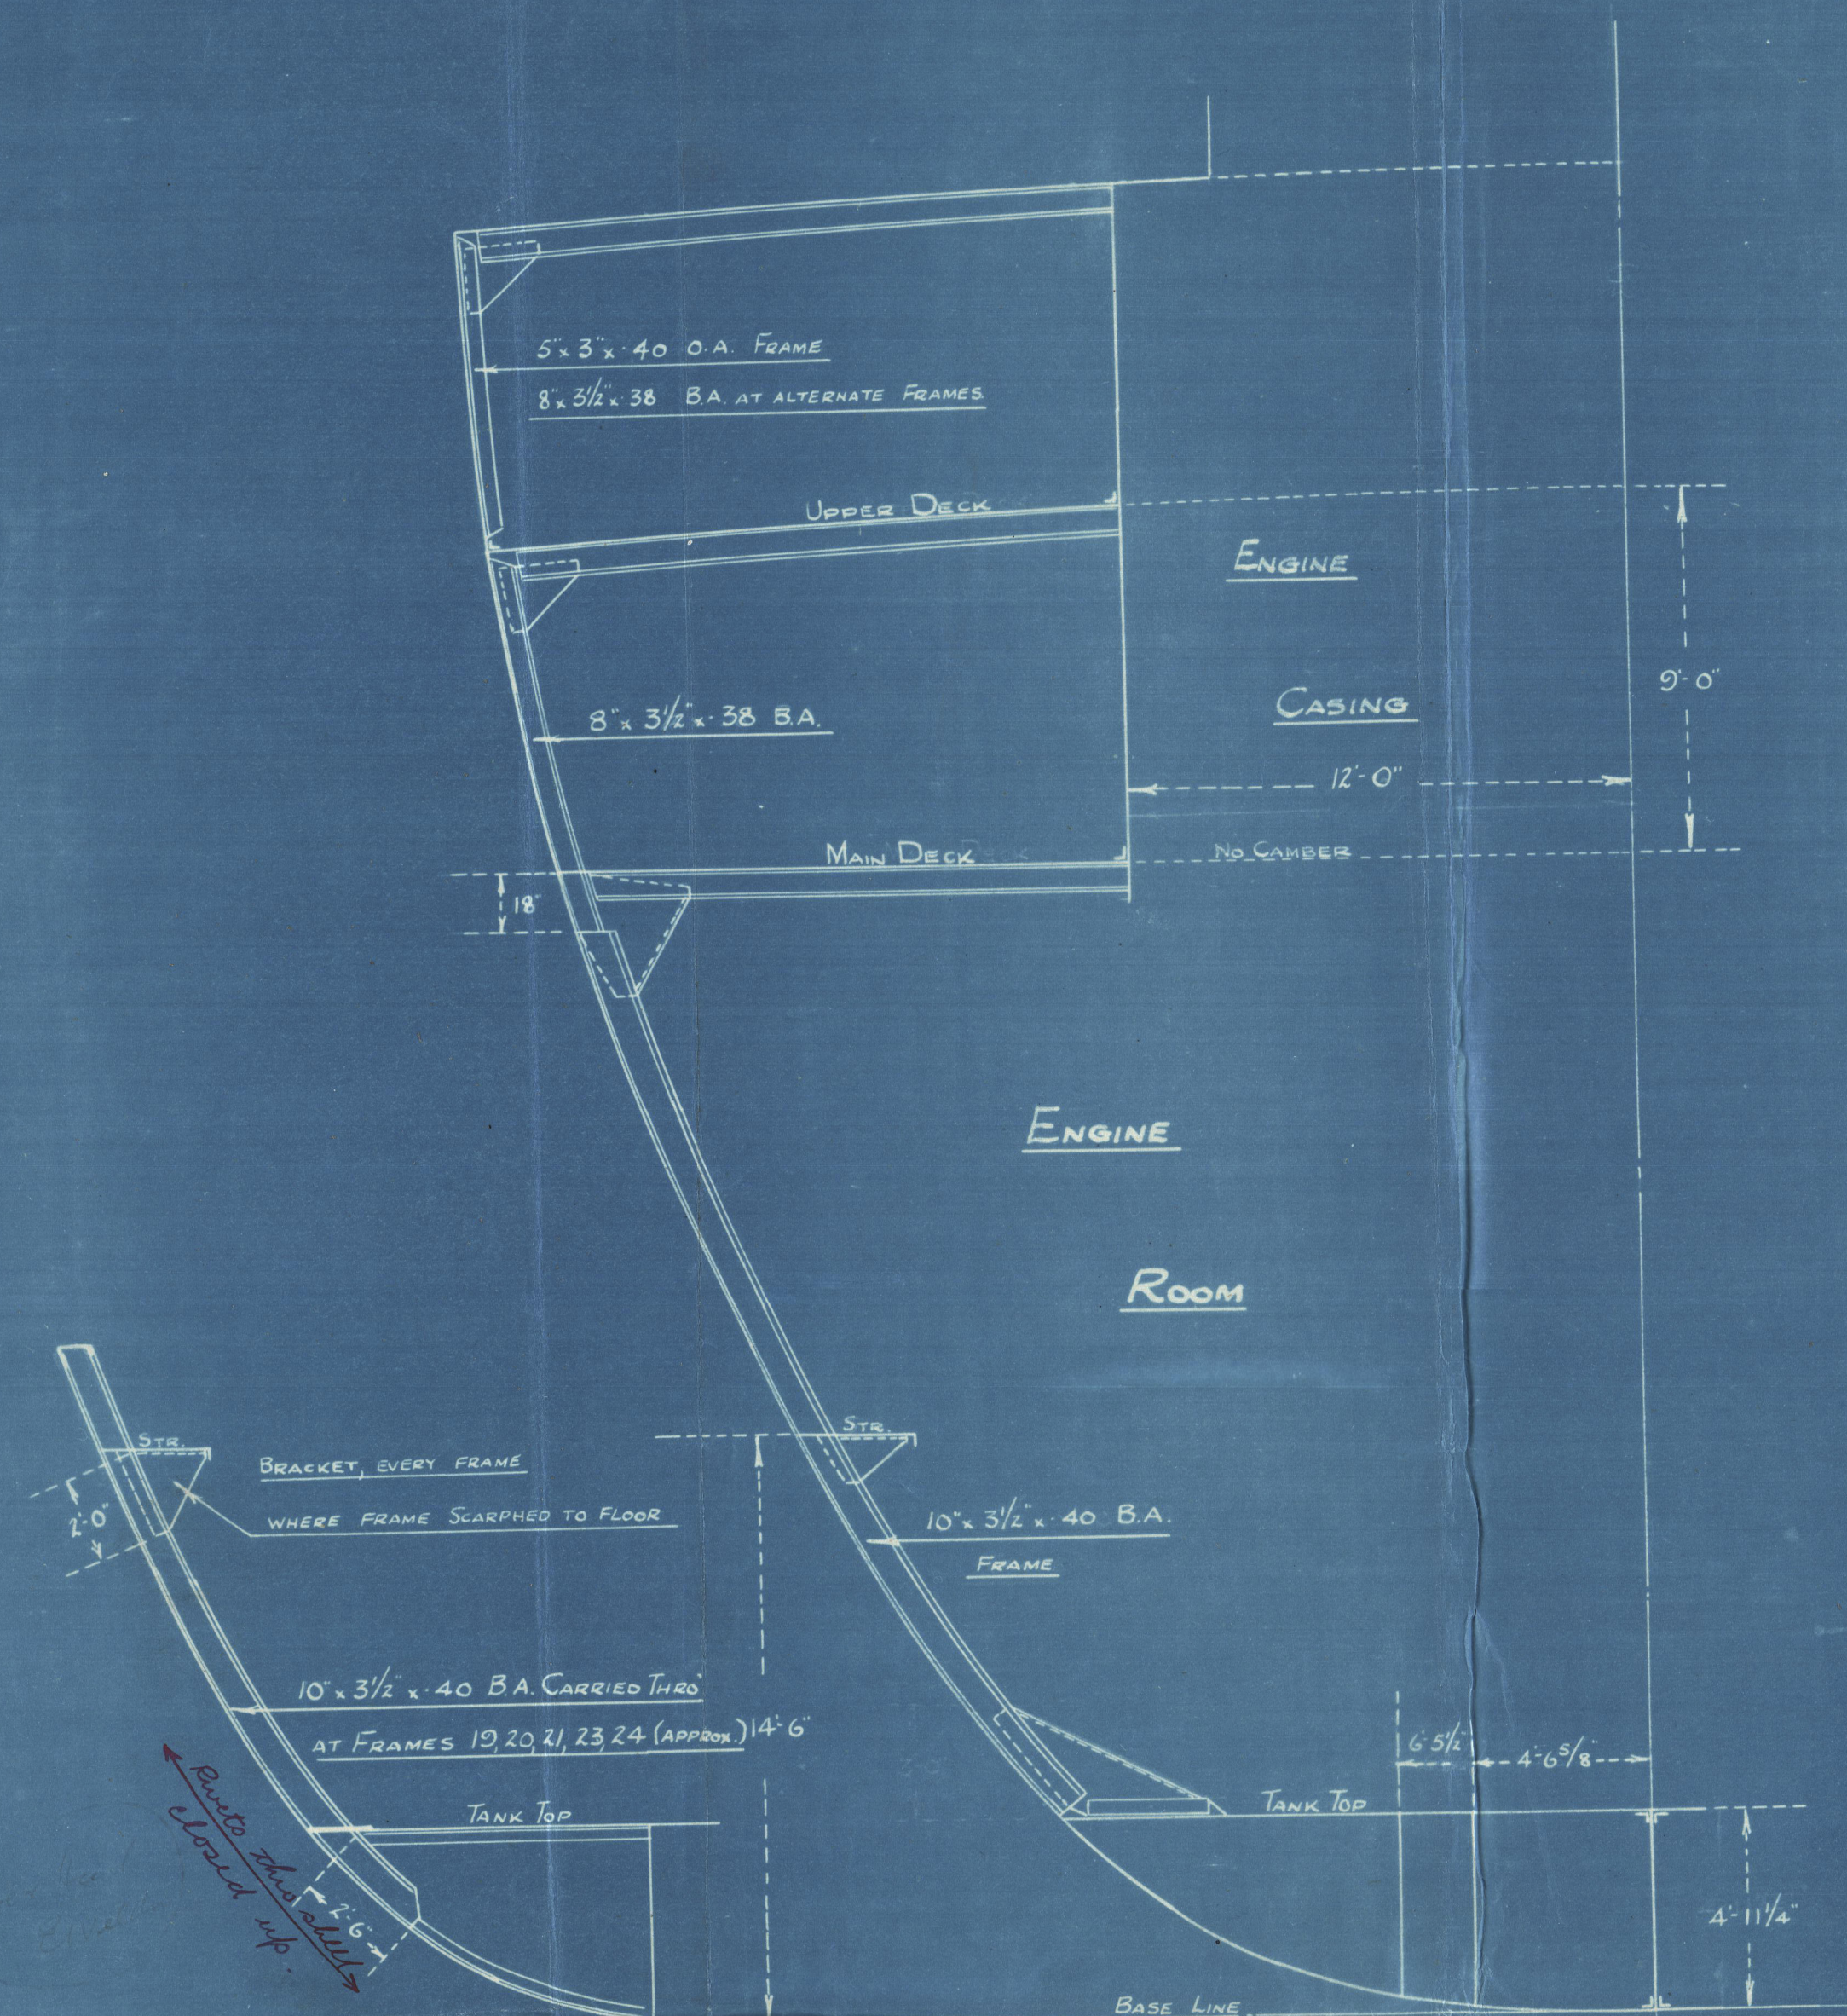


TYPICAL SECTION WHERE FRAMES
SCARPHED TO FLOOR.

SECTION THRU ENGINE ROOM
AT FRAME 20.

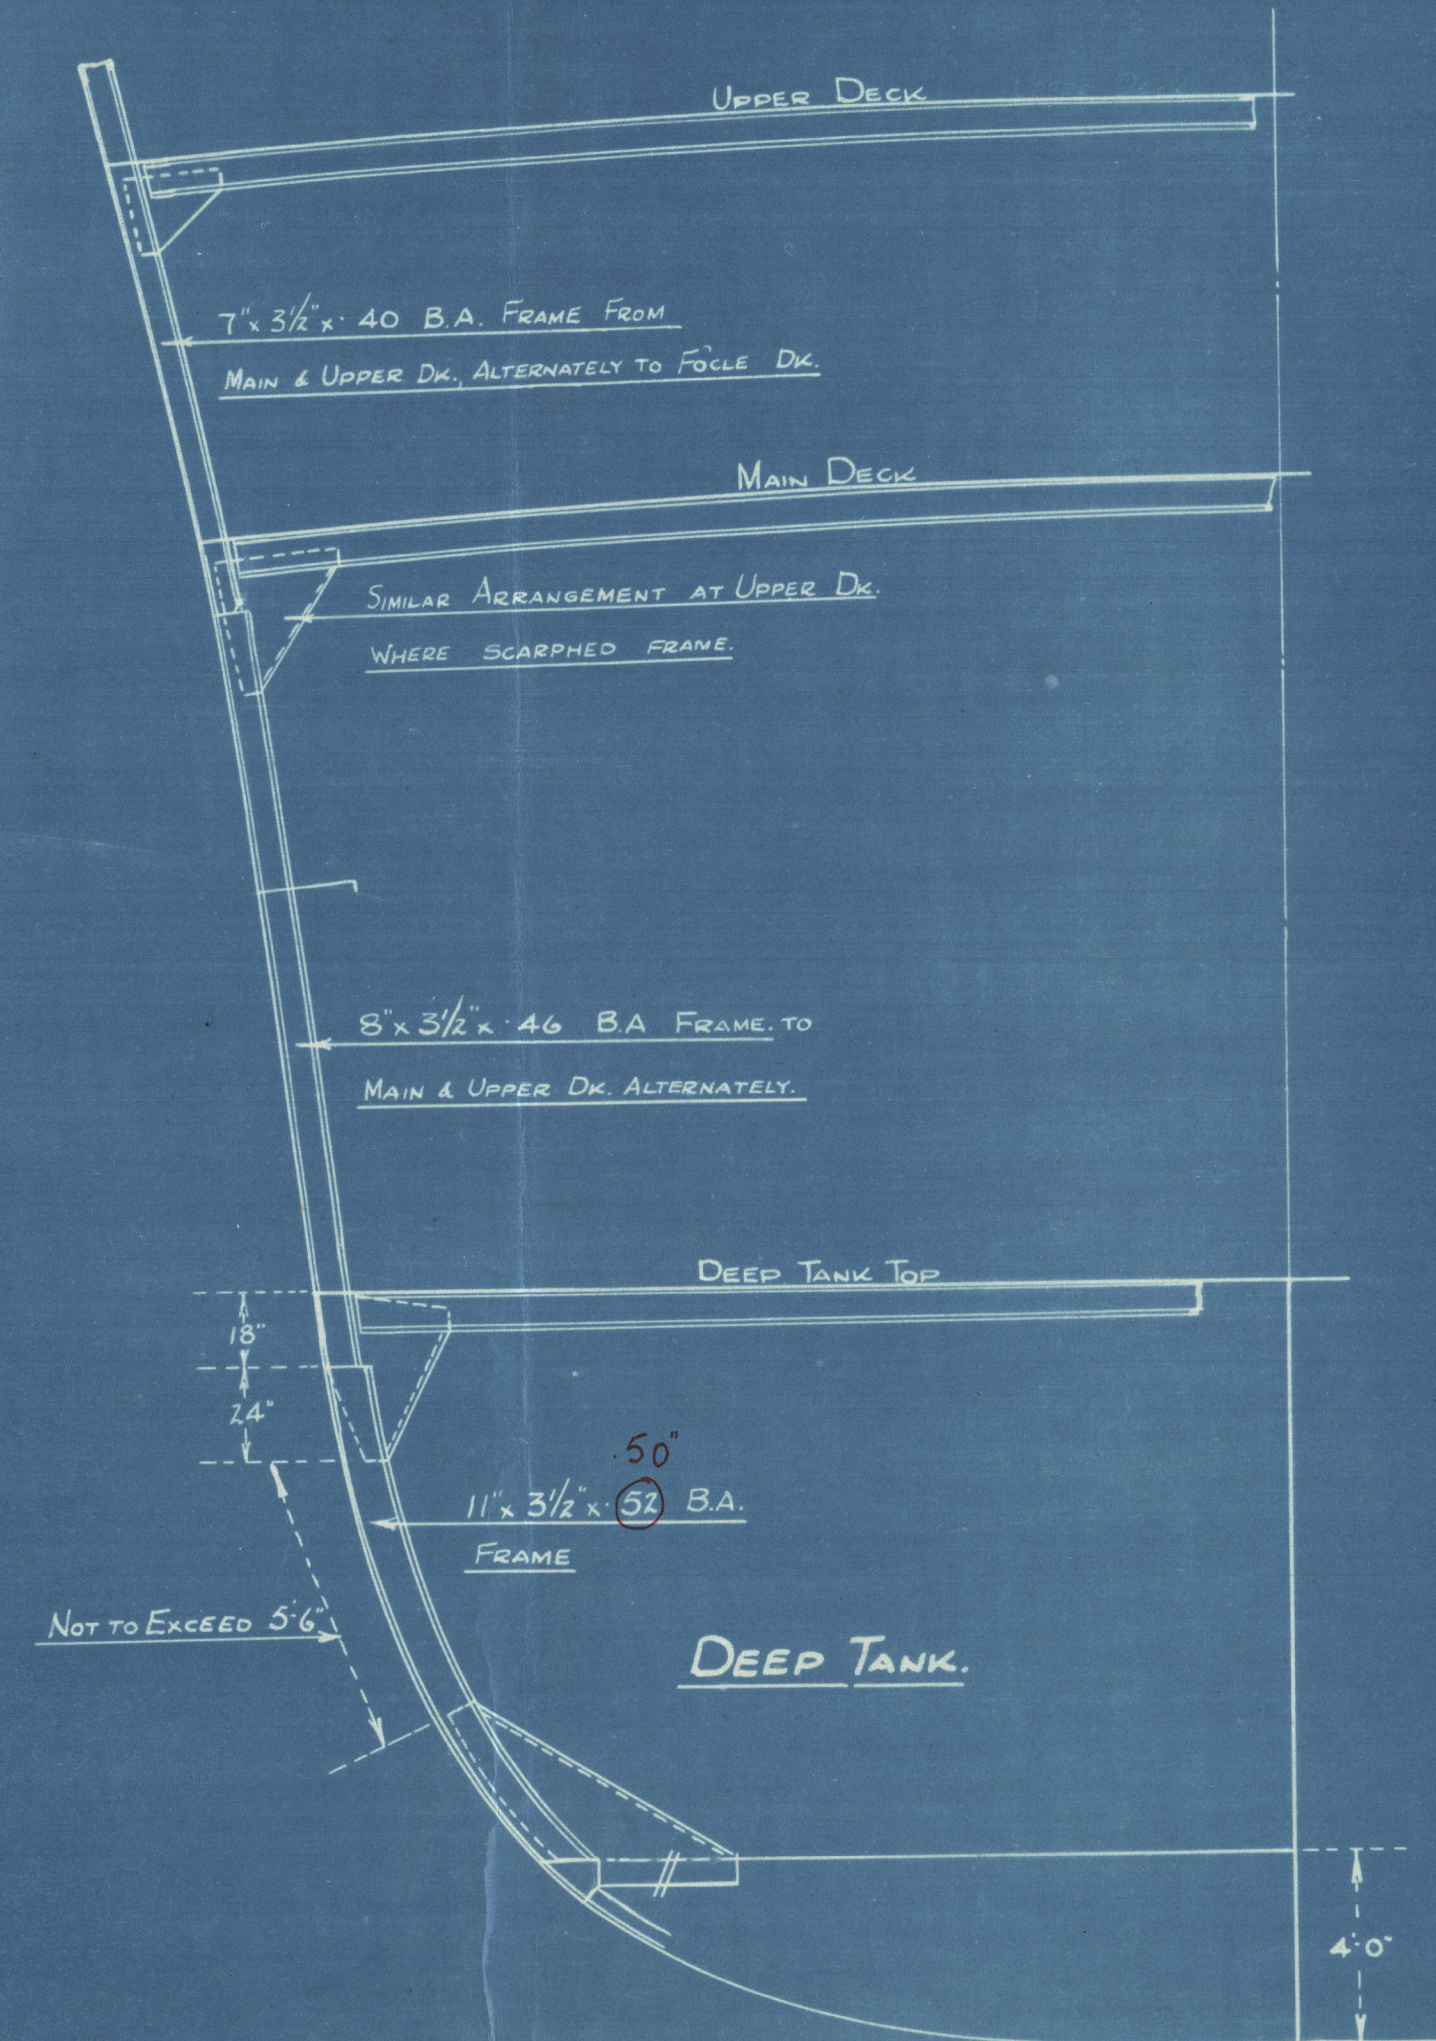

SECTION THRU DEEP TANK.

 

~~24~~

HARLAND & WOLFF'S

N^o 13079.

"FRAMING PROFILE" *

"British Knight"

Ibid.

GLASGOW REPORT No. 70969.

1.

GLASGOW REPORT No.

71094

6

46.5
46.5
93 0

002559-002567-017



© 2020

Lloyd's Register
Foundation