

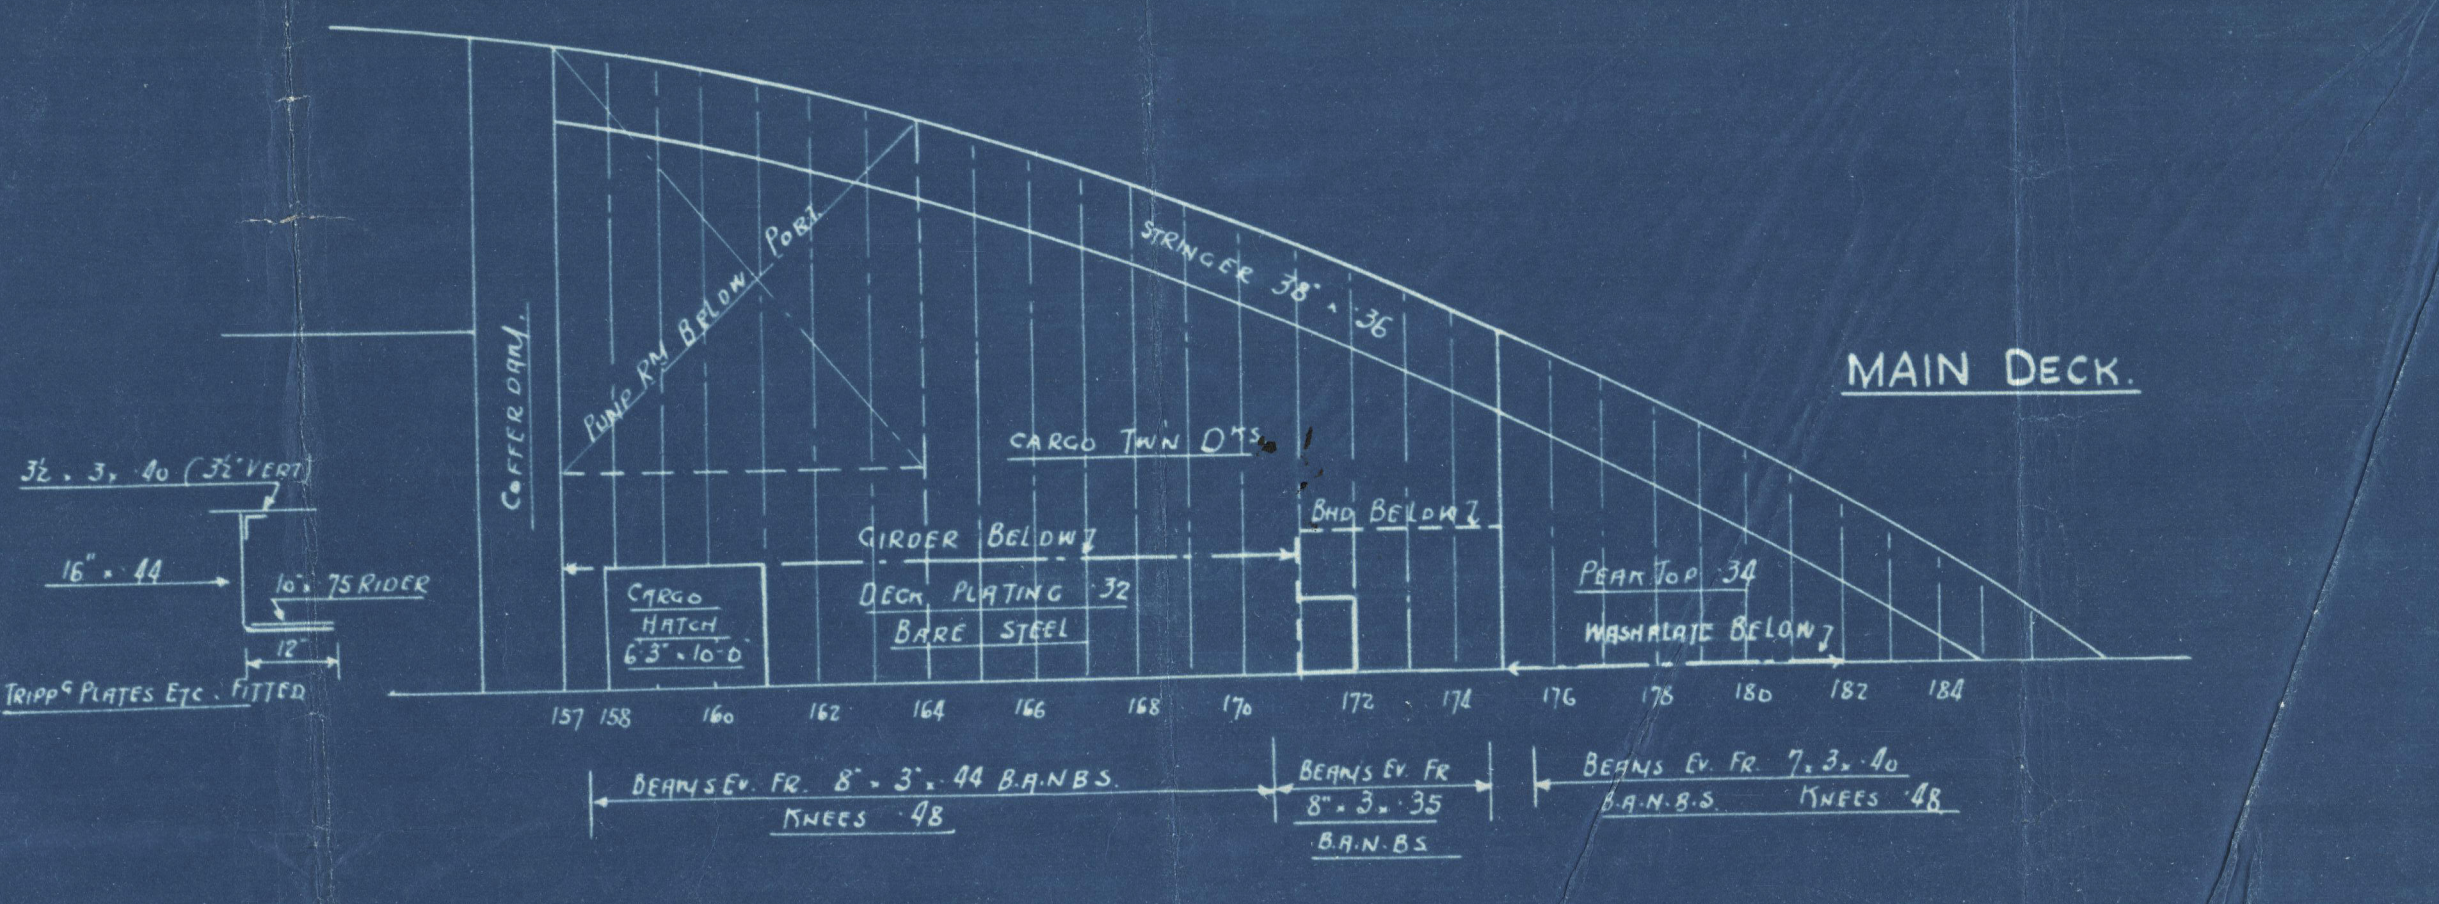
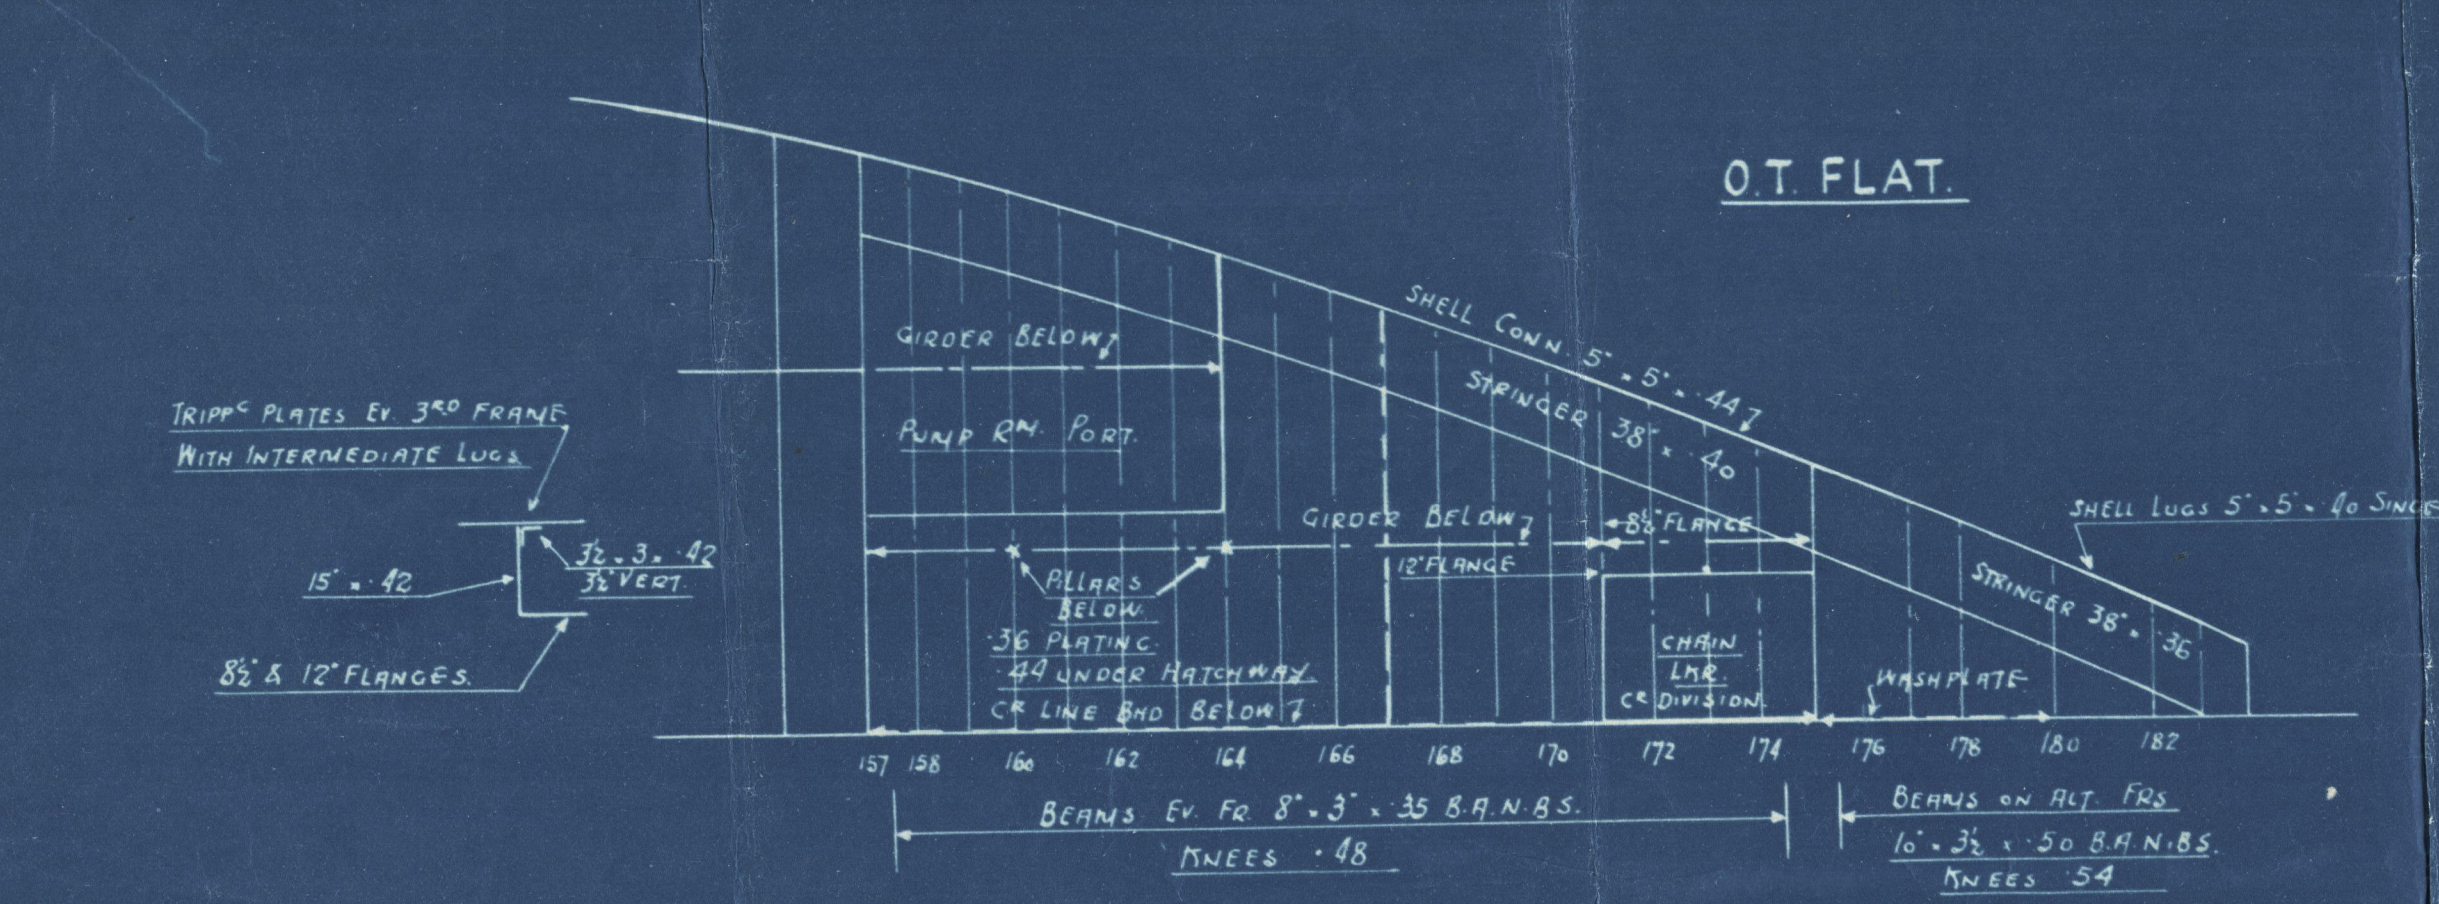
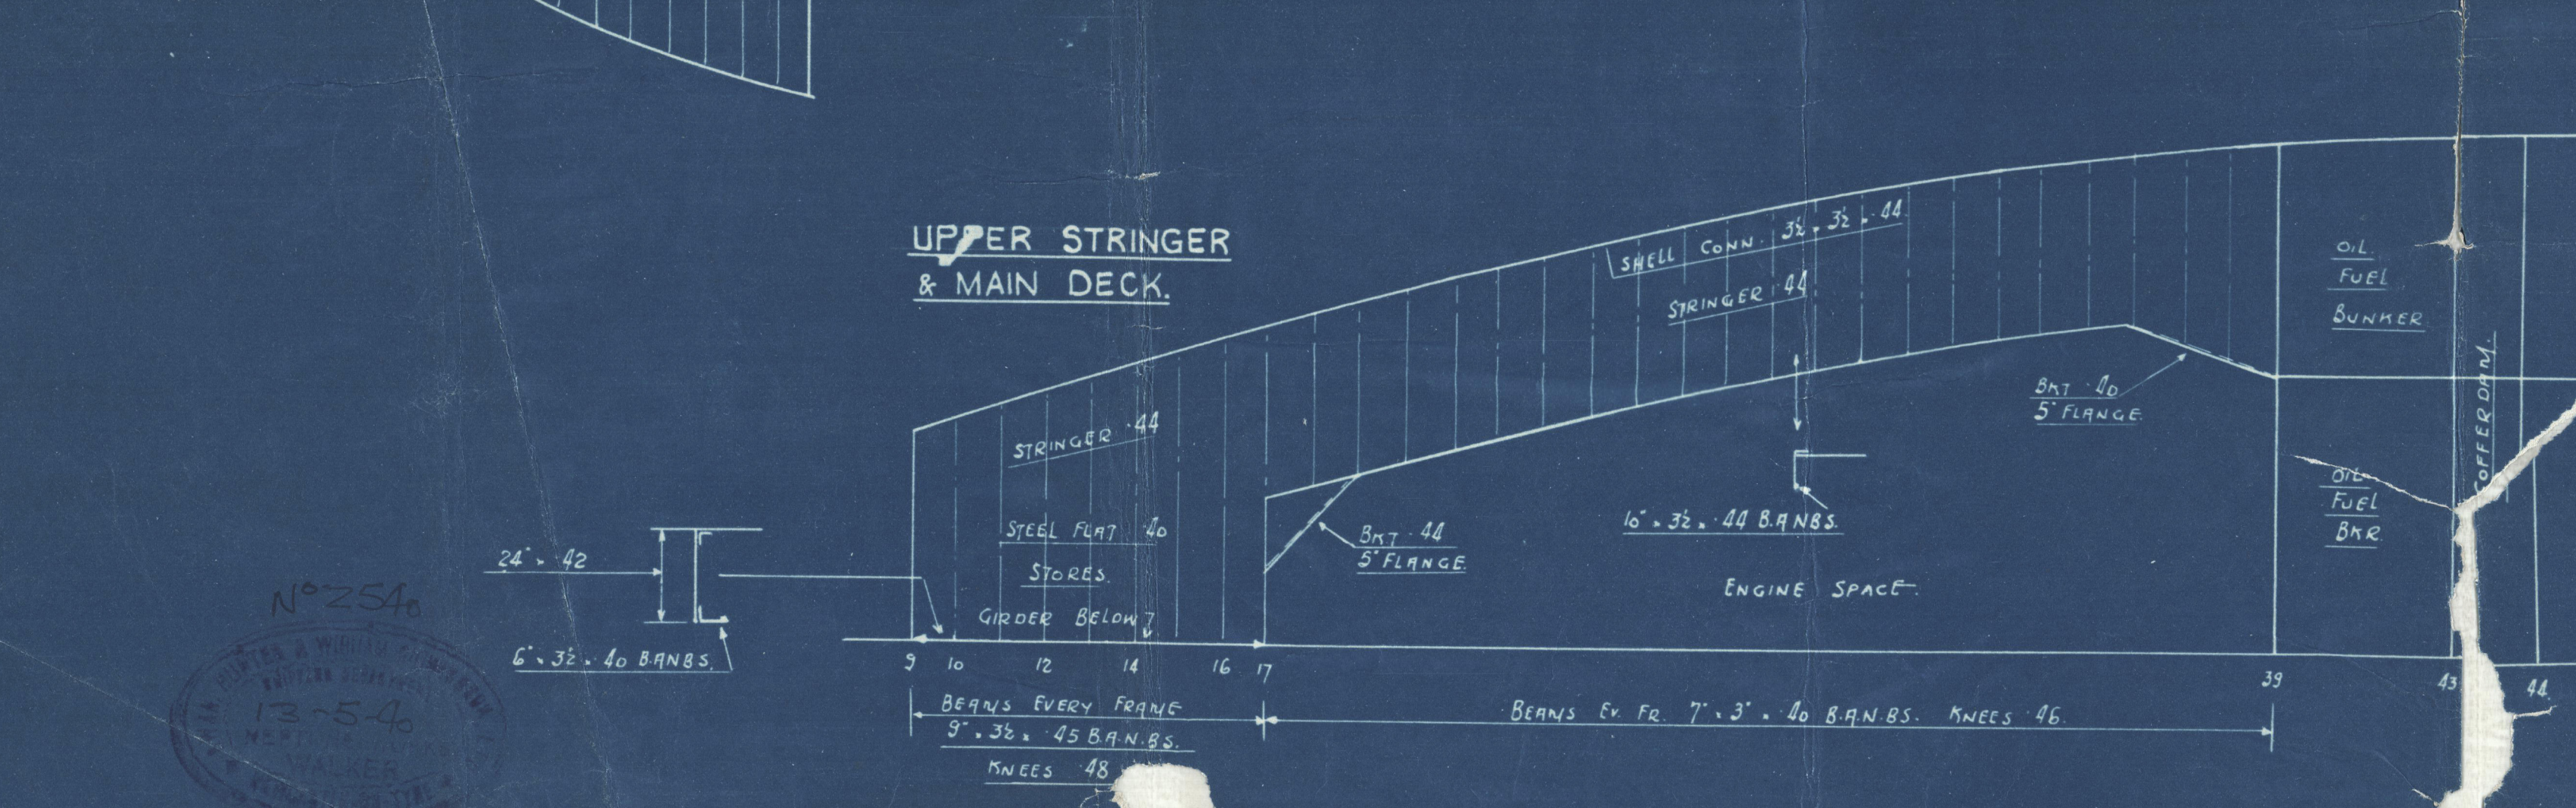
 
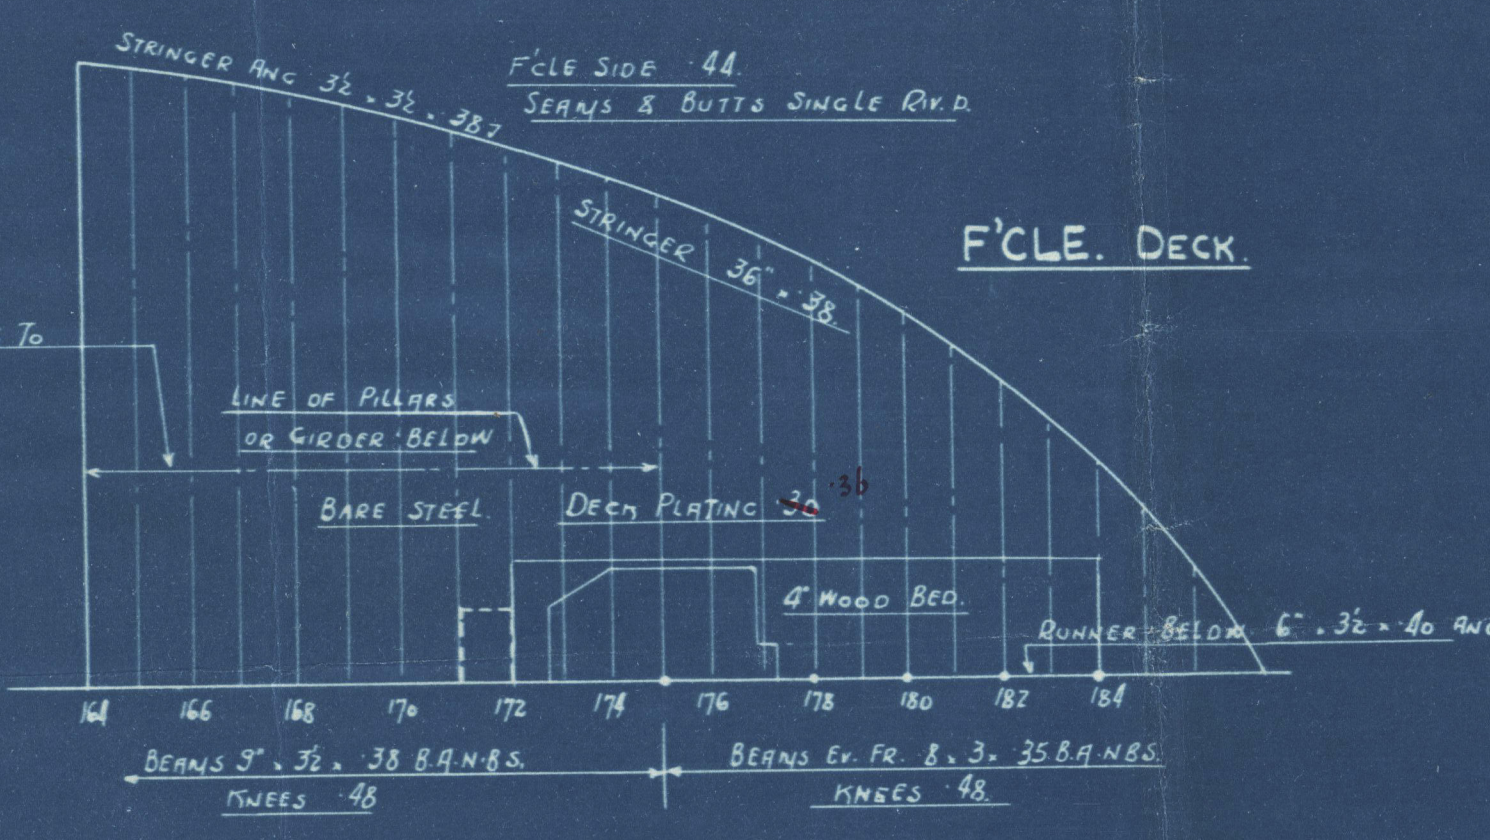
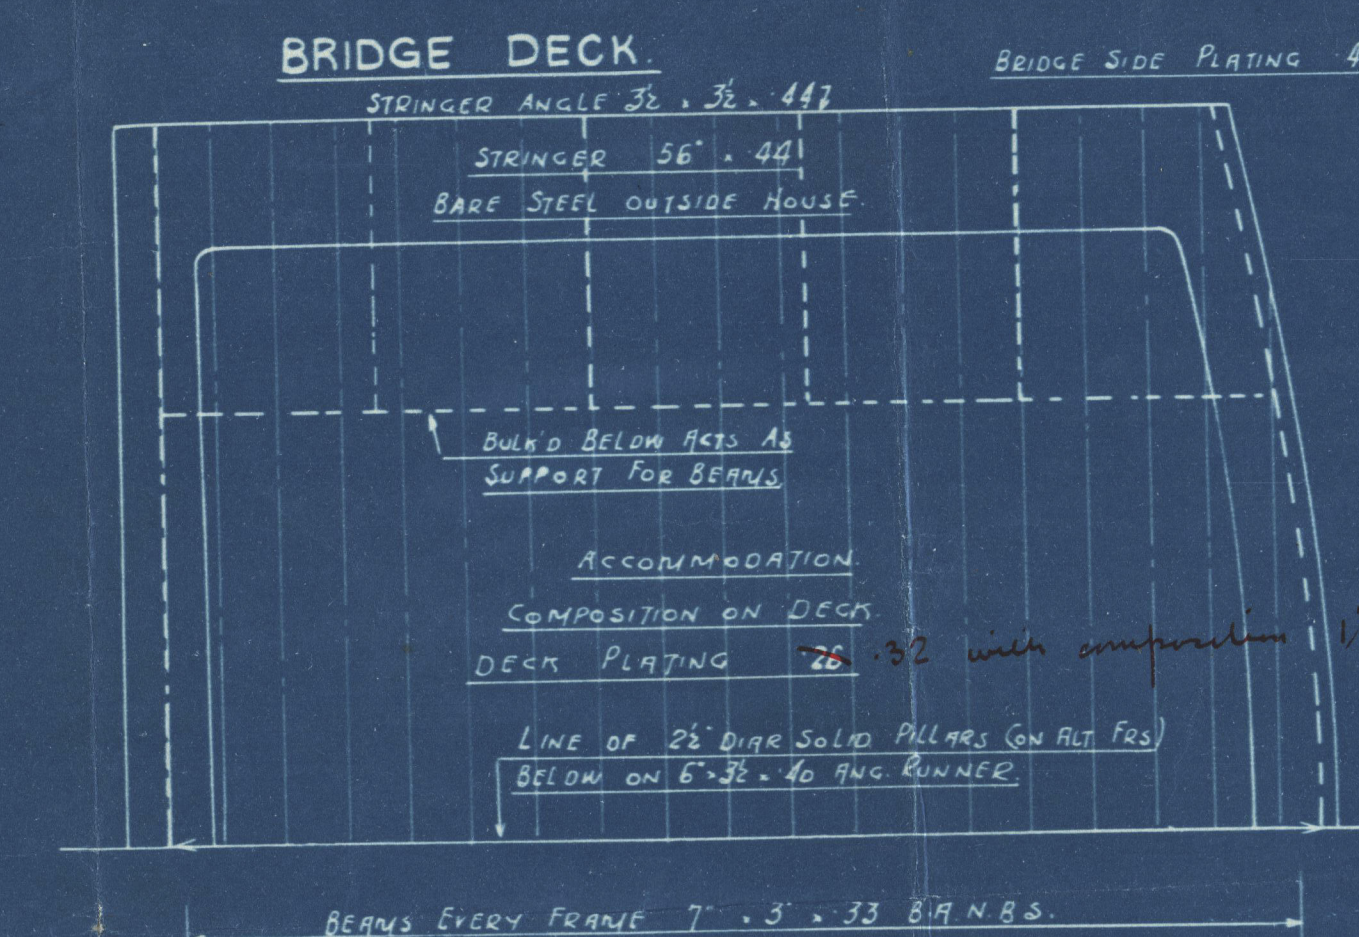


# Nº 1696 & 8. PROFILE & DECK PLANS.

DIMENSIONS 146' 0" P.P. 61' 9" B.M.D. 34' 0" D.M.D. TO UPPER DECK.  
 TO CLASS LLOYDS + 100 AL. CARRYING PETROLEUM IN BULK.  
 "LONGITUDINAL FRAMING AT BOTTOM & AT DECK".  
 SCALE. 1/8"=1'-0".

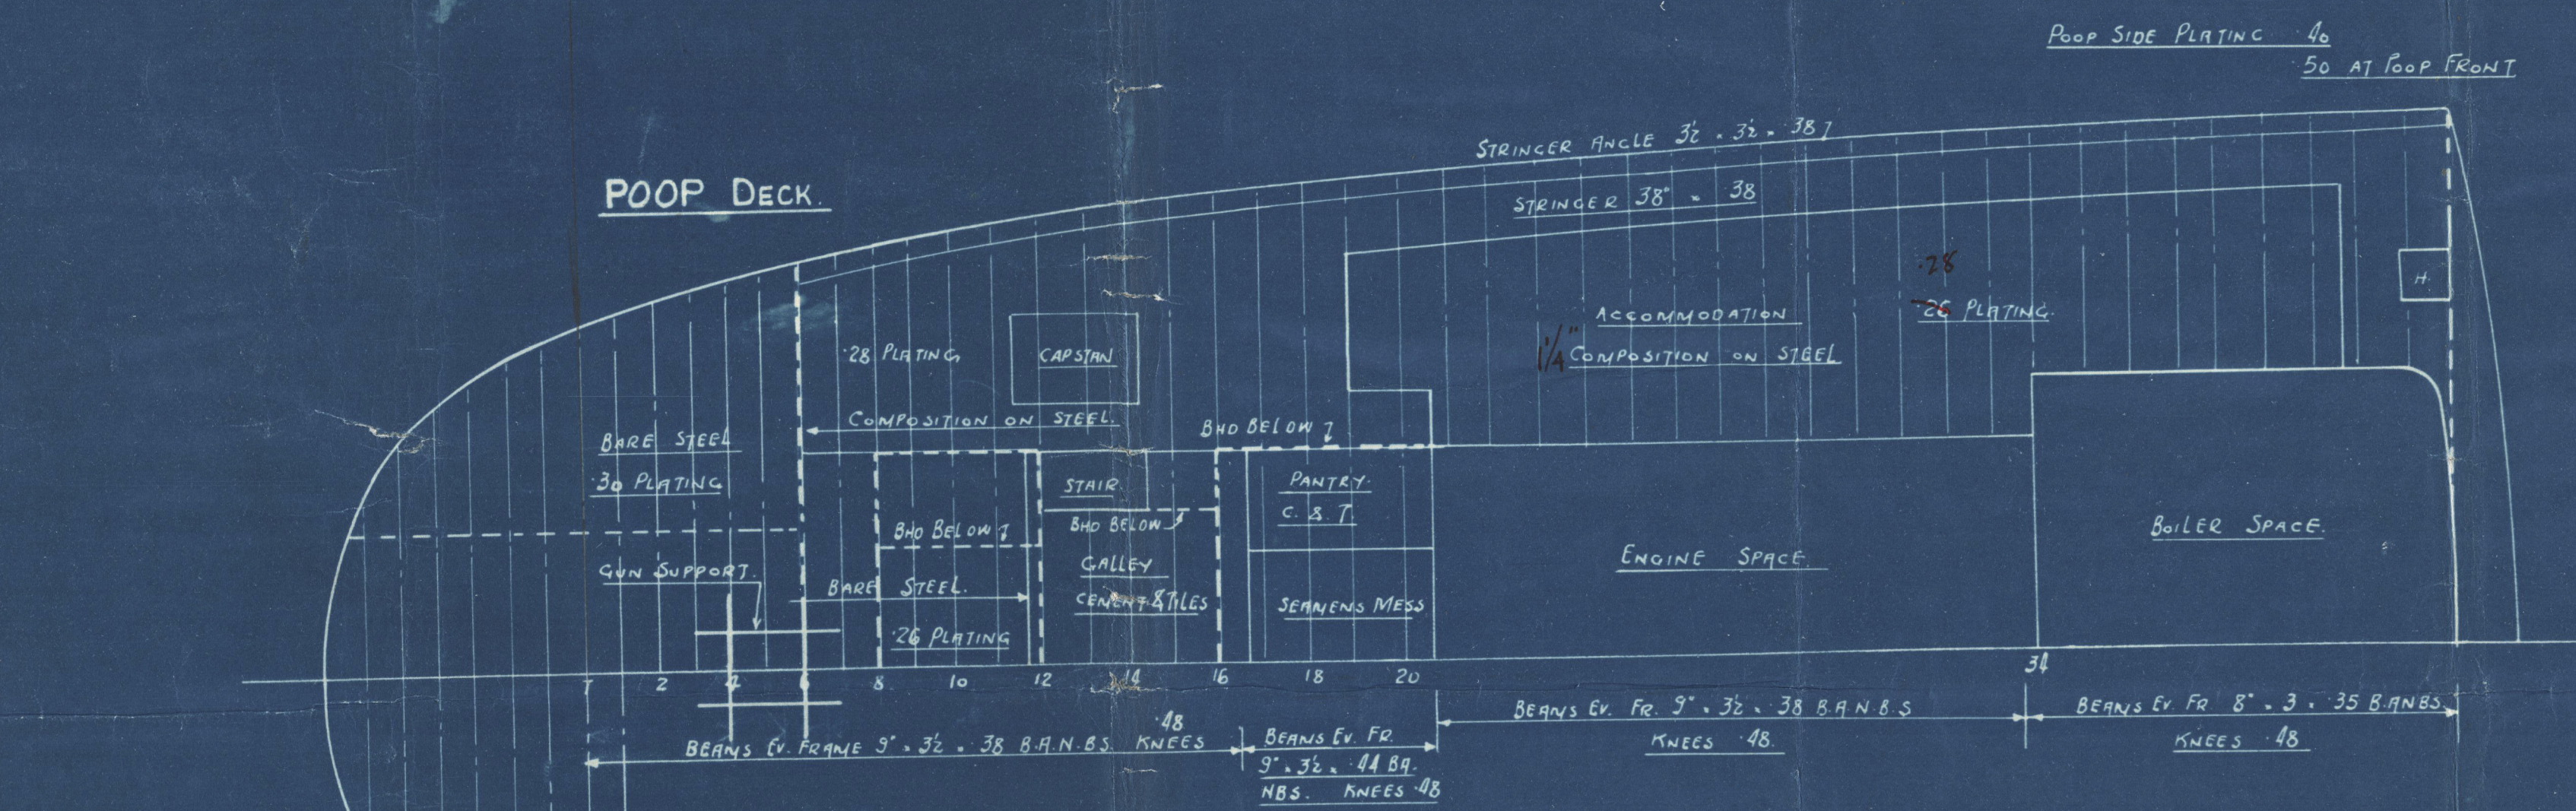

 

2  
S.H & W.R. No 169688

Profile and Decks.

British Harmony.  
NEWCASTLE ON TYNE.

Report No. 99856.

\* BRITISH CHARACTER. \*  
NEWCASTLE ON TYNE.

Report No. 100073.

M/M 2566

W/S. 645

Plot

002559-002567-0132 2020

Lloyd's Register  
Foundation