
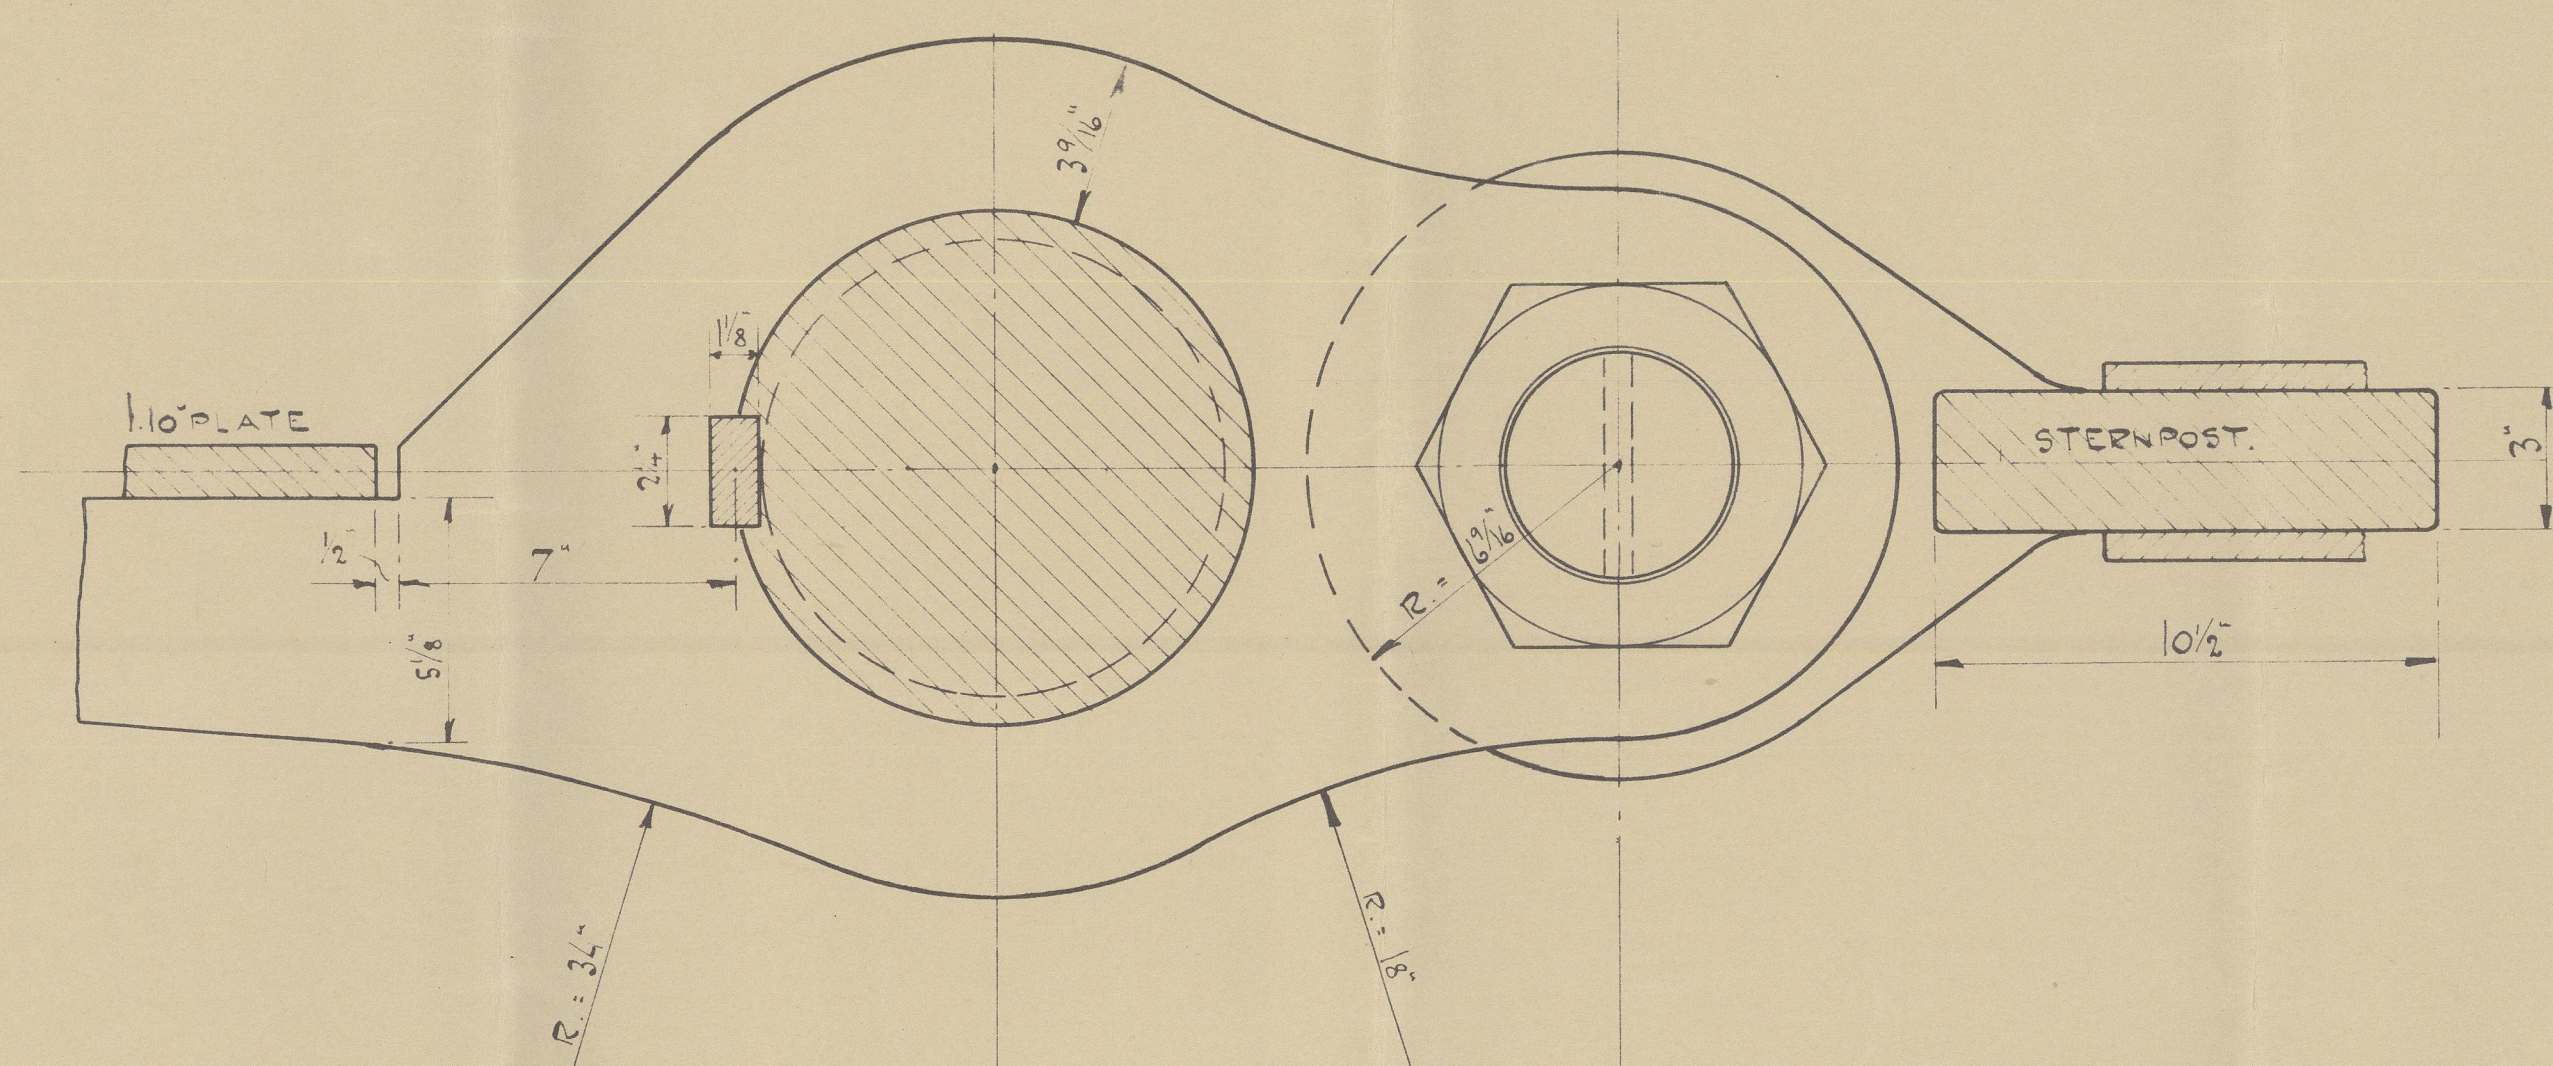


BUILDING N° 36 STERNFRAME AND RUDDER


SCALE: $\frac{3}{4}" = 3" = 1'-0"$

RUDDER STOCK INCREASED 4 INCH ABOVE RIGGS

SKETCH OF N°1, N°3 AND N°4 GUDGEON
SCALE: $\frac{3}{4}" = 3" = 1'-0"$

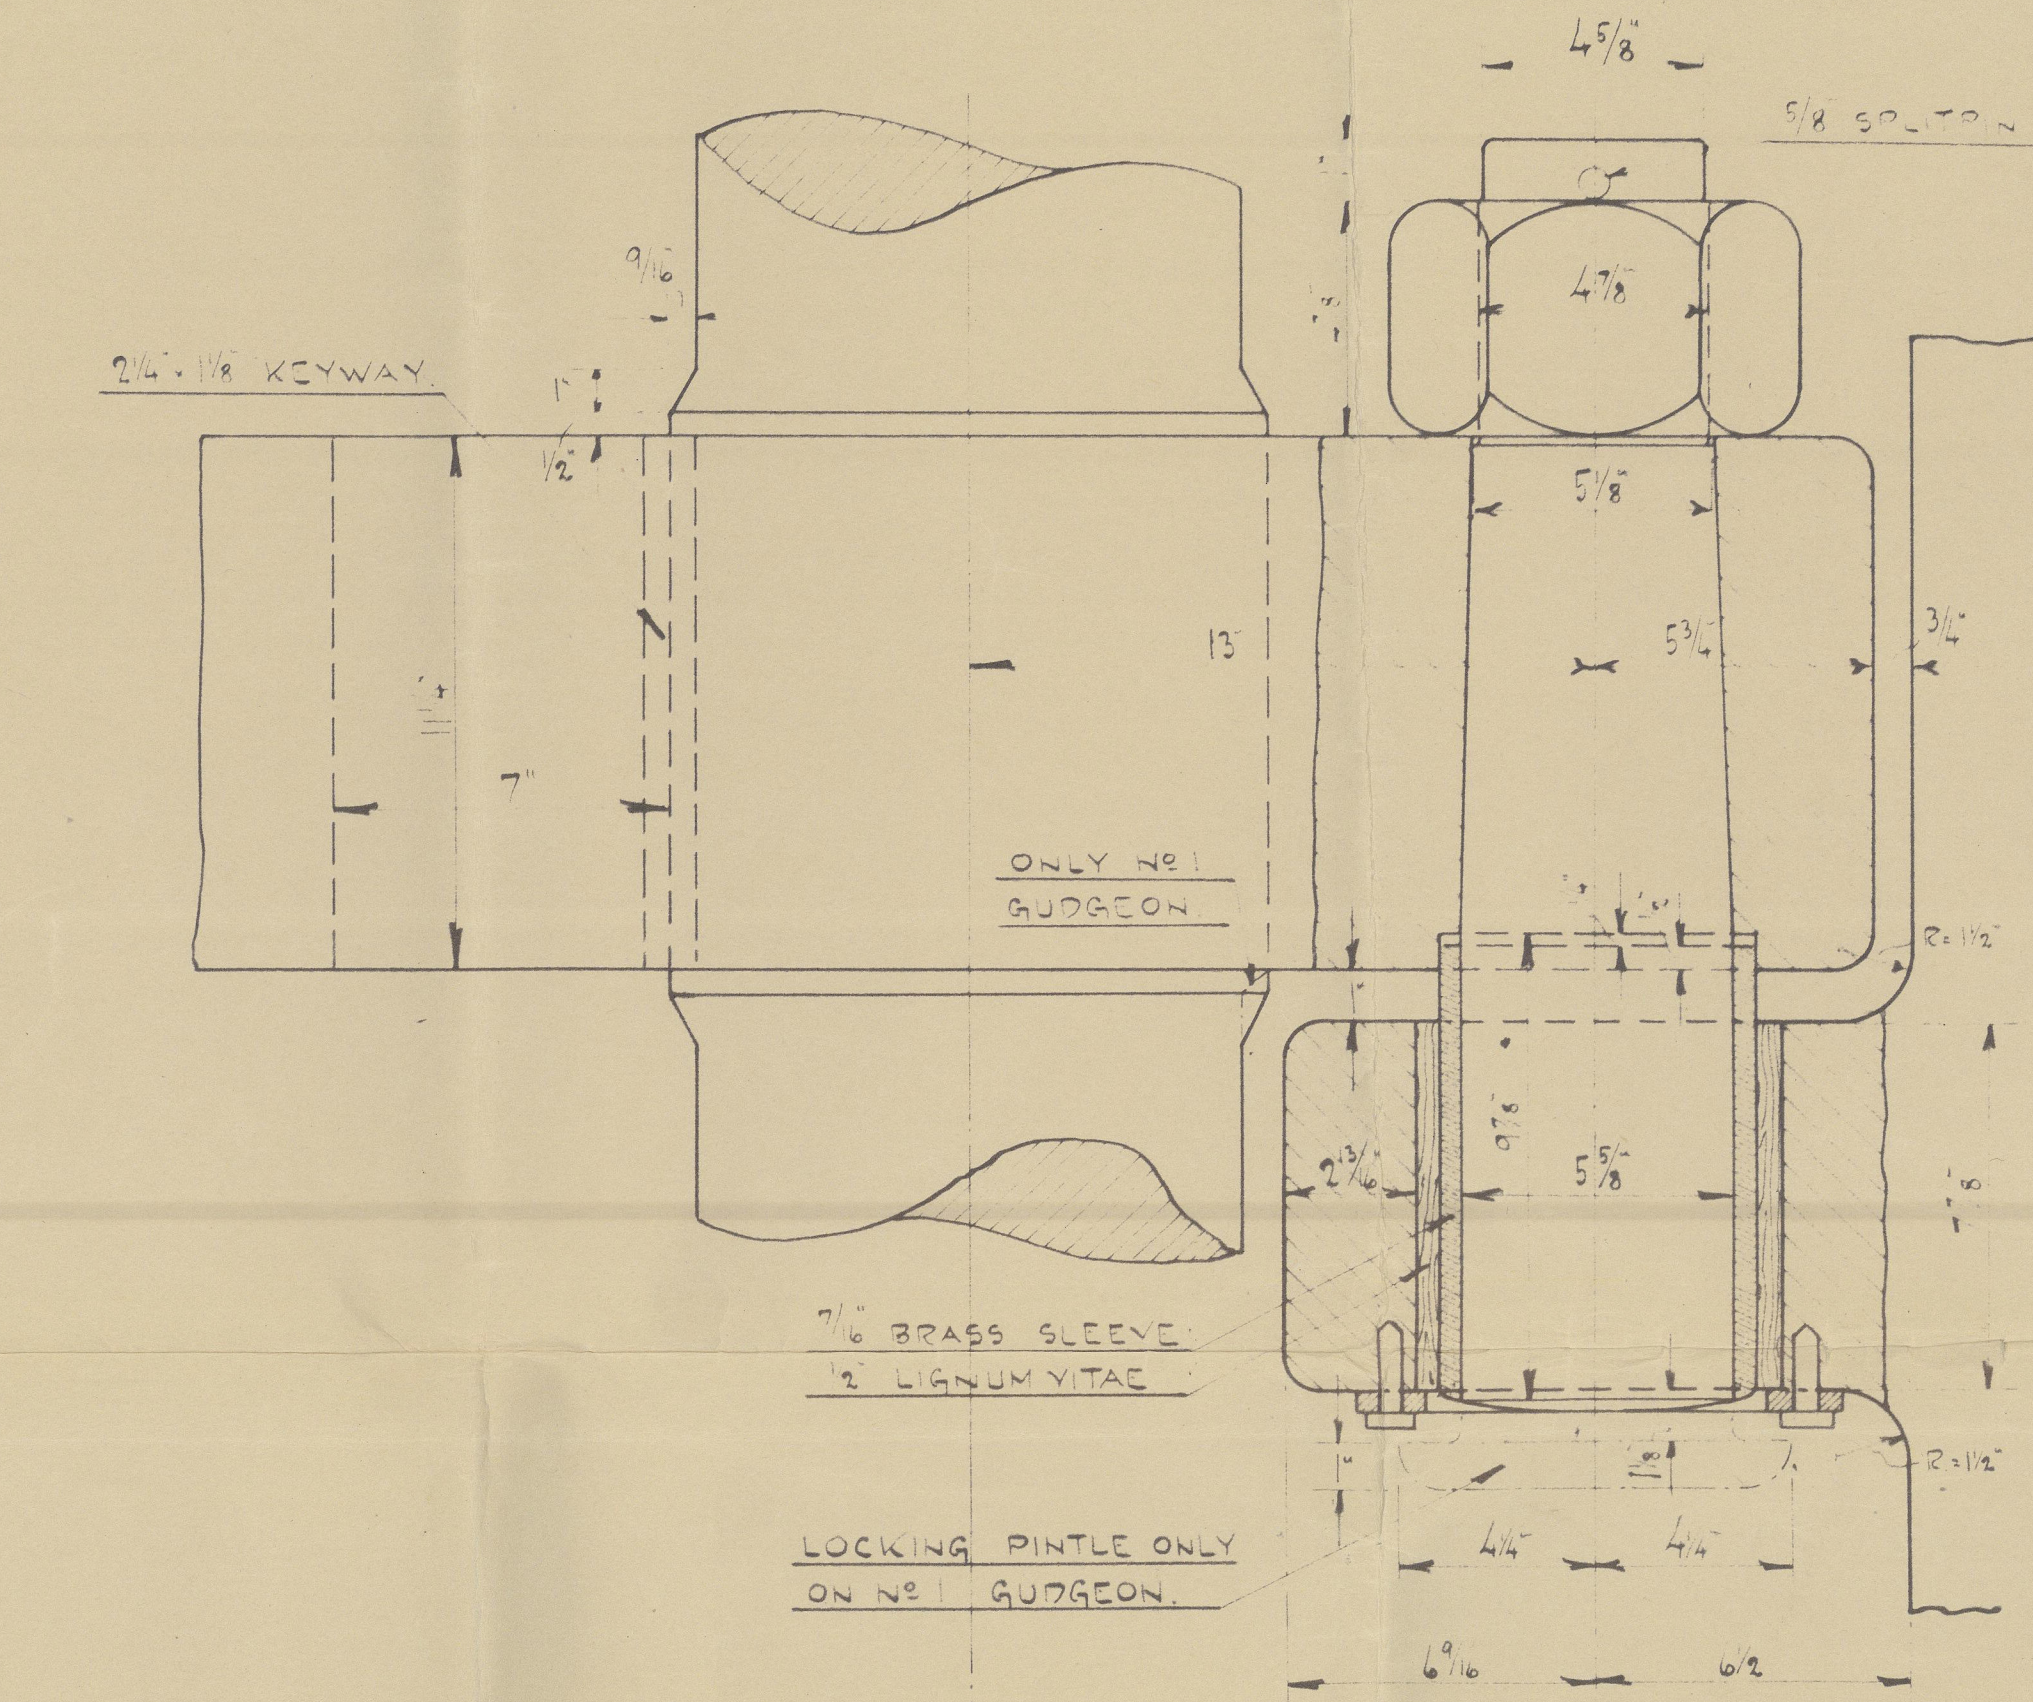

SKETCH OF N°2 AND N°5 GUDGEON
SCALE: $\frac{3}{4}" = 3" = 1'-0"$

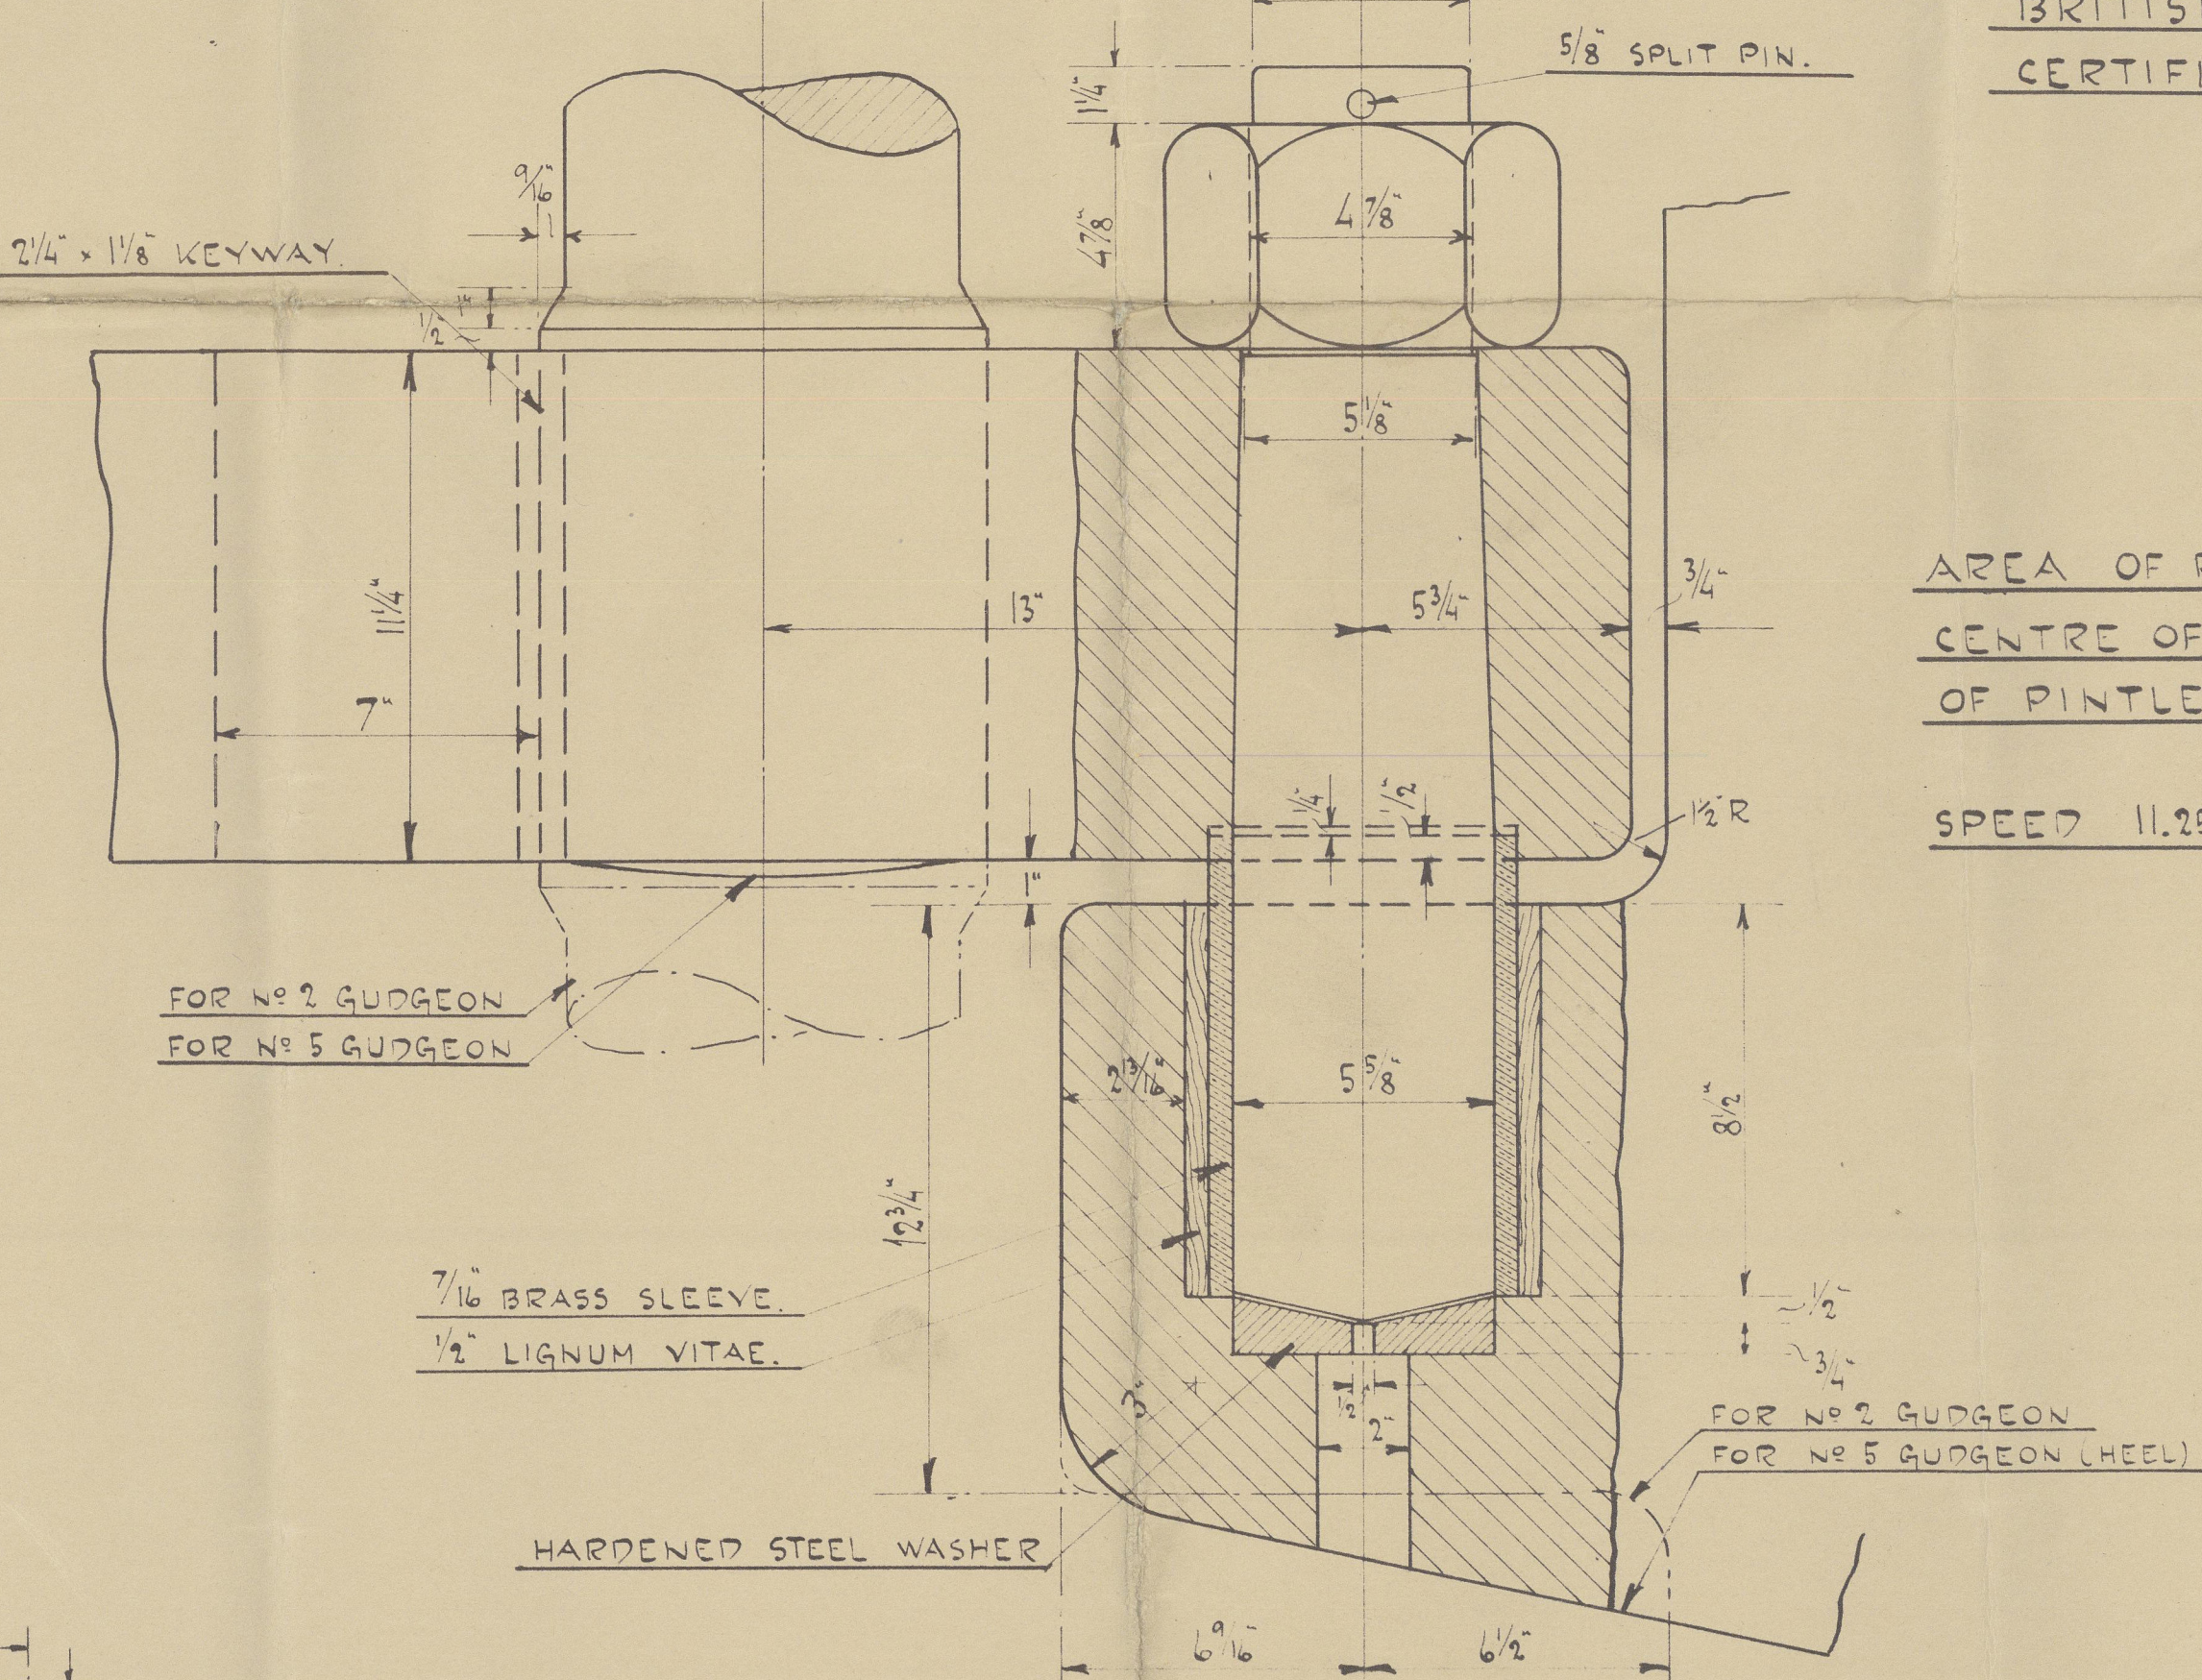

MATERIAL
STERNFRAME OF CAST STEEL
RUDDER STOCK OF FORGED STEEL
RUDDER ARMS OF FORGED STEEL
SHRUNK ON THE MAINPIECE
BRITISH LLOYD'S TEST
CERTIFICATE TO BE DELIVERED

AREA OF RUDDER 151.5 SQUARE FEET
CENTRE OF GRAVITY FROM E
OF PINTLES 3.07 FEET

SPEED 11.25 KNOTS

Y.S. 29

17-4-29



STERNFRAME

X

RUDDER

No 36

ODENSE STAALSKIBSYAERFT.

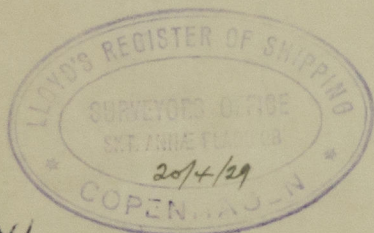

NIN ALFHEM T:

ER

m/s. Guldberg

Gpm. Kpt. No. 8195.

FEET

36

0

3"=1'-0"

eye.

Y-

-29

ME &

002568-002576-0003



© 2020

Lloyd's Register
Foundation