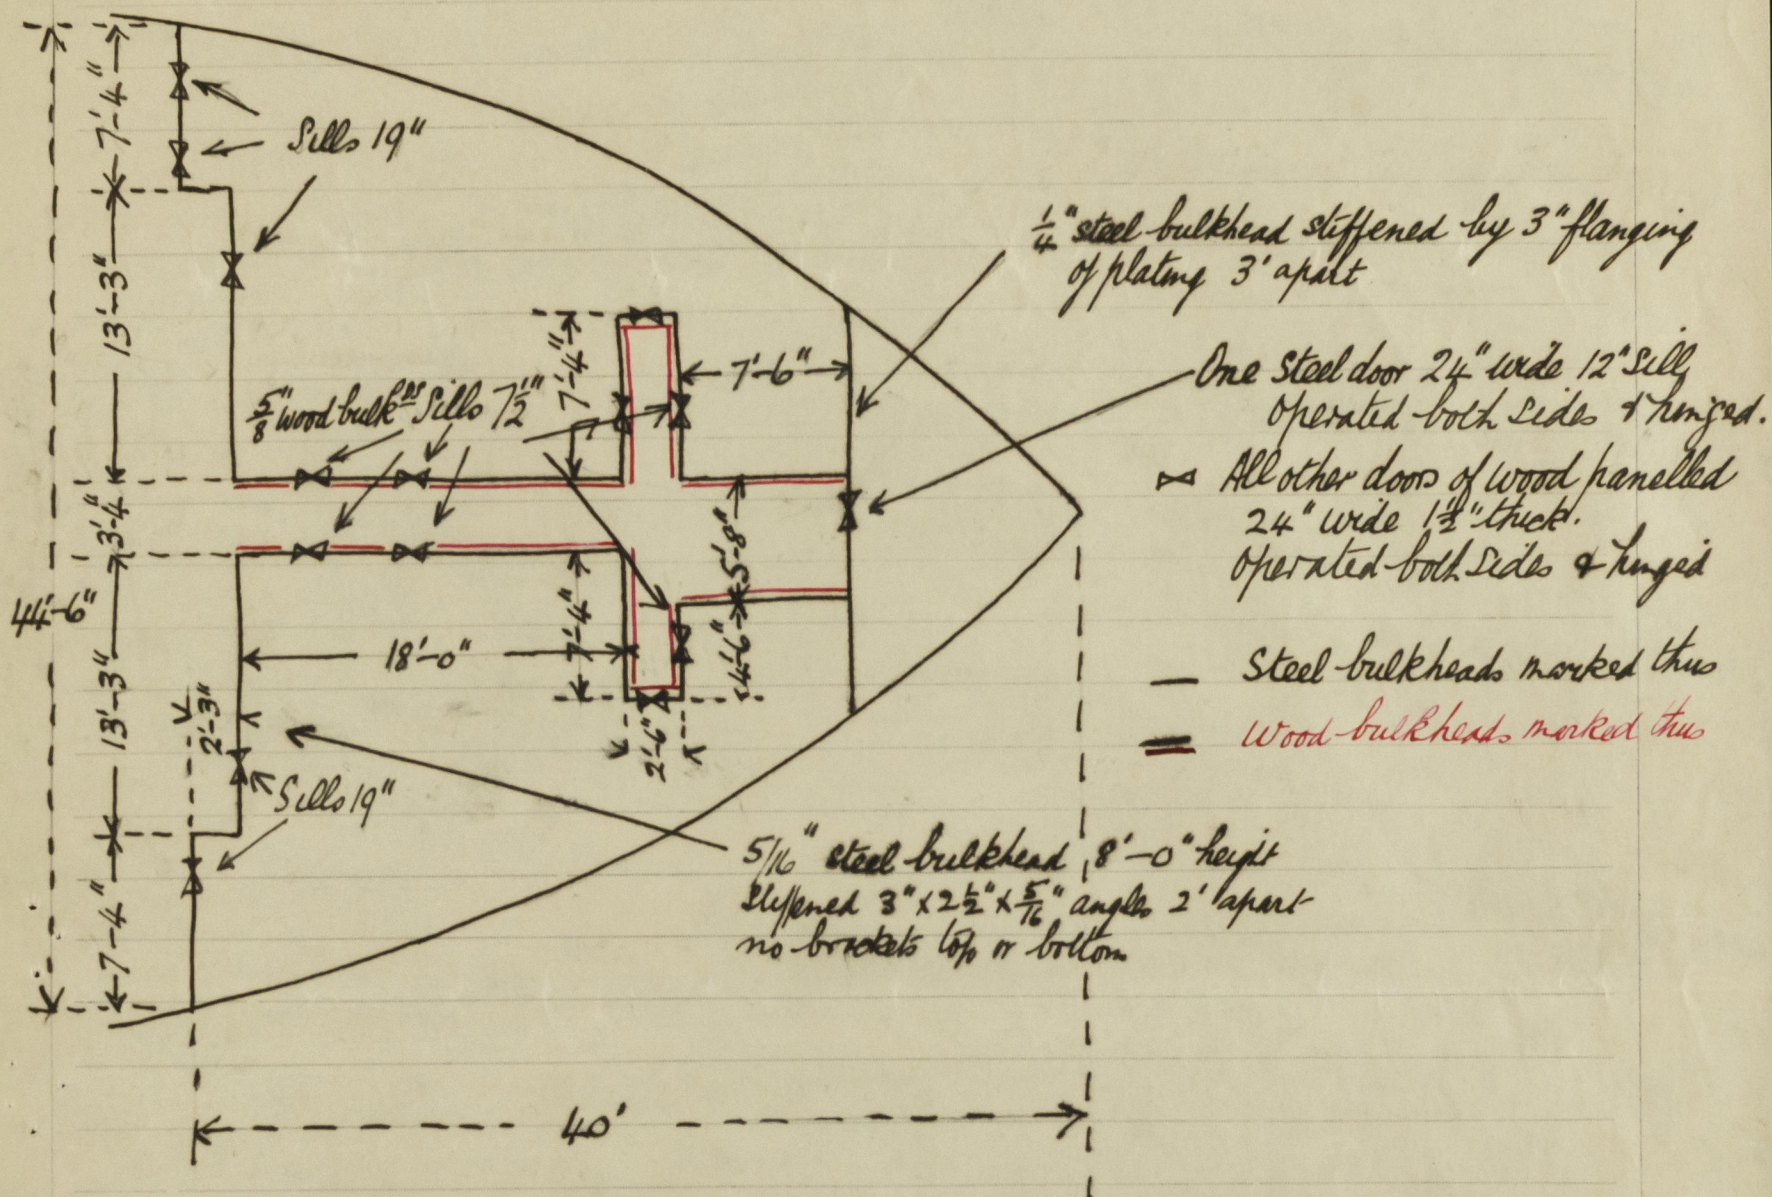


Lloyd's Register of Shipping.

Ship's Name

Silverlarch

Official No. 147710

~~Memorandum of alterations reported since ship was surveyed for assignment of Load Lines~~~~in~~

SKETCH OF FORECASTLE SUPERSTRUCTURE BULKHEADS ON
SHELTER DECK.

Clue Ball