

R.Q.D. COASTERS Nos 390 + 391.

LONGITUDINAL SECTION + DECK PLAN.

LENGTH B.P. 165'-0", BREADTH M.L.D. 26'-6", DEPTH M.L.D. UPPER DK. 12'-6"  
QUARTER DK. 16'-3"

SCALE 1/4" = 1 FOOT.

See Profile & Deck Plan as built


Amended for Russian letter 24/4/24

LLOYD'S NUMERALS.

|                  | UPPER DK. | QUARTER DK. |
|------------------|-----------|-------------|
| TRANSVERSE NO.   | 32-35     | 39-0        |
| LONGITUDINAL NO. | 63-74     | 64-35       |
| L/D.             | 13-2      | 10-15       |
| "d."             | 11-33     | 10-83       |

Pillaring under window, bracing, mast  
to be survey no satisfaction

First two  
then later  
Pillaring to survey no satisfaction

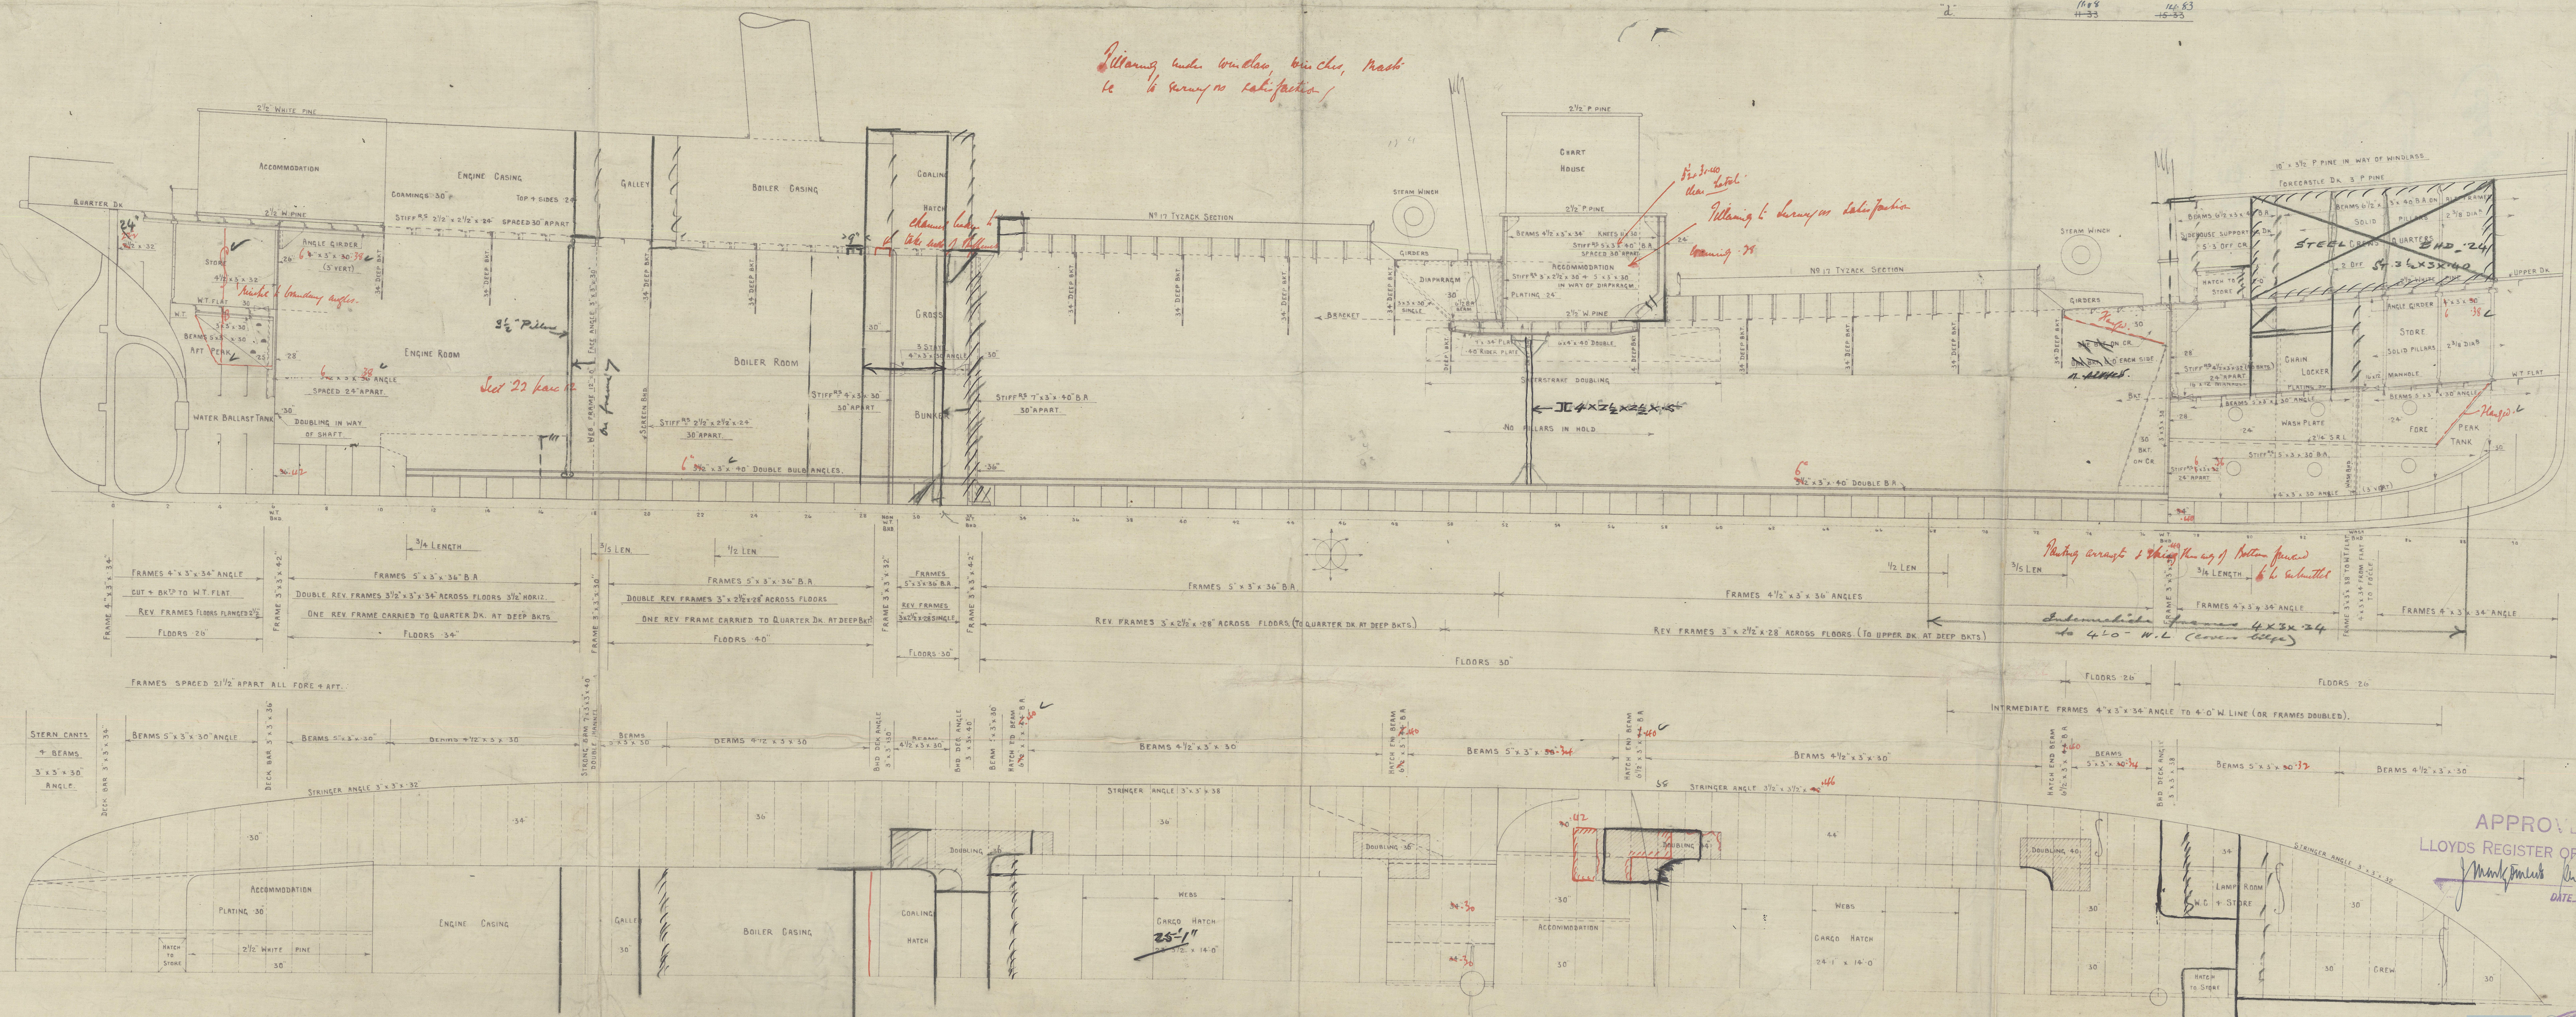

APPROVED  
LLOYD'S REGISTER OF SHIPPING  
M. J. Jones  
DATE 30-4-24



002568-002576-0088



Mr. hak

Ailsa Cor

GP-39081

Profiled Decks

(See plan as built)

390 Beryl

Gls Rpt No 44173

391 <sup>7</sup> Turquoise

Gls Rpt 44173  
© 2020  
Lloyd's Register  
Foundation

002568-002576-0088