


CLASS \times 100 A₁ ENG. LLOYD'S

— 456'-8" x 63'-0" x 38'-8" —

SCALE 1/16" = 1'-0"

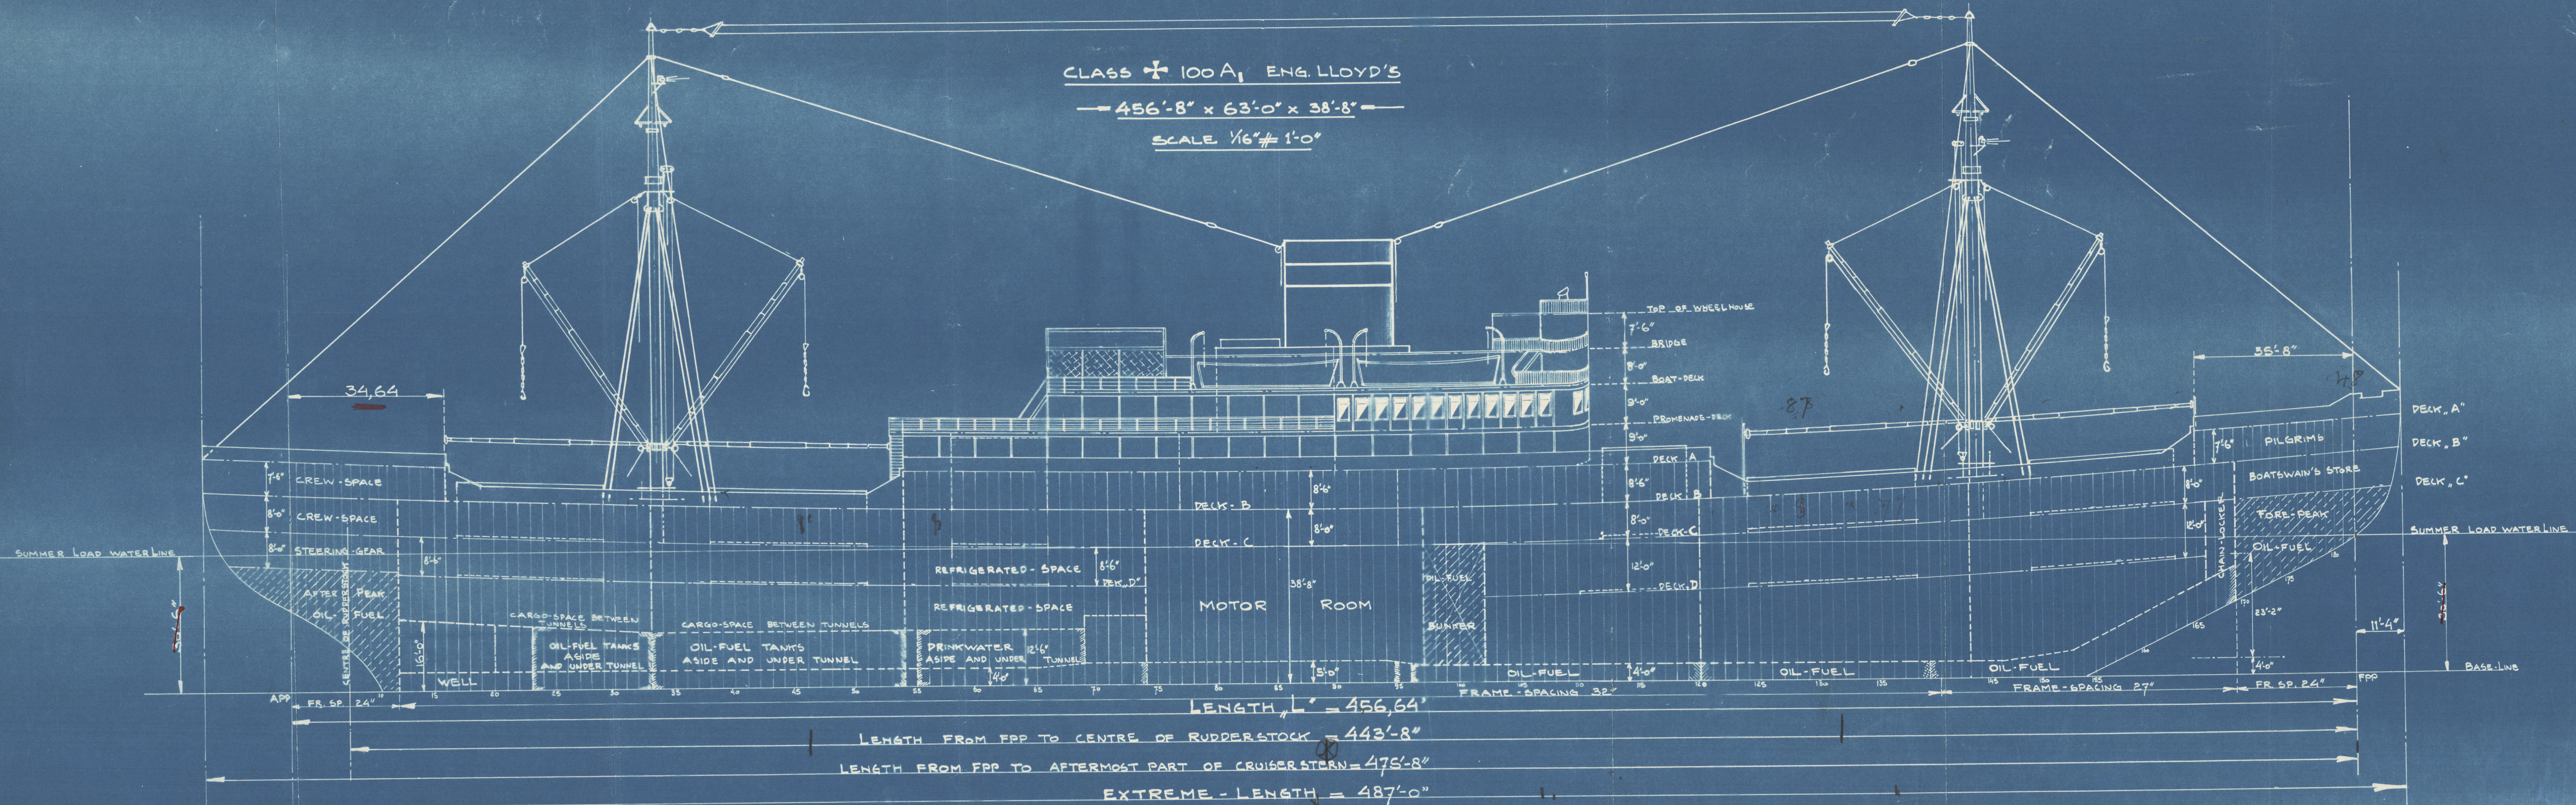

2

VEREENIGDE NEDERLANDISCHE
SCHEEPVAART MAATSCHAPPY

PROPOSED T.S.M.V.

GENERAL ARRANGEMENT.

M.V. "BLOEMFONTEIN"

GEN. BOX NO 1290



© 2021

Lloyd's Register
Foundation

002577-002582-0006