

Nº 711 INSULATED CARGO SPACES

SCALE: $\sim \frac{1}{2}'' = \text{ONE FOOT}$


PLAN Nº E/14.

AUG -47

30/9/47

J.D. HALL (1) 28-47

Jos Hall 19.8.47

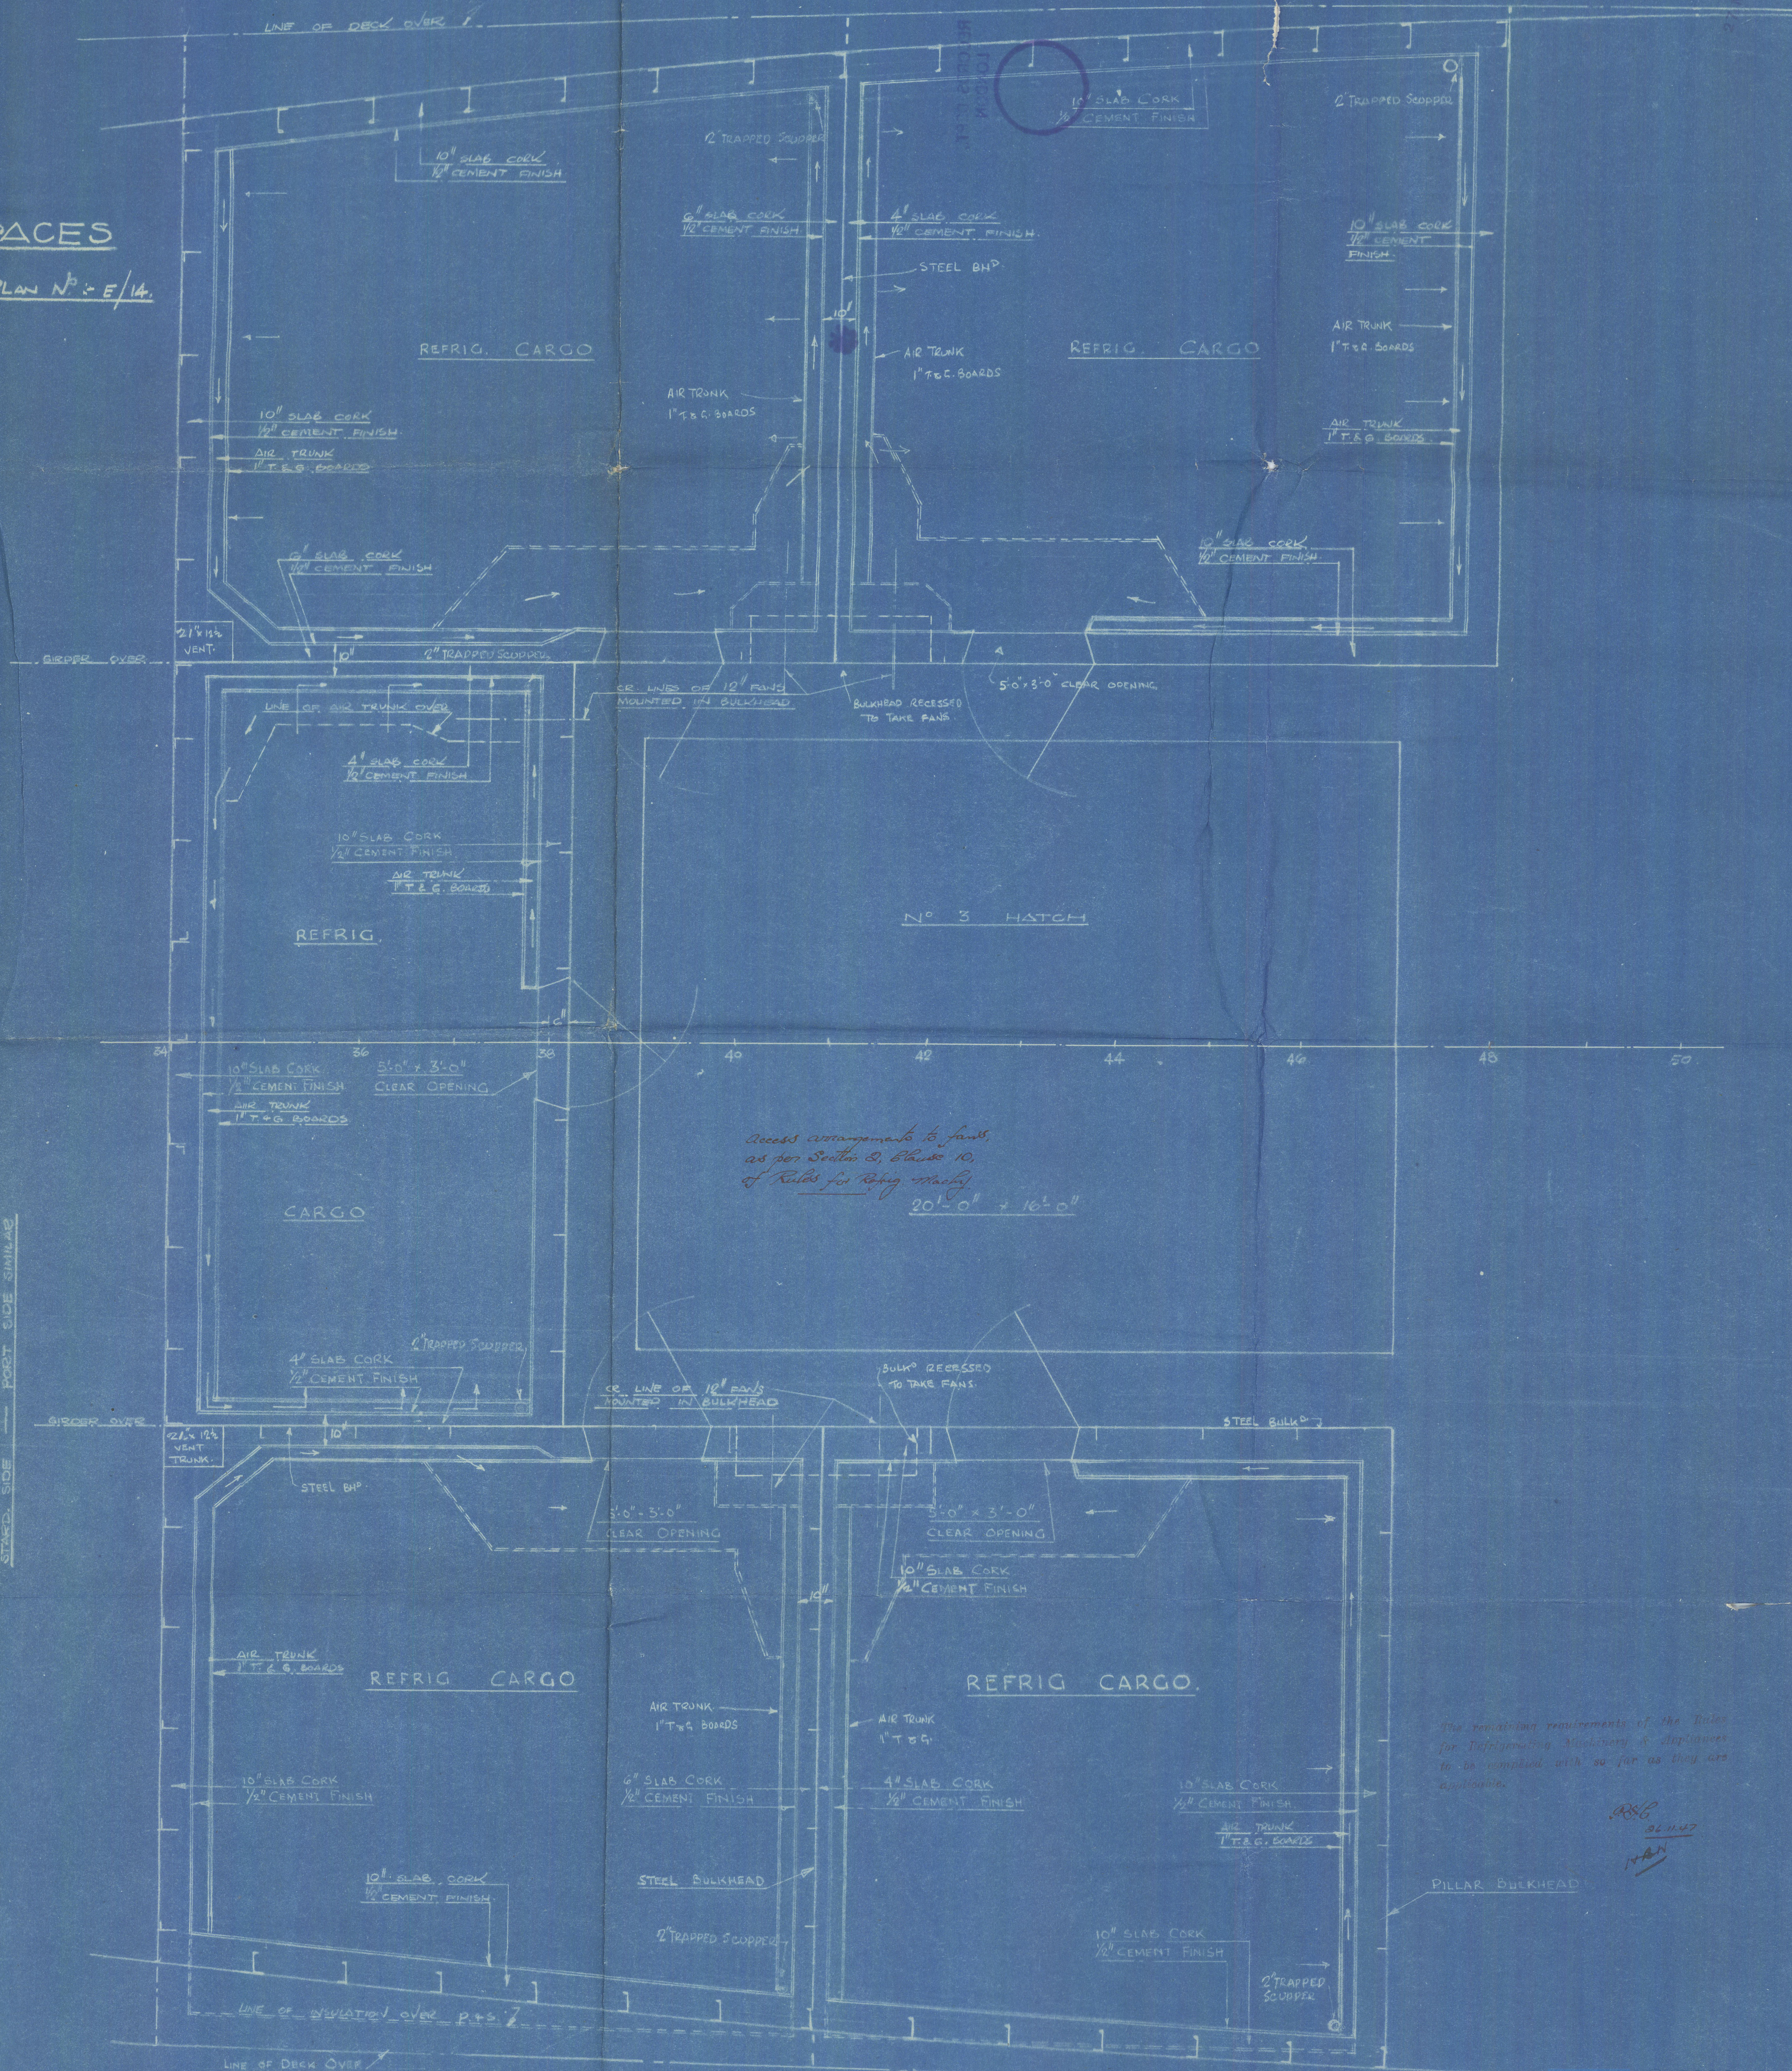

The remaining requirements of the Rules for Refrigerating Machinery & Appliances to be complied with so far as they are applicable.

RSC
31/10/47
H.A.N.

PILLAR BULKHEAD

PLAN AT MAIN DECK

BARCLAY, CURLE & Co. LTD.

Nº 711.


INSULATED CARGO SPACES.

GLASGOW REPORT No. 72997

DARA (RMC)



RECORDS DEPT.,
LONDON

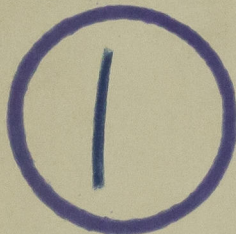

© 2020

Lloyd's Register
Foundation

002583-002591-0207