


Lloyd's Register of Shipping.

Ship's Name *GEM.*Official No. *14915.*

Memorandum of alterations reported since ship was surveyed for assignment of Load Lines in *JULY. 1945.*

- (1) Bosun's cabin and crew's W.C. now built at aft end (p.s) of forecastle as shown. Steel bulkheads 30" thick. Stiffeners 3" x 2 1/2" x 28" spaced approx 30" Wood doors 18" openings. W.C. discharge fitted with storm valve on ship's side below upper dk. ✓

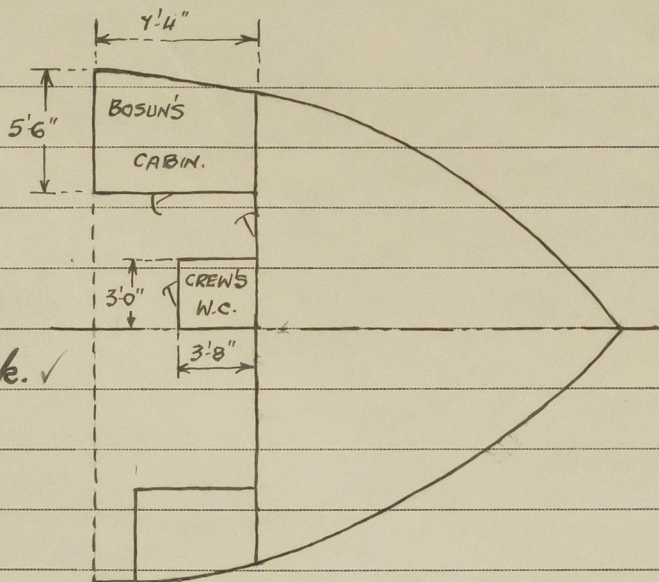

- (2) Officer's washplace now built in engine casing (access from open deck) aft end p.s. fitted with bath, 2 washbasins and scupper all discharging through storm valve on ship's side below Raised Quarter dk.
- (3) Crew's washplace now built in bunker hatch (access from open deck) p.s. fitted with bath and 2 washbasins discharging through storm valve on ship's side below Raised Quarter dk. ✓
- (4) Galley sink now fitted, discharging through storm valve on ship's side below Raised Quarter dk. ✓
- (5) Washbasin now fitted in Captain and chief officer's cabins in Bridge space, discharging through storm valves (p. and s) on ship's side below upper deck. ✓

A copy of above has been placed on board the ship. ✓

W. Macmillan
Greenock. 13/6/46.

W. Macmillan
13/6/46