


OSLO

CHRISTENSEN &amp; CO. A/S.

ARNESEN,

002662-002610-0130

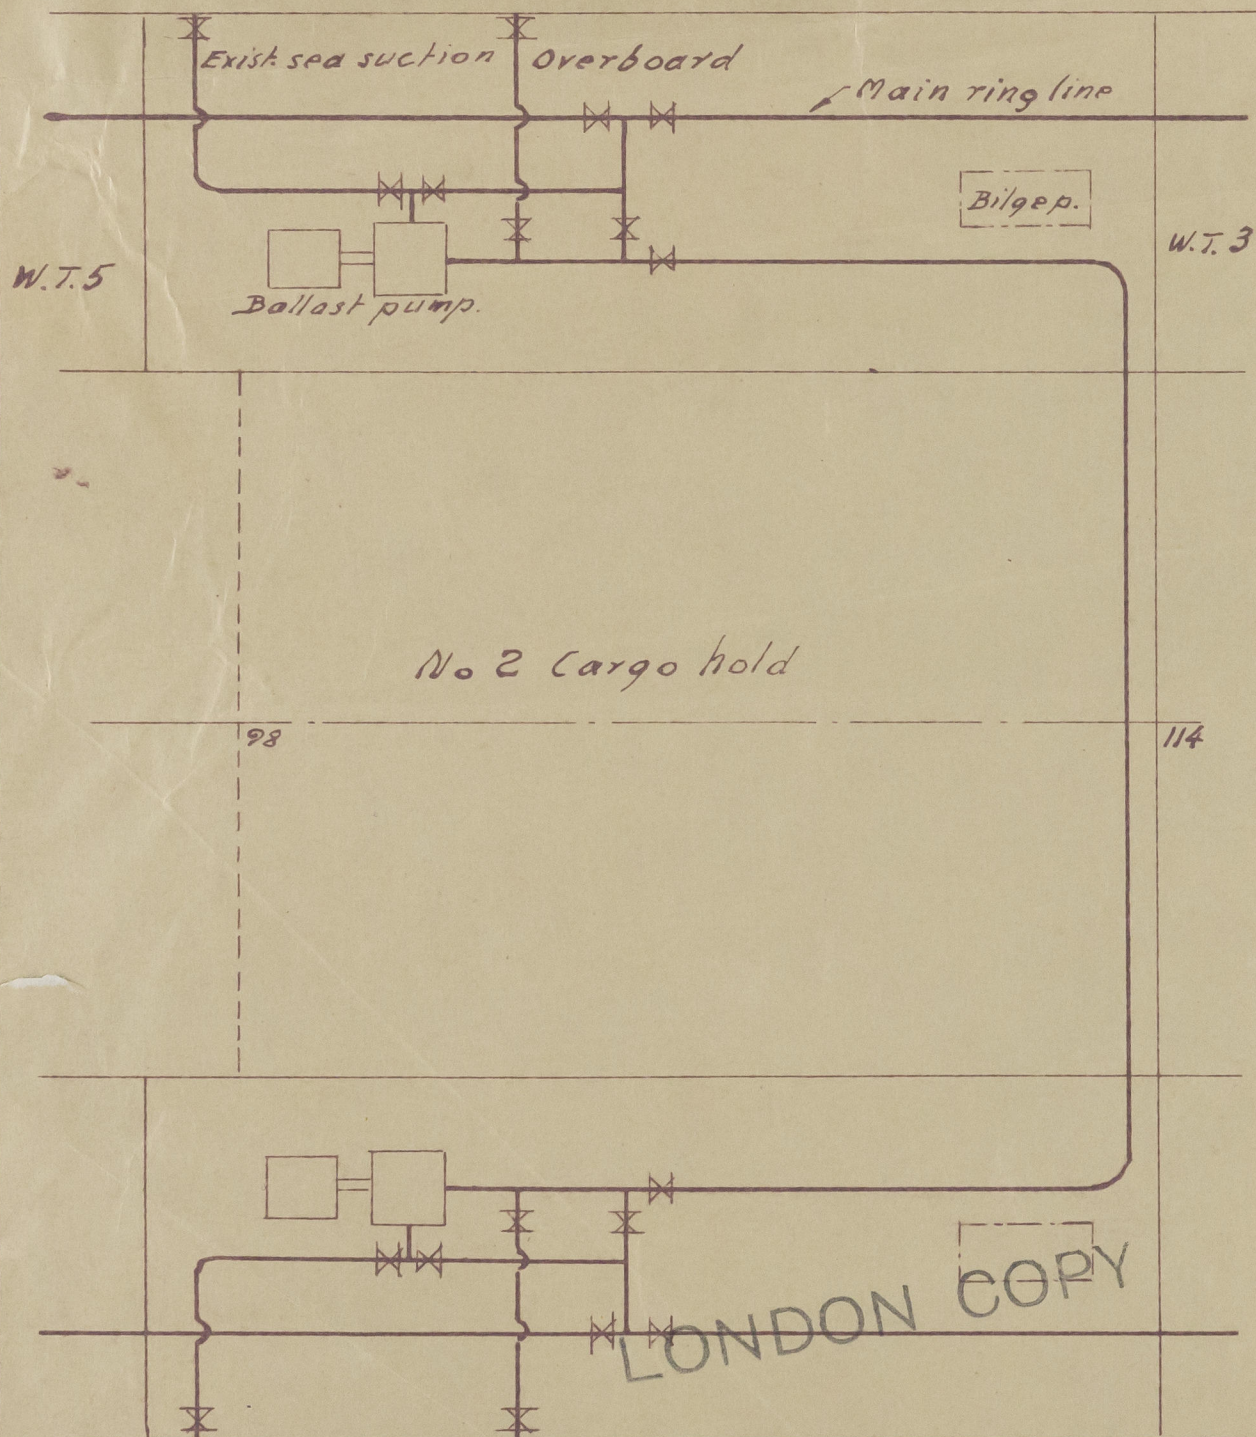

... requirements of the Rules for  
Pumping and Piping to be complied with so  
far as they are applicable.

4/B 13/9/55

WRC

TEGN. <i>Mu.</i>	SKALA: <i>2</i>	<del>MS. "LUCILLUM"</del> MS. "HUMILITAS"	DATE: 17-8-55
KFR.		Ballastline arrangement in pumproom	TEGN. NR.: 3157/336