

# SS FIREDOG · PROFILE & DECKS.


SCALE  $\frac{1}{8}" = 1 \text{ FOOT.}$

## DIMENSIONS.


LENGTH L-W-L 242'-9"  
BREADTH MLD 39'-4"  
DEPTH MLD 18'-6"

S. P. AUSTIN & SON, LTD.  
BRIDGEBUILDERS & REPAIRERS,  
WHEAR 1000, YARDS,  
SUNDERLAND.  
Date 18th Sept. 1944.  
Reference No. 226364.


### BRIDGE FRONT - 75 FRAME.

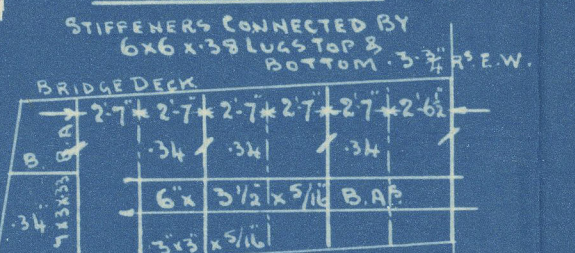



### BRIDGE END - 67 FRAME.

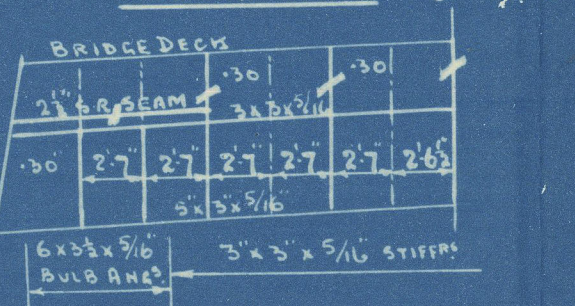

### BRIDGE DECK.

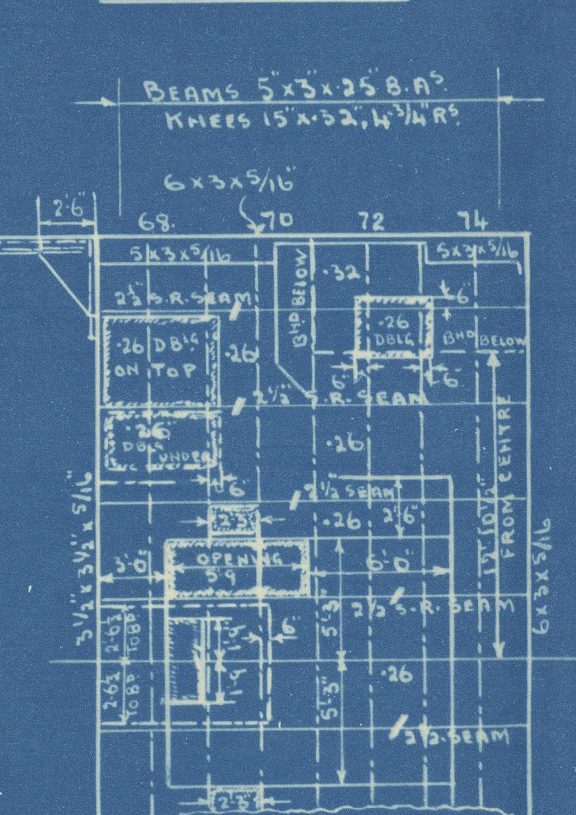

### SHELL AT BREAK.

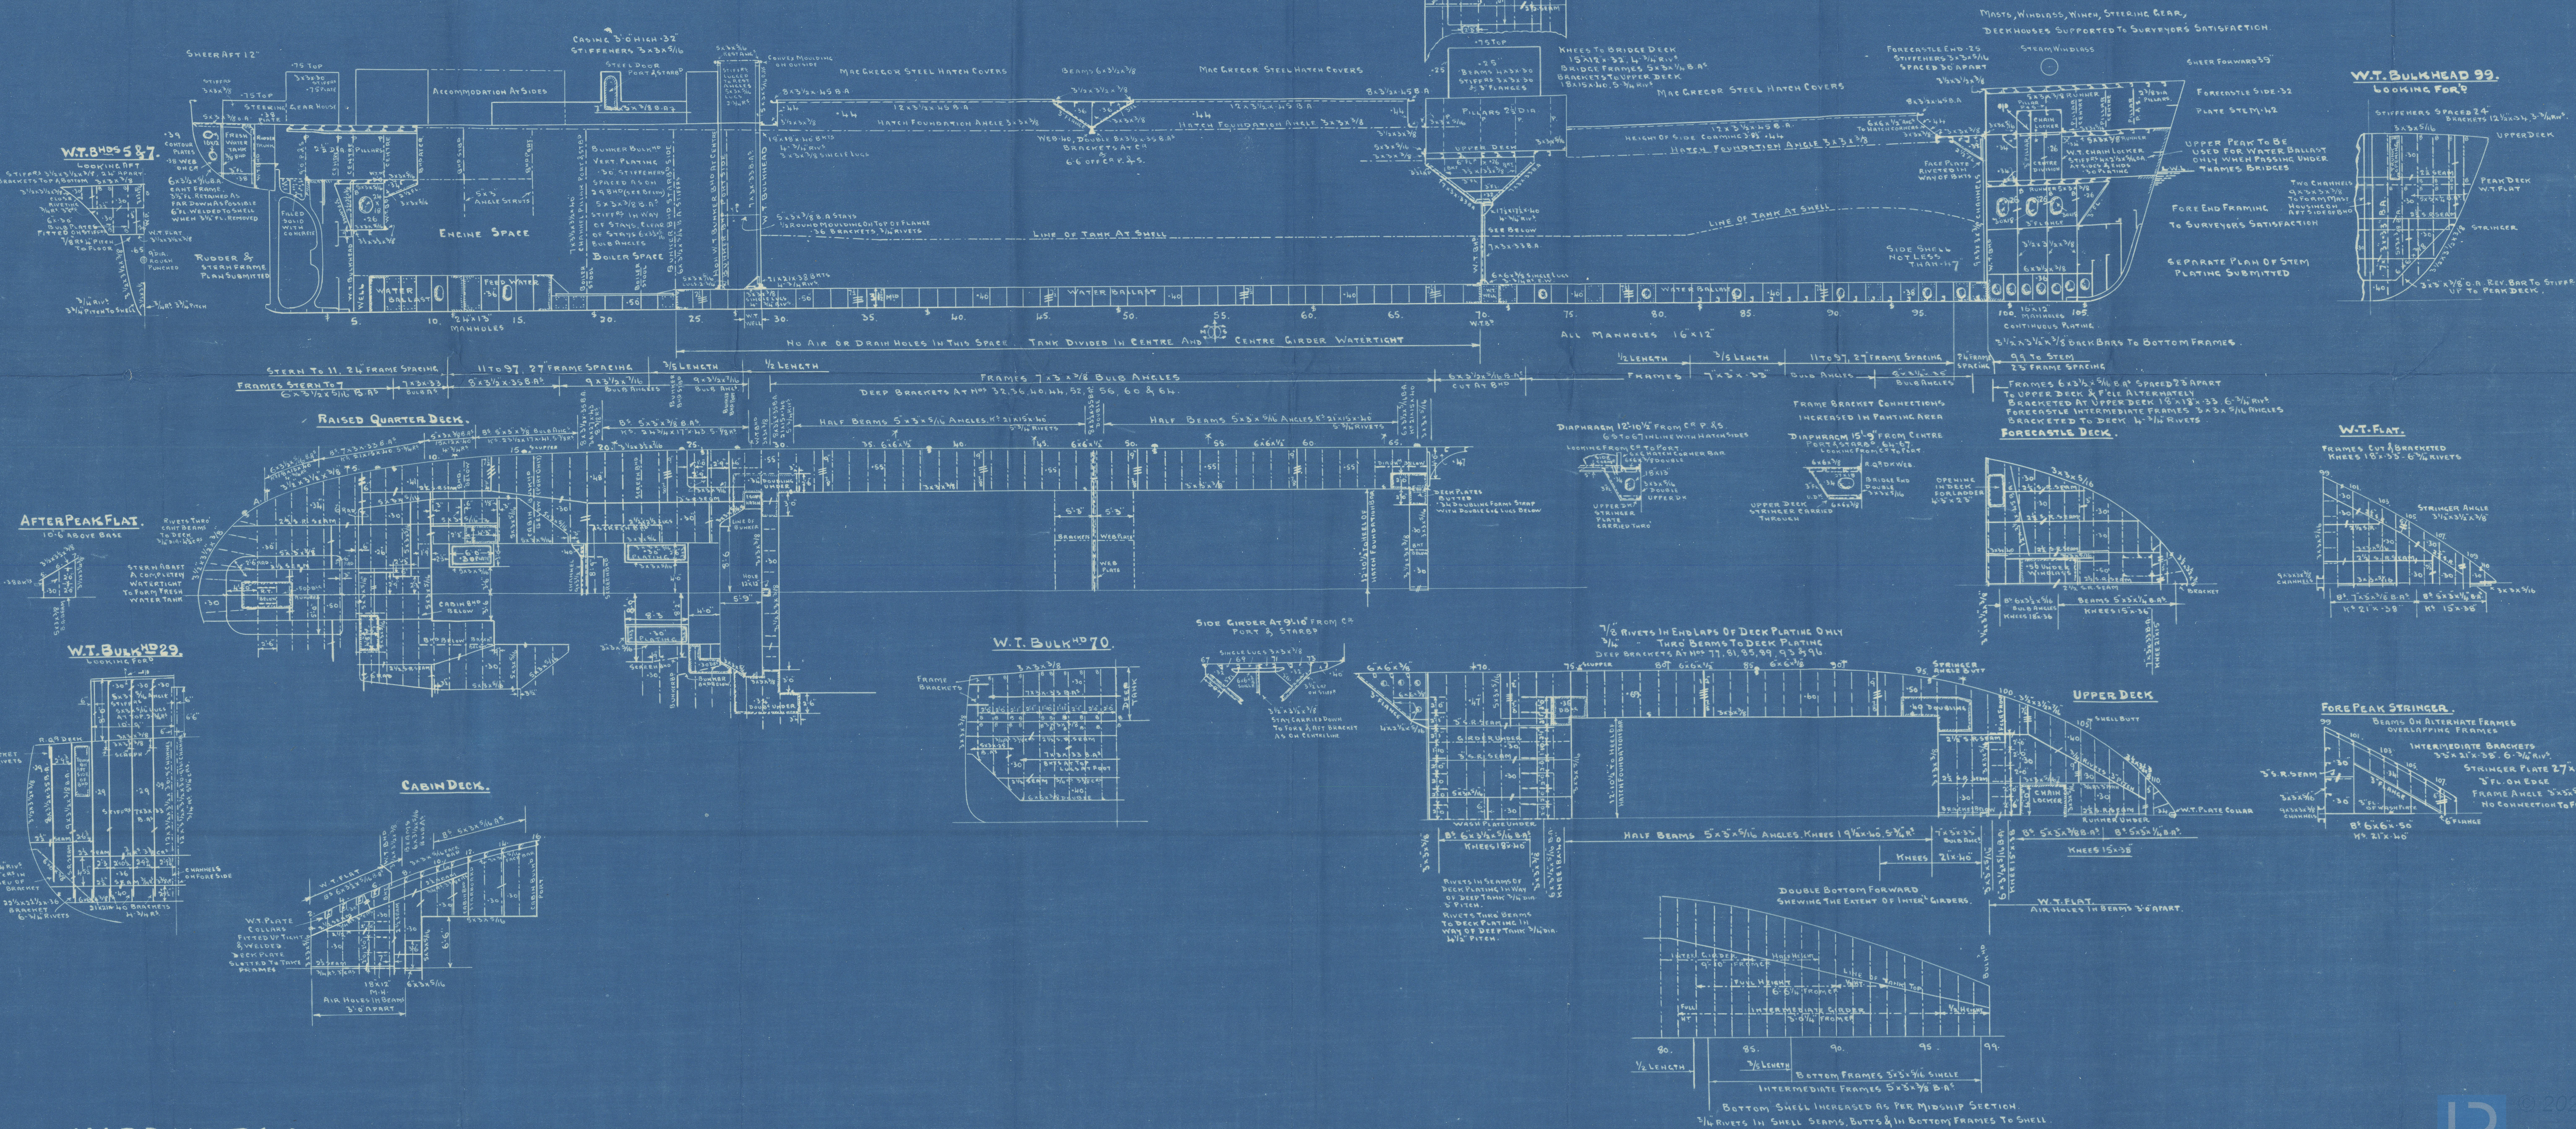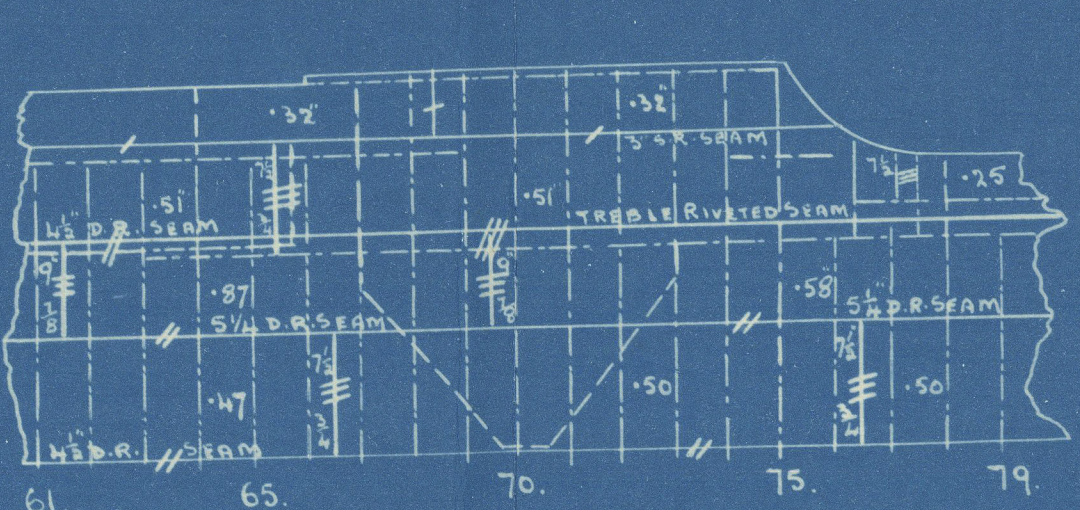

YARD No 364.



S.P. AUSTIN & SON. LTD

YARD No 364.

S.S. FIRE DOG

PROFILE & DECKS (AS BUILT.)

BUNDERLAND RPT. No. 33490.


"Fire dog"



BUNDERLAND RPT. No. 34045

"Fireglow."

↑ see later plan

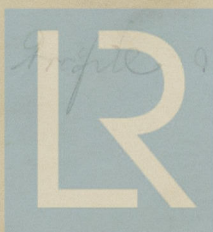

© 2020

Lloyd's Register  
Foundation

002611-002619-0040