


7.11.10  
 11.10  
 2.11.10  
**FERGUSON BROS.**  
 SHIPBUILDERS & ENGINEERS.  
 PORT-GLASGOW. 15<sup>th</sup> November '10  
*PL.*

**PROFILE & DECK PLAN.**  
**SINGLE SCREW HOPPER BARGES Nos 197-203.**  
 To Class  
 "100 A-1" AT LLOYDS HOPPER BARGE FOR CHANNEL PURPOSES.  
 DIMENS: - 173'-9" x 32'-0" x 13'-5 1/2" DEPTH MLD.  
 SCALE: 1/8" = 1 FOOT.



C.7.  
 19.11.10

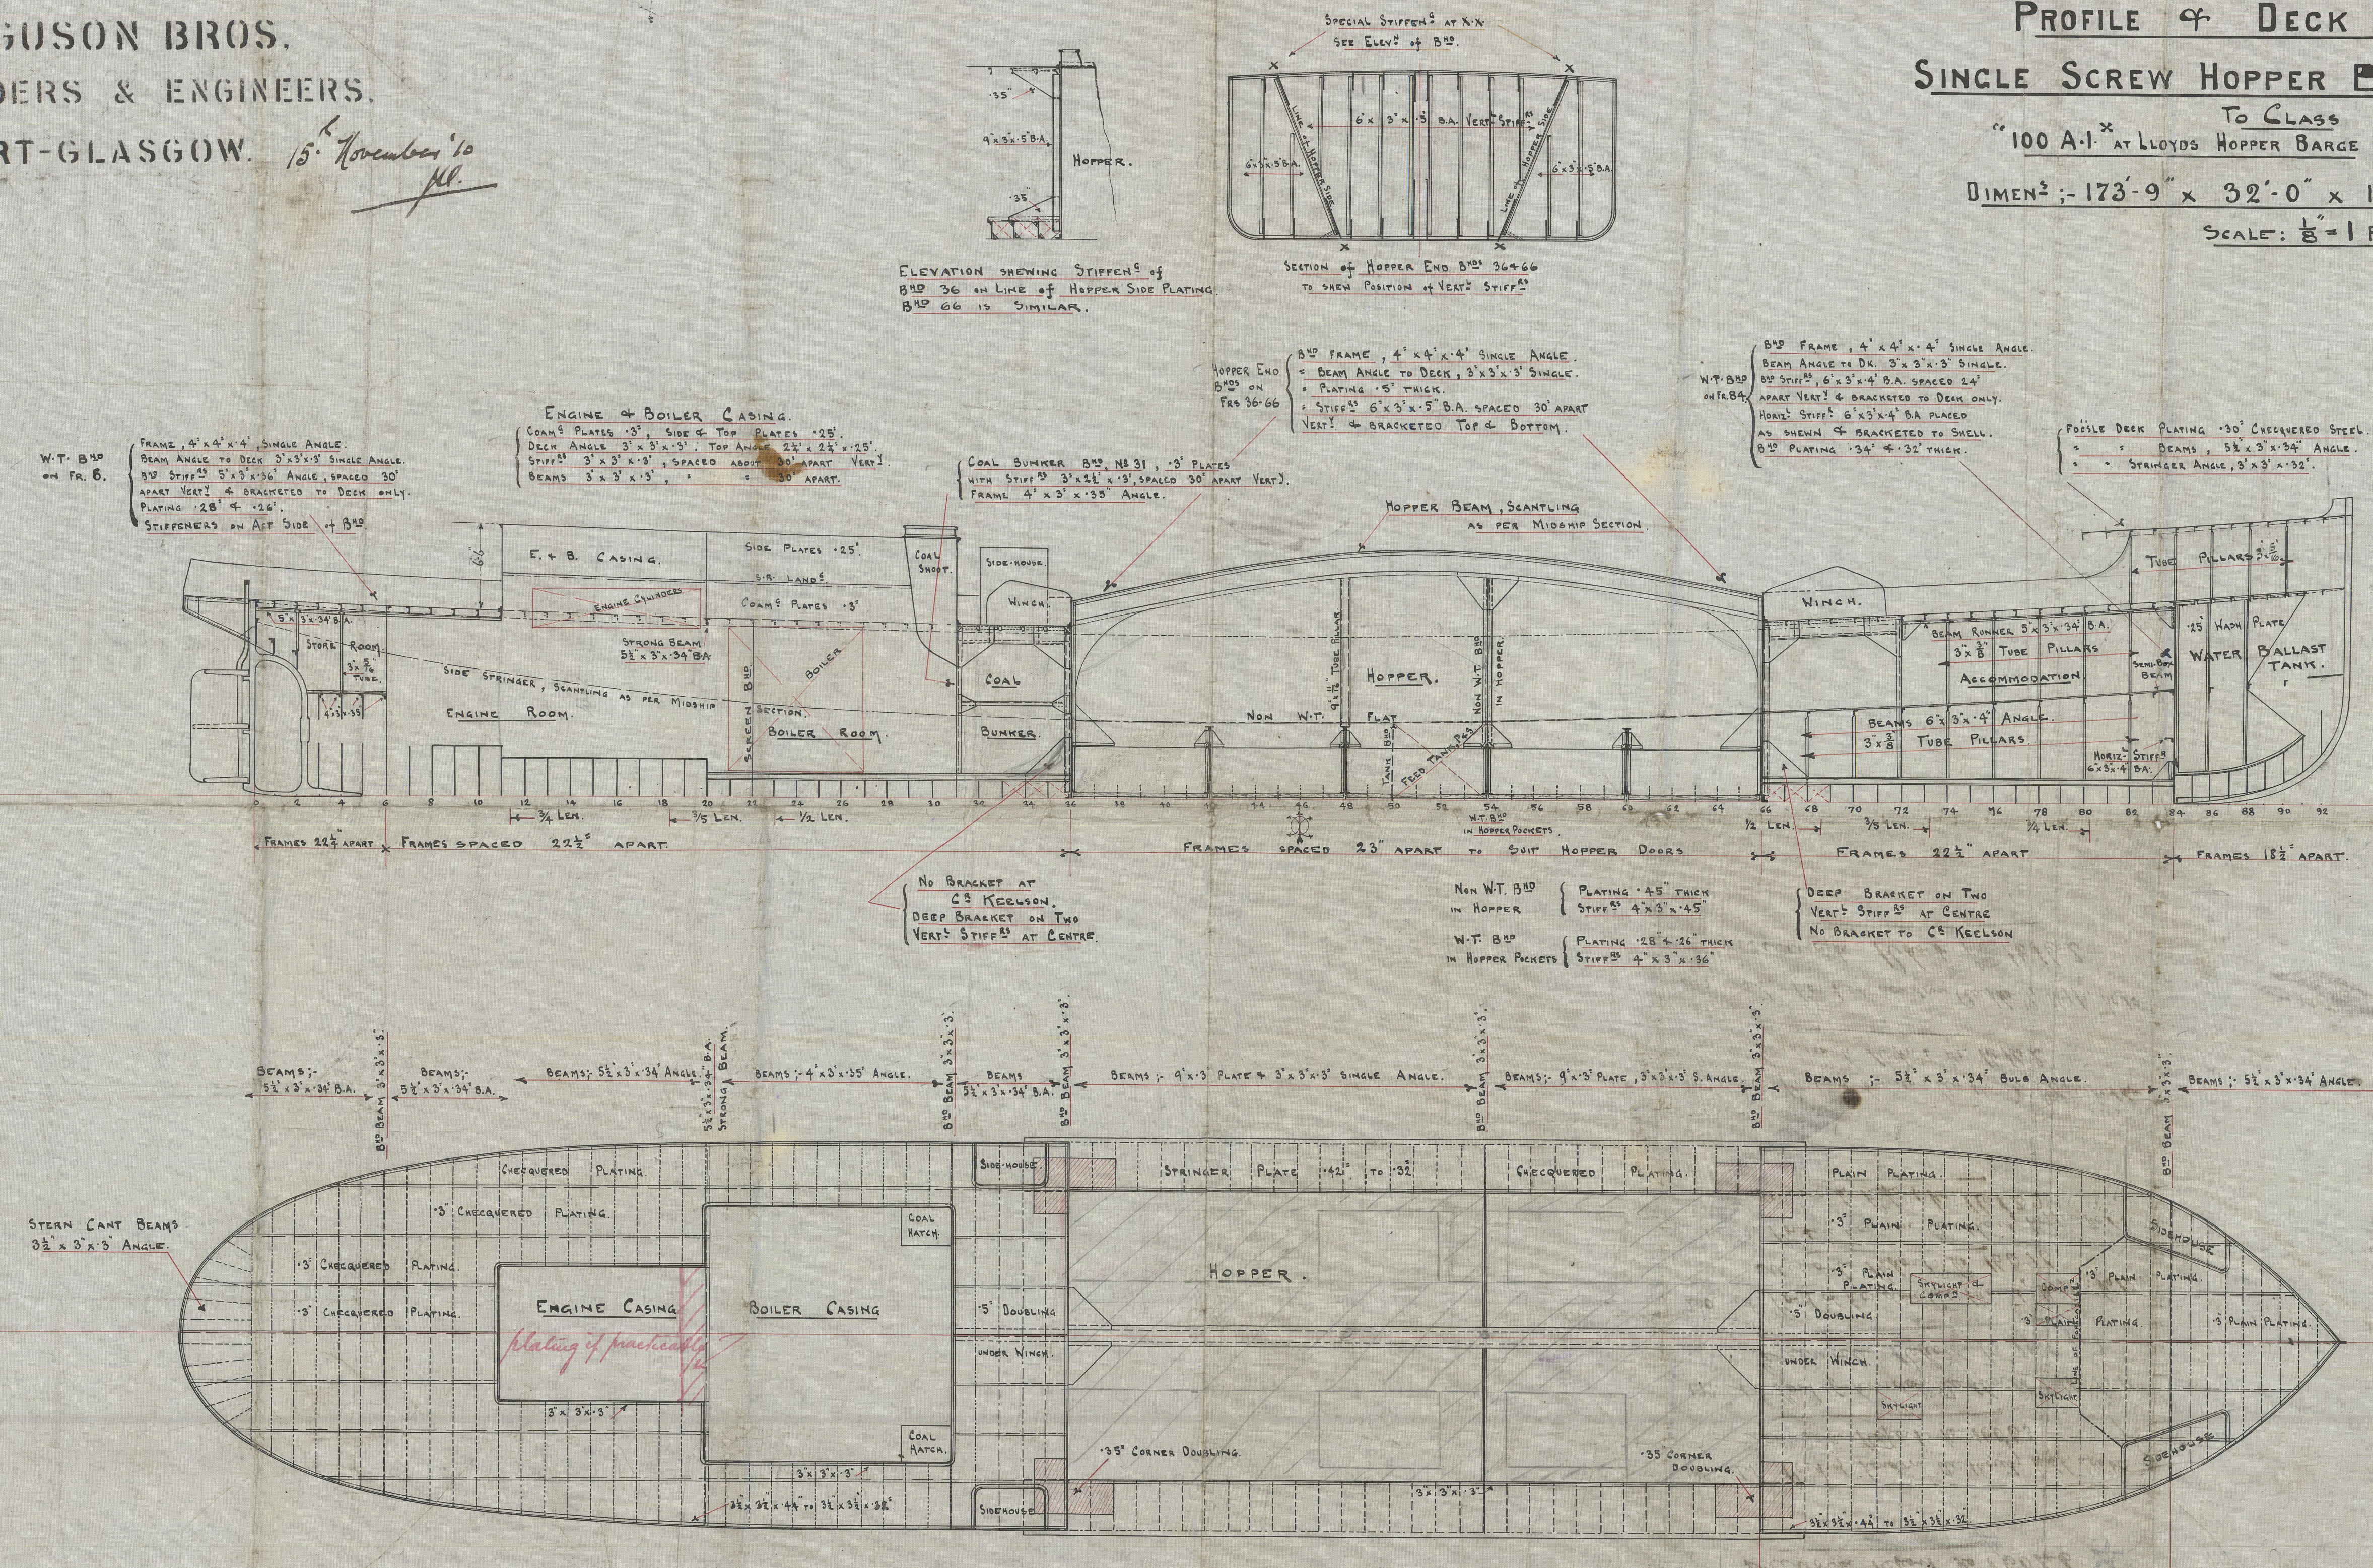

17  
Profile Deck Plans  
Ferguson Bros

No 197-8-9. 200-1-213

197. St. Port of London Authority Hopper No 9.  
Greenock Report. No 16046 \*
198. St. Port of London Authority Hopper No 10  
Greenock Report. No. 16063
199. St. Port of London Authority Hopper No 11  
Greenock Report. No 16079
200. St. Port of London Authority, Hopper No 12.  
Greenock Report. No. 16096
201. St. Port of London Authority Hopper No. 13  
Greenock Report. No. 16129
202. St. Port of London Authority, Hopper No 14  
Greenock Report. No. 16142
203. St. Port of London Authority, Hopper No 15  
Greenock Report. No 16162