

23 FEB 1950

Rpt. C. 11 (Contd.)


Index No.

Lloyd's Register of Shipping.

Ship's Name "FOREMOST 17"

Official No. 132542

Memorandum of alterations reported since ship was surveyed for assignment of Load Lines in

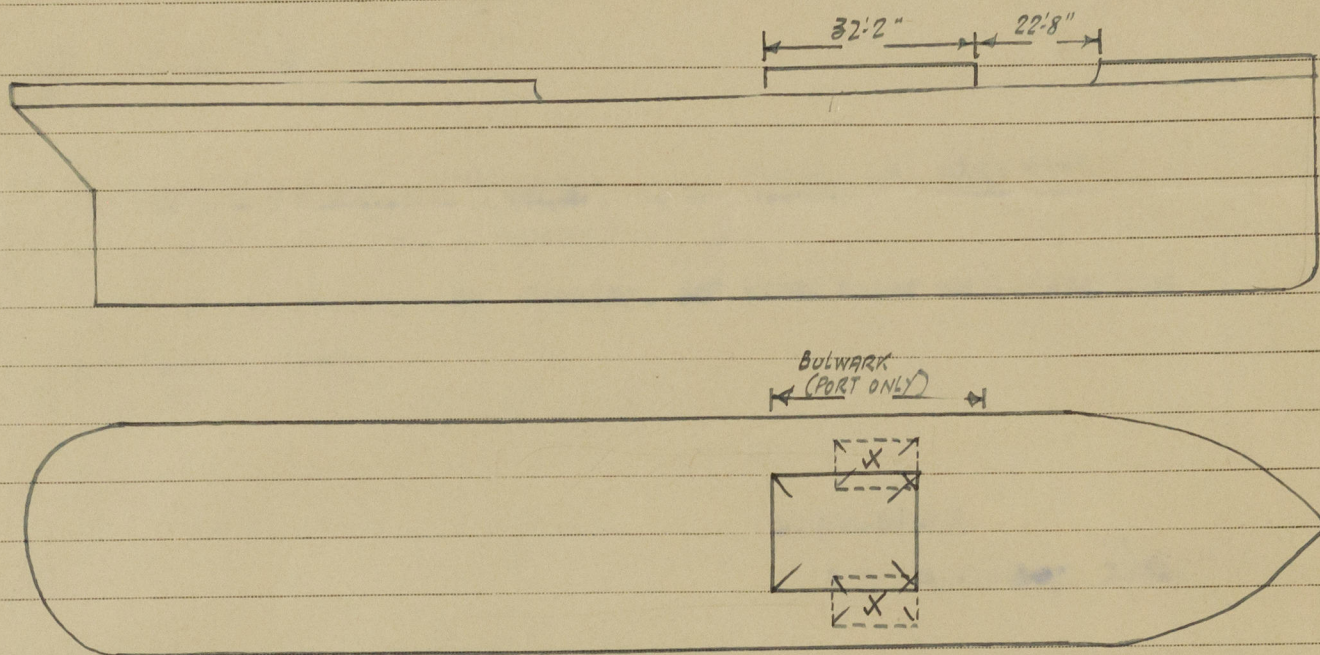

Existing steel hatches removed and deck plating etc. re-instated in way.

New hatchway fitted 13'5" x 11'0". Coaming 24" x .5" with 3" x 3" x 3/4" rest bar, 7" x 3 1/2" B.A. cleat bar, 3" wood covers and 2 tarpaulins. Cleats, battens, wedges and lashings fitted. Side & end coamings supported by stays as per rule requirements.

Bulwark fitted abreast new hatchway (port side only) length 32.17ft. Height of bulwark 36" x 7/16" thick, and fitted with 6" x 3" B.A. Rail bar.

Hatchway beam fitted to rule requirements.

MacLeod

Grimsby 22/2/50

Beams
Stays

Ad.
27 FEB 1950