

SHIP No 991

TILLER FOR QUADRANT.
FORGED IRON - ONE OFF PER SHIP.


- To BRITISH CORPORATION REQUIREMENTS -

SCALE $1\frac{1}{2}" = 1 \text{ FOOT.}$

19 JUL 1935



Approved J.L.A. per J.L.
20-7-35

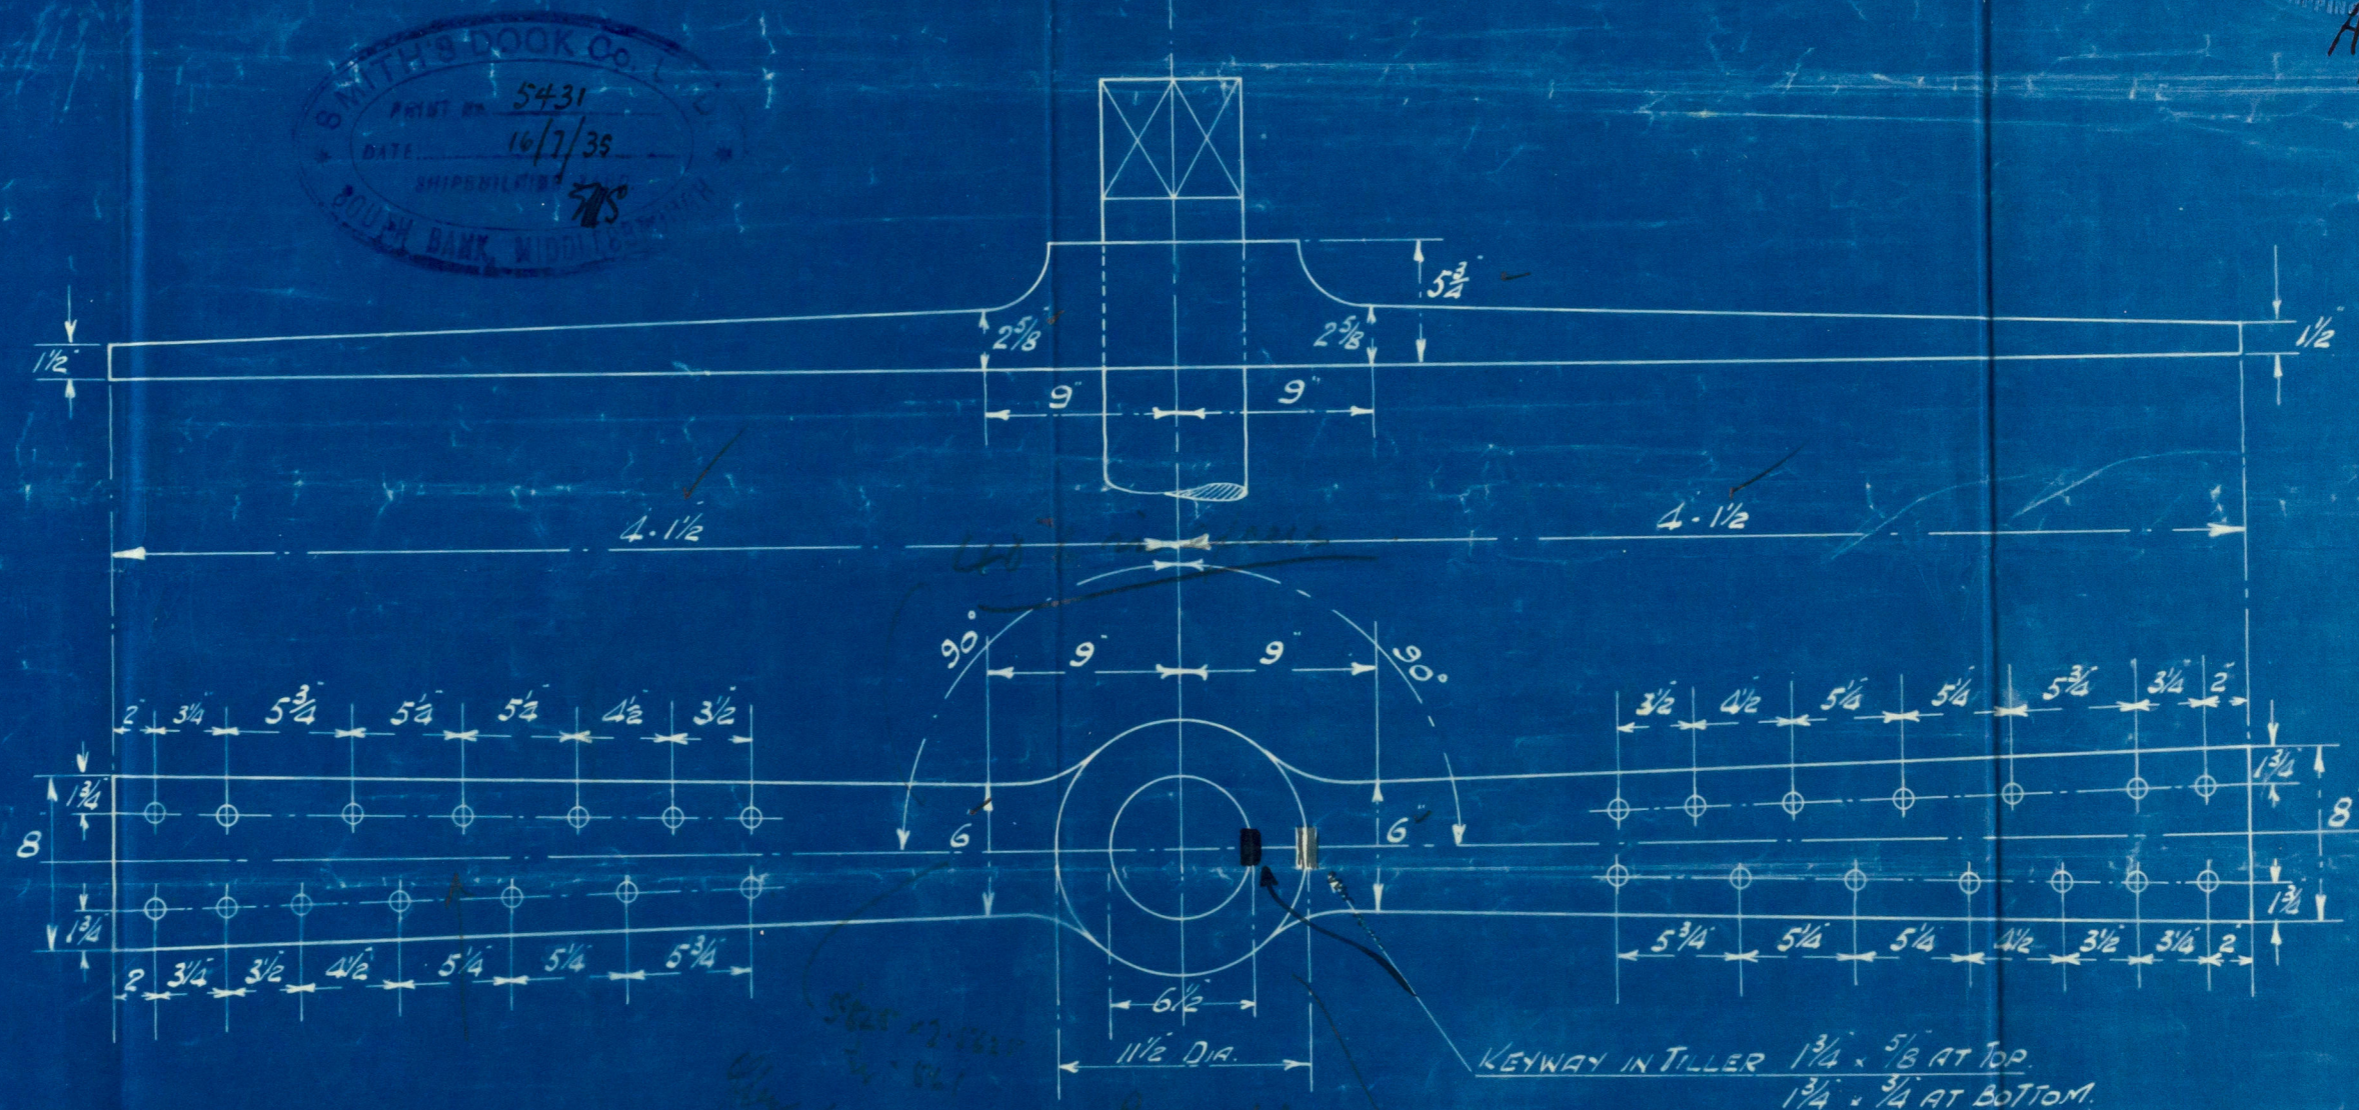

Pressure on Rudder $\frac{AV^2}{700} = \frac{47 \times 12^2}{700} = 10.8 \text{ Tons} \times \frac{104 \times 12}{1.25} = 40 \text{ Tons}$

$5\frac{3}{4} \times 1\frac{3}{4} = 10^{\text{sq}}$
 $\frac{40}{13} = 4 \text{ Tons/sq Shearing force.}$




© 2020

Lloyd's Register

London

00211 001415 0151

5

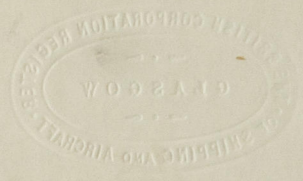

Siller Stan.

Smiths Book Co.

No 991

No. 7. 25.

VESTFOLD X EX VIKINGEN VI NOW ELLY. W. VINKE

Siller.
Smiths Book Co 991.

002611-002619-0182



© 2020
Lloyd's Register
Foundation