


PROFILE & DECK PLANS.

TO CLASS 100 A.I. AT LLOYDS

SCALE $\frac{1}{8}'' = 1 \text{ FOOT}$

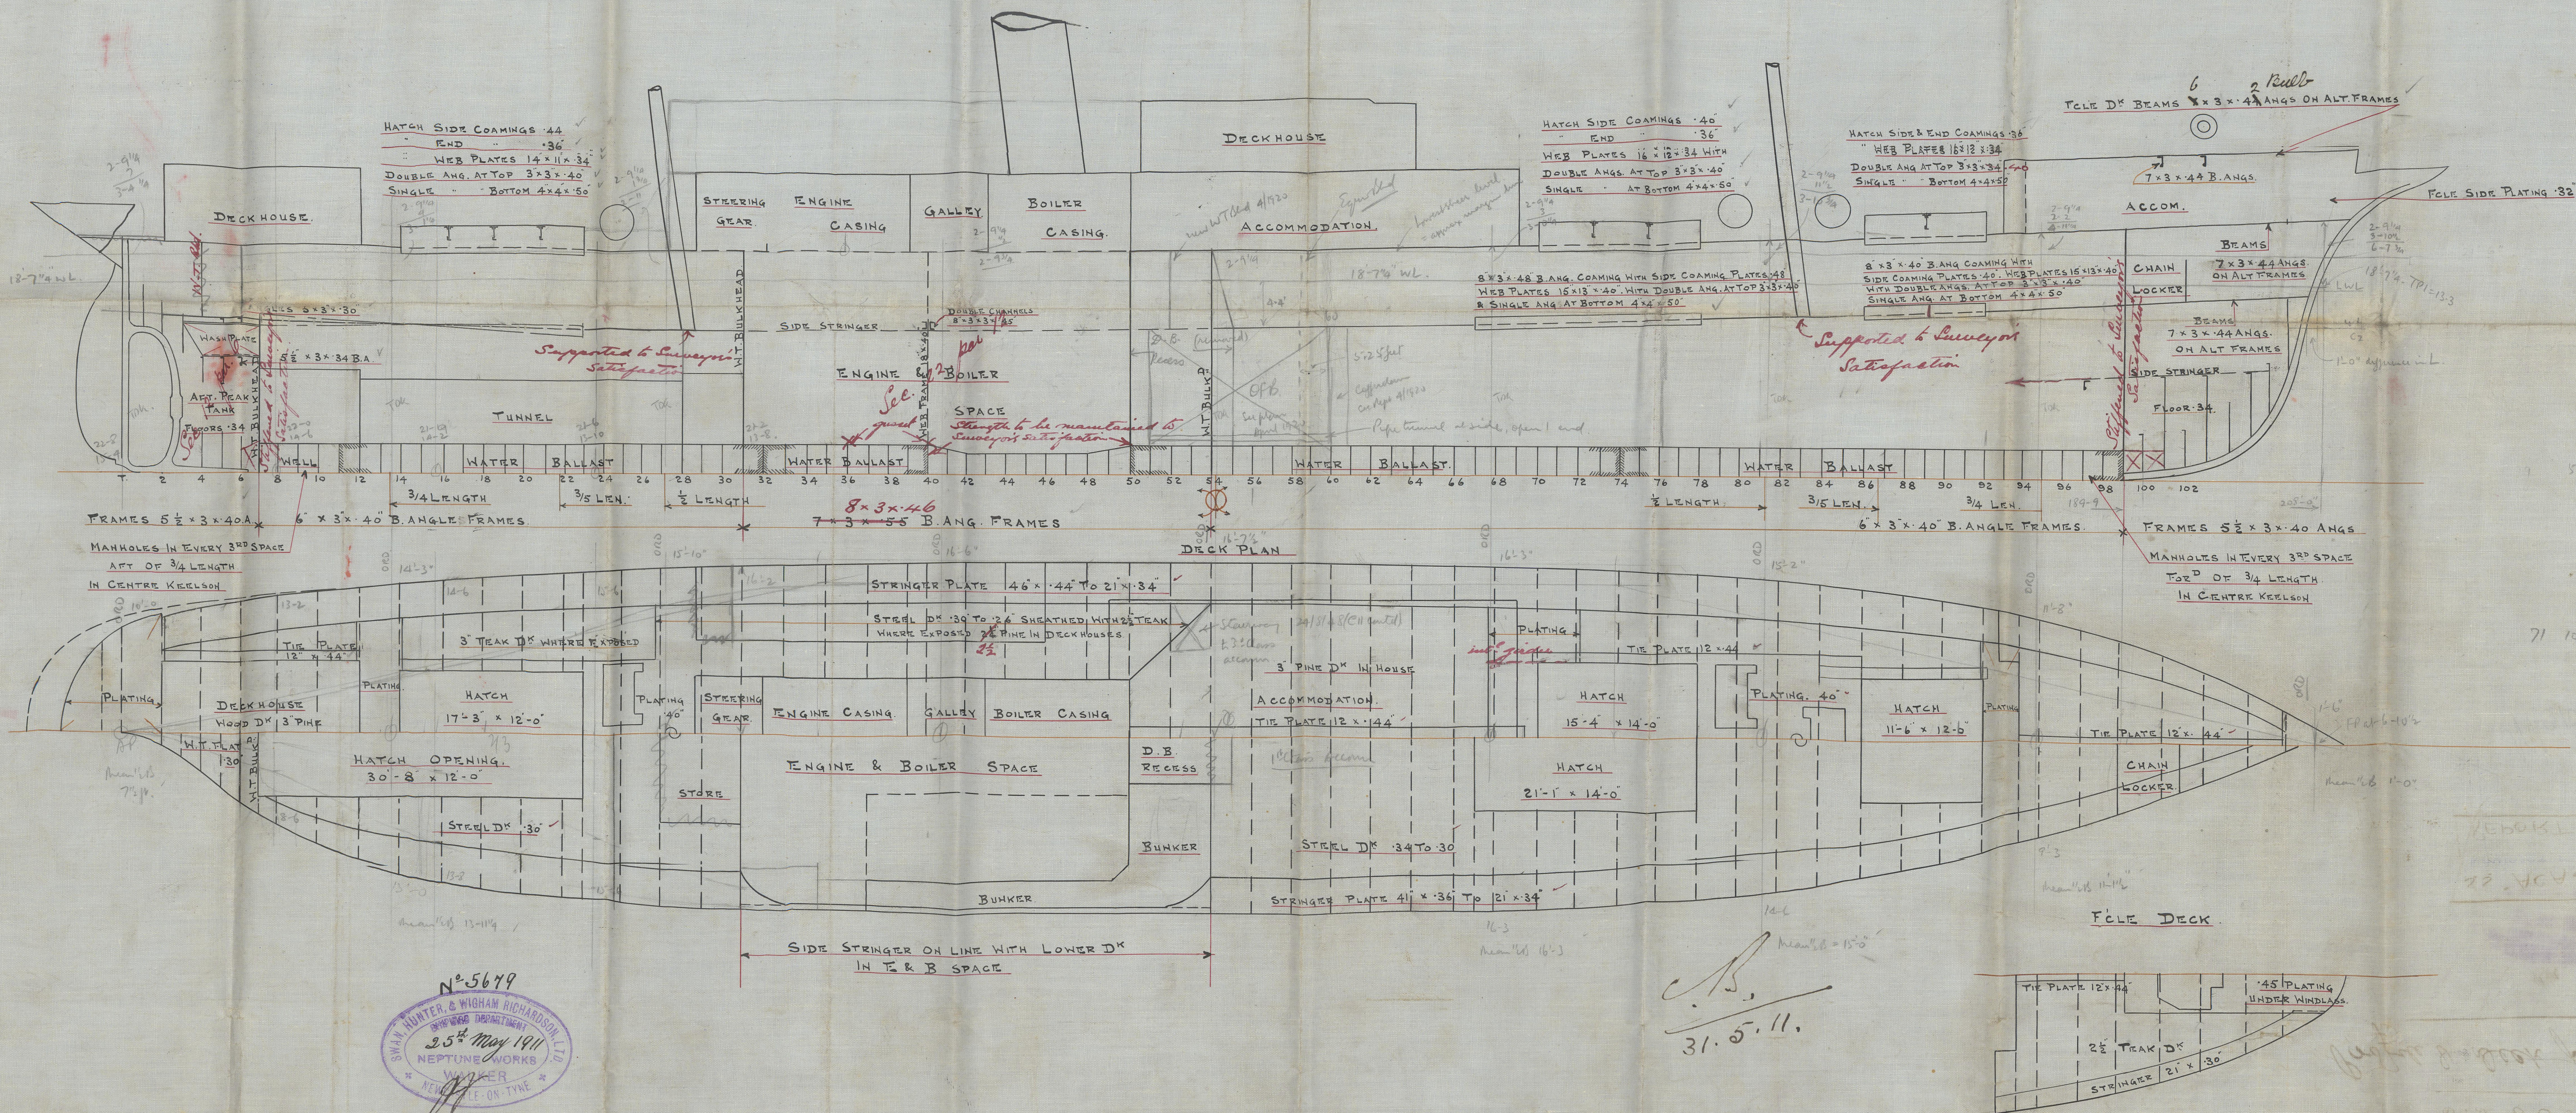

31. 5. 11.

FCLF DECK

N° 5679

SWAN HUNTER & WIGHAM RICHARDSON LTD.
MARINE DEPARTMENT
25th May 1911
NEPTUNE WORKS
WARKER
NEWCASTLE-ON-TYNE

Messrs Swan Hunter &
Wigham Richardson Ltd

S.S. 868

Profile & Deck plans

SS 'ACAJUTLA'

NEWCASTLE-ON-TYNE

REPORT No 61217

Marathon



© 2020

Lloyd's Register
Foundation

002620-002630-0258