


# PROFILE AND DECK PLAN


S.S. Nos. 564-5

DIMENSIONS: 265'0" B.P. X 35'10" X 18'6" M.P.

SCALE: 1/8" INCH = ONE FOOT

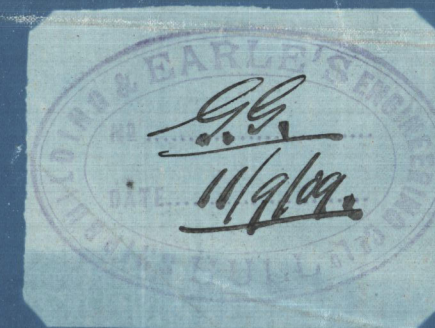

21-9-09  
 24-9-09  
 13-10-09  
 16-10-09  
 10-11-09  
 4-12-09  
 20-12-09  
 (125500) 17-1-10  
 5-2-10  
 24-2-10  
 26-7-10  
 (12577) 30-8-10  
 5-9-10  
 18-10-10

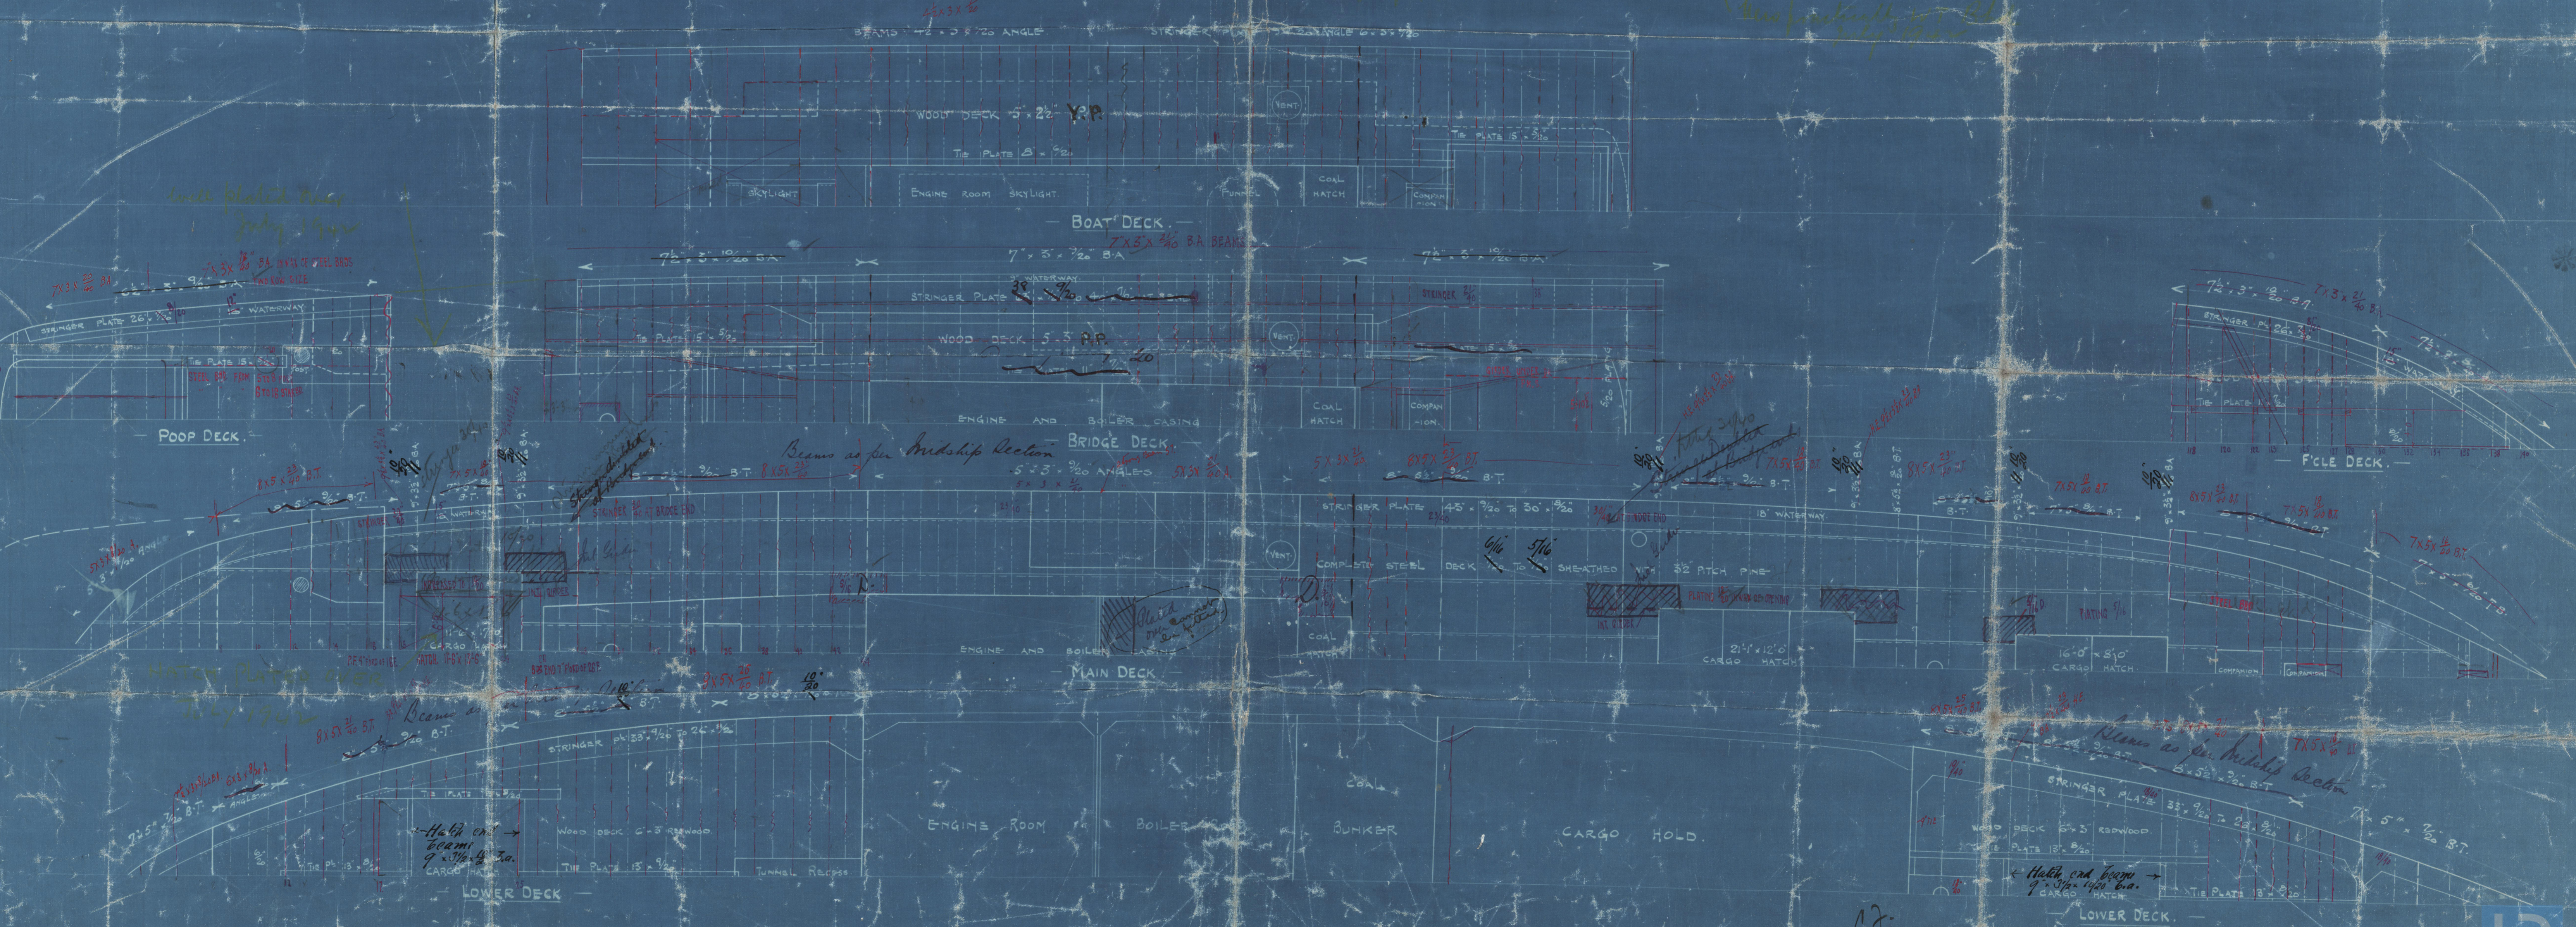

C-7  
 21/9/09

Charles C<sup>o</sup>

N<sup>o</sup> 564 & 565.

568 569 577

Profil & Decks.

|              |                 |       |
|--------------|-----------------|-------|
| 1/2 Dunsbury | Hull Report No. | 22659 |
| - accuon     | -               | 22846 |
| - Blackburn  | -               | 23070 |
| - Burny      | -               | -     |
| - Stockport  | -               | 24123 |



© 2020

Lloyd's Register  
Foundation

002630-01638-0097