


SS N° 400

RULE DIMENSIONS: 40'-7 1/2" O'NL WL x 5'-7 1/4" MLD x 3'-2 1/2" MLD to UPPER DECK  
TO CLASS 100 A.1 'WITH FREEBOARD'  
CORRESPONDING TO THAT OF A C.S.S. VESSEL WITH TONNAGE OPENING

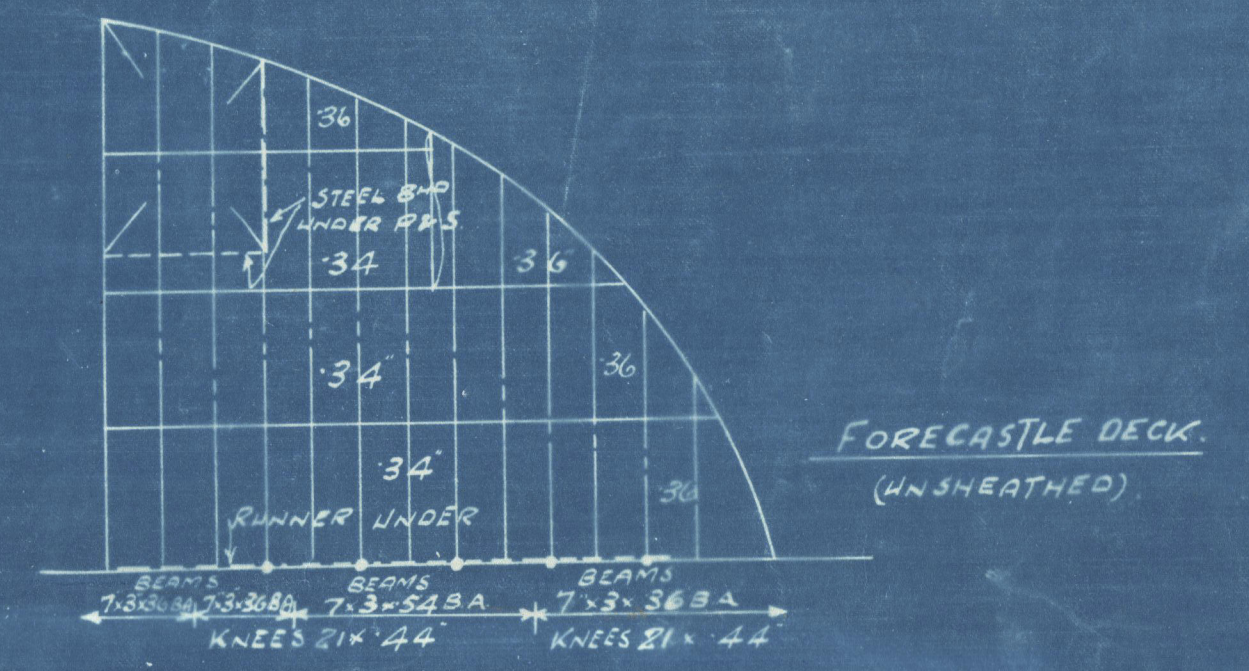



DUNCAN'S.

N<sup>o</sup>. 400.

PROFILE & DECKS (As Built.)

S. S. "Dalia"

Gen. 1<sup>st</sup> Entry Report W. 19304.



© 2020

002630-002638-0124

Lloyd's Register  
Foundation