

30-12-22

# PROFILE & DECK PLAN N° 660 SHIP

DIMENSIONS 130'-0" BP x 22'-6" x 10'-2" MLP

~~SPECIALLY STRENGTHENED FOR~~

~~LOADING AGROUND~~ *See letter*

CLASS 100 A1 LLOYDS

SCALE 1/4" INCH = 1 FOOT

WT. 342 NO. 24  
CORNING PLATE 3/8" THICK REMAINDER 26" VERTICAL  
STIFFENERS 5" x 3" x 32" ANGLES SPACED 36" APART  
BRACKETS 12" x 12" x 3/8"  
BOUNDARY ANGLE 3" x 3" x 36"

WT. 342 NO. 24  
CORNING PLATE 3/8" THICK REMAINDER 26" VERTICAL  
STIFFENERS 5" x 3" x 32" ANGLES SPACED 36" APART  
NO BRACKETS TO STIFFEN  
BOUNDARY ANGLE 3" x 3" x 36"



FACE PEAK TANK 342 RECESSED FROM 66 TO 62 FRAMES

PLATING AT TANK END NO 62 FRAME 32"


ABOVE RECESS NO 66 FRAME 36"

ON TOP OF RECESS 62 TO 66 FRAMES 32"

STIFFENERS AT 62 FRAME IN TANK 4" x 3" x 32" WITH BRKTS 10" x 10" x 3/4" AT TANK BOTTOM

66 FACE SIDE TO TANK PLATE 3" x 3" x 36"

FACE FRONT PLATING 26" STIFFENERS 3" x 3" x 36" ANGLES SPACED 36" APART

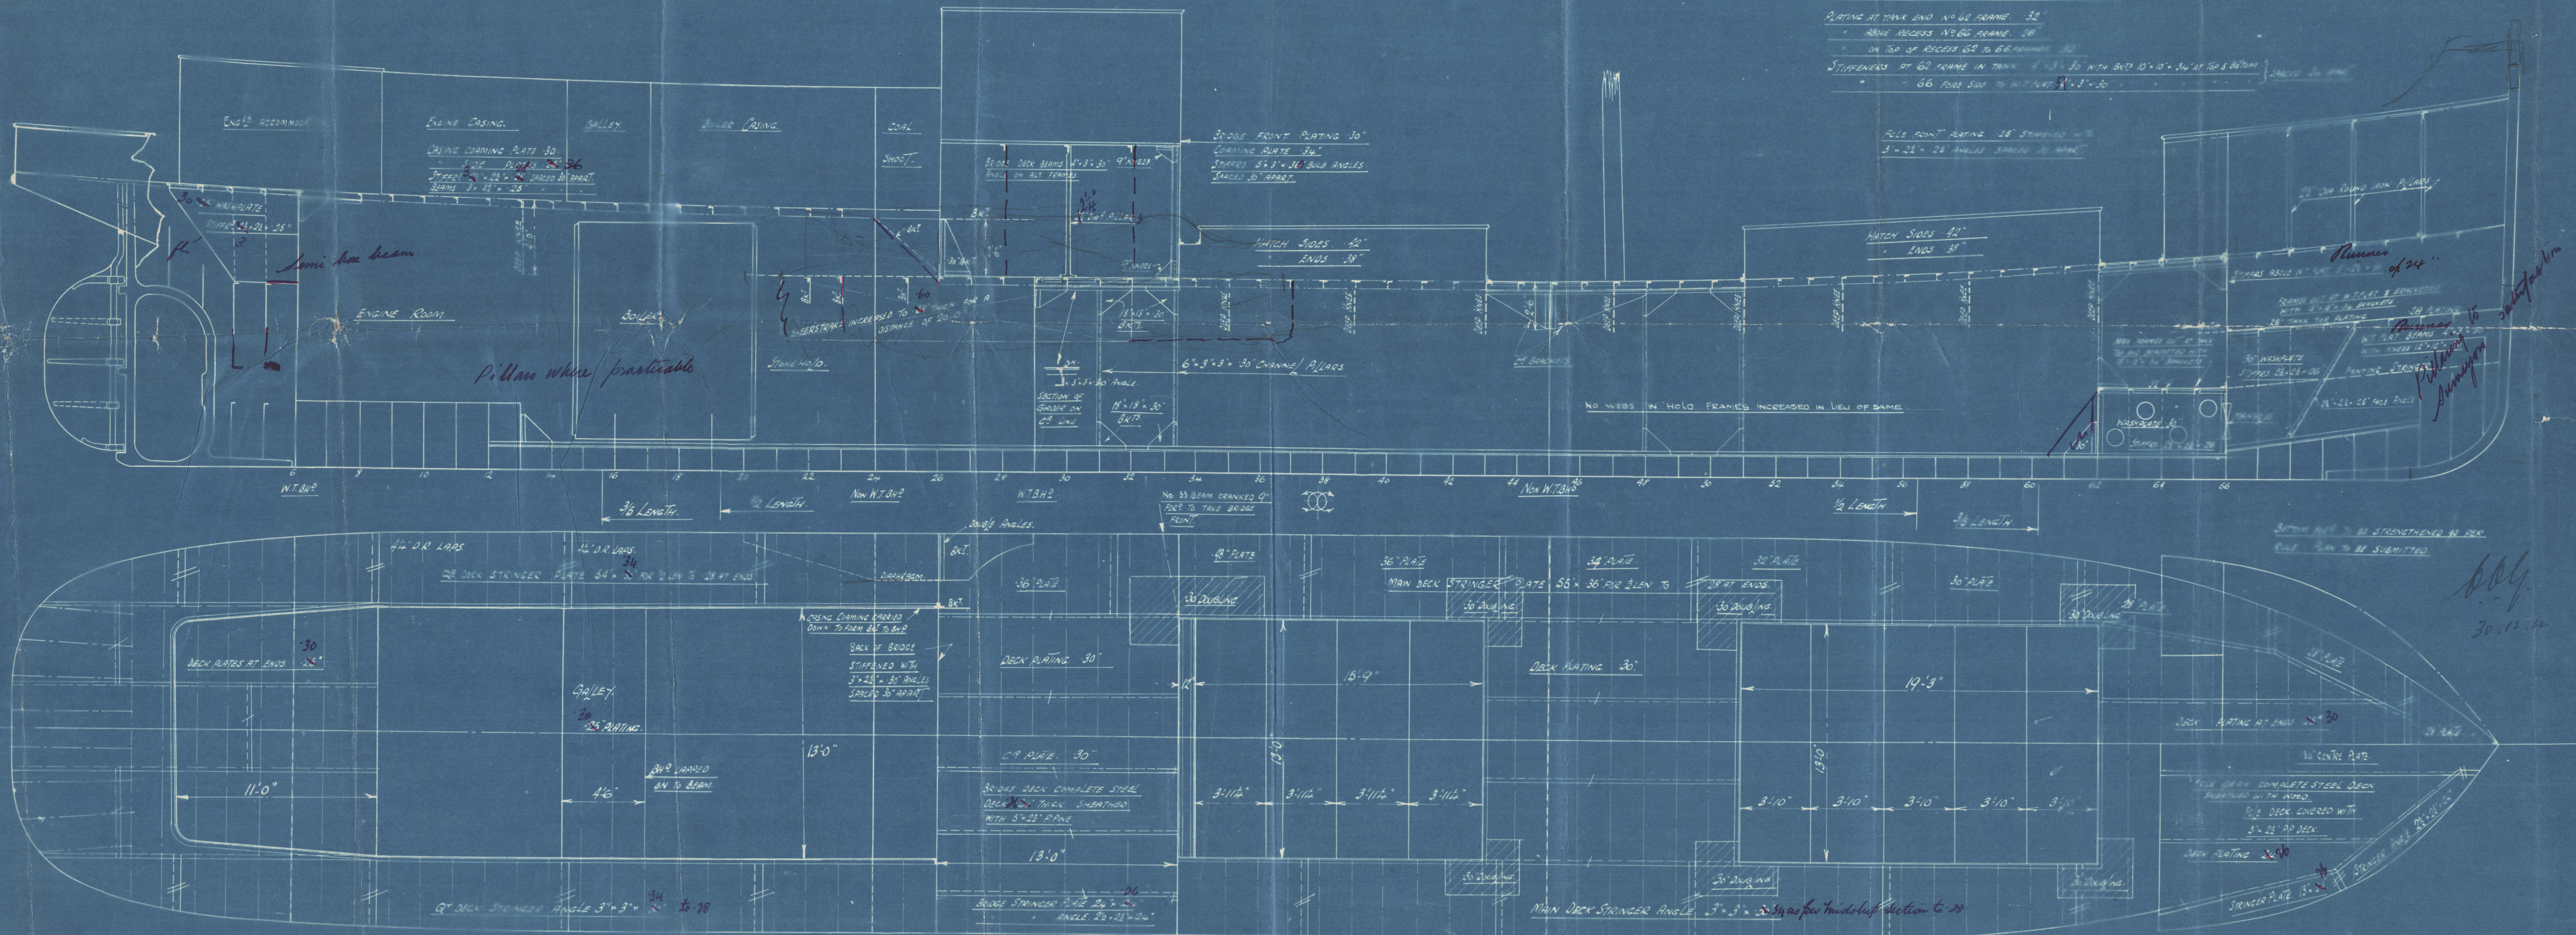

30.12.22



*Hepples 70 660 ship*  
Newcastle-on-Tyne.

*Hepples & Co.*  
Hepples (1919) Ltd.

No 660

Profile & Decks.

---

S. S. Florence Cooke

Nwc. Rpt. No.

NEWCASTLE ON TYNE.  
Report No. 76968.



© 2020

Lloyd's Register  
Foundation

002630-002638-0199