

Lloyd's Register of Shipping.

2 NOV 1946

Ship's Name

"FLORENCE COOKE"

Official No.

146926


Memorandum of alterations reported since ship was surveyed for assignment of Load Lines
in OCTOBER 1946

ALTERATION.

FO'LE FRONT BULKHEAD :- altered as shown in sketch below.

HINGED STEEL DOORS, OPERATED
FROM BOTH SIDES
OPENING 4'-7" x 22", SILL 19"

PLATING $\frac{5}{16}$ " THICK
STIFFENERS $2\frac{1}{2} \times 2\frac{1}{2} \times \frac{5}{16}$
SPACED 36" APART.

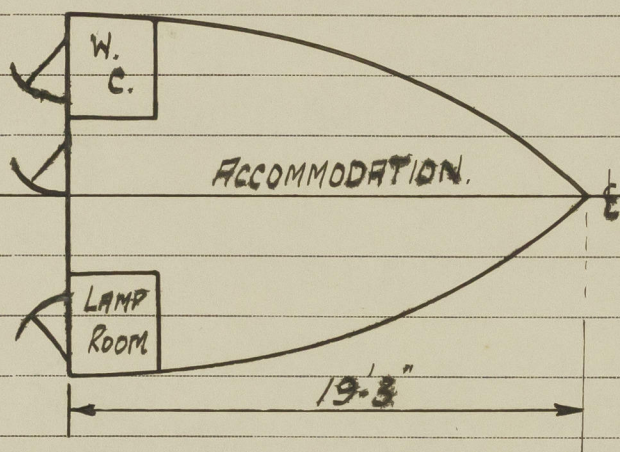

A copy of this report has been attached to the
Load Line Report on board the vessel.

Alexander P. Moon
Surveyor to Lloyd's Register
Glasgow.
October, 1946