


27 NOV 1944

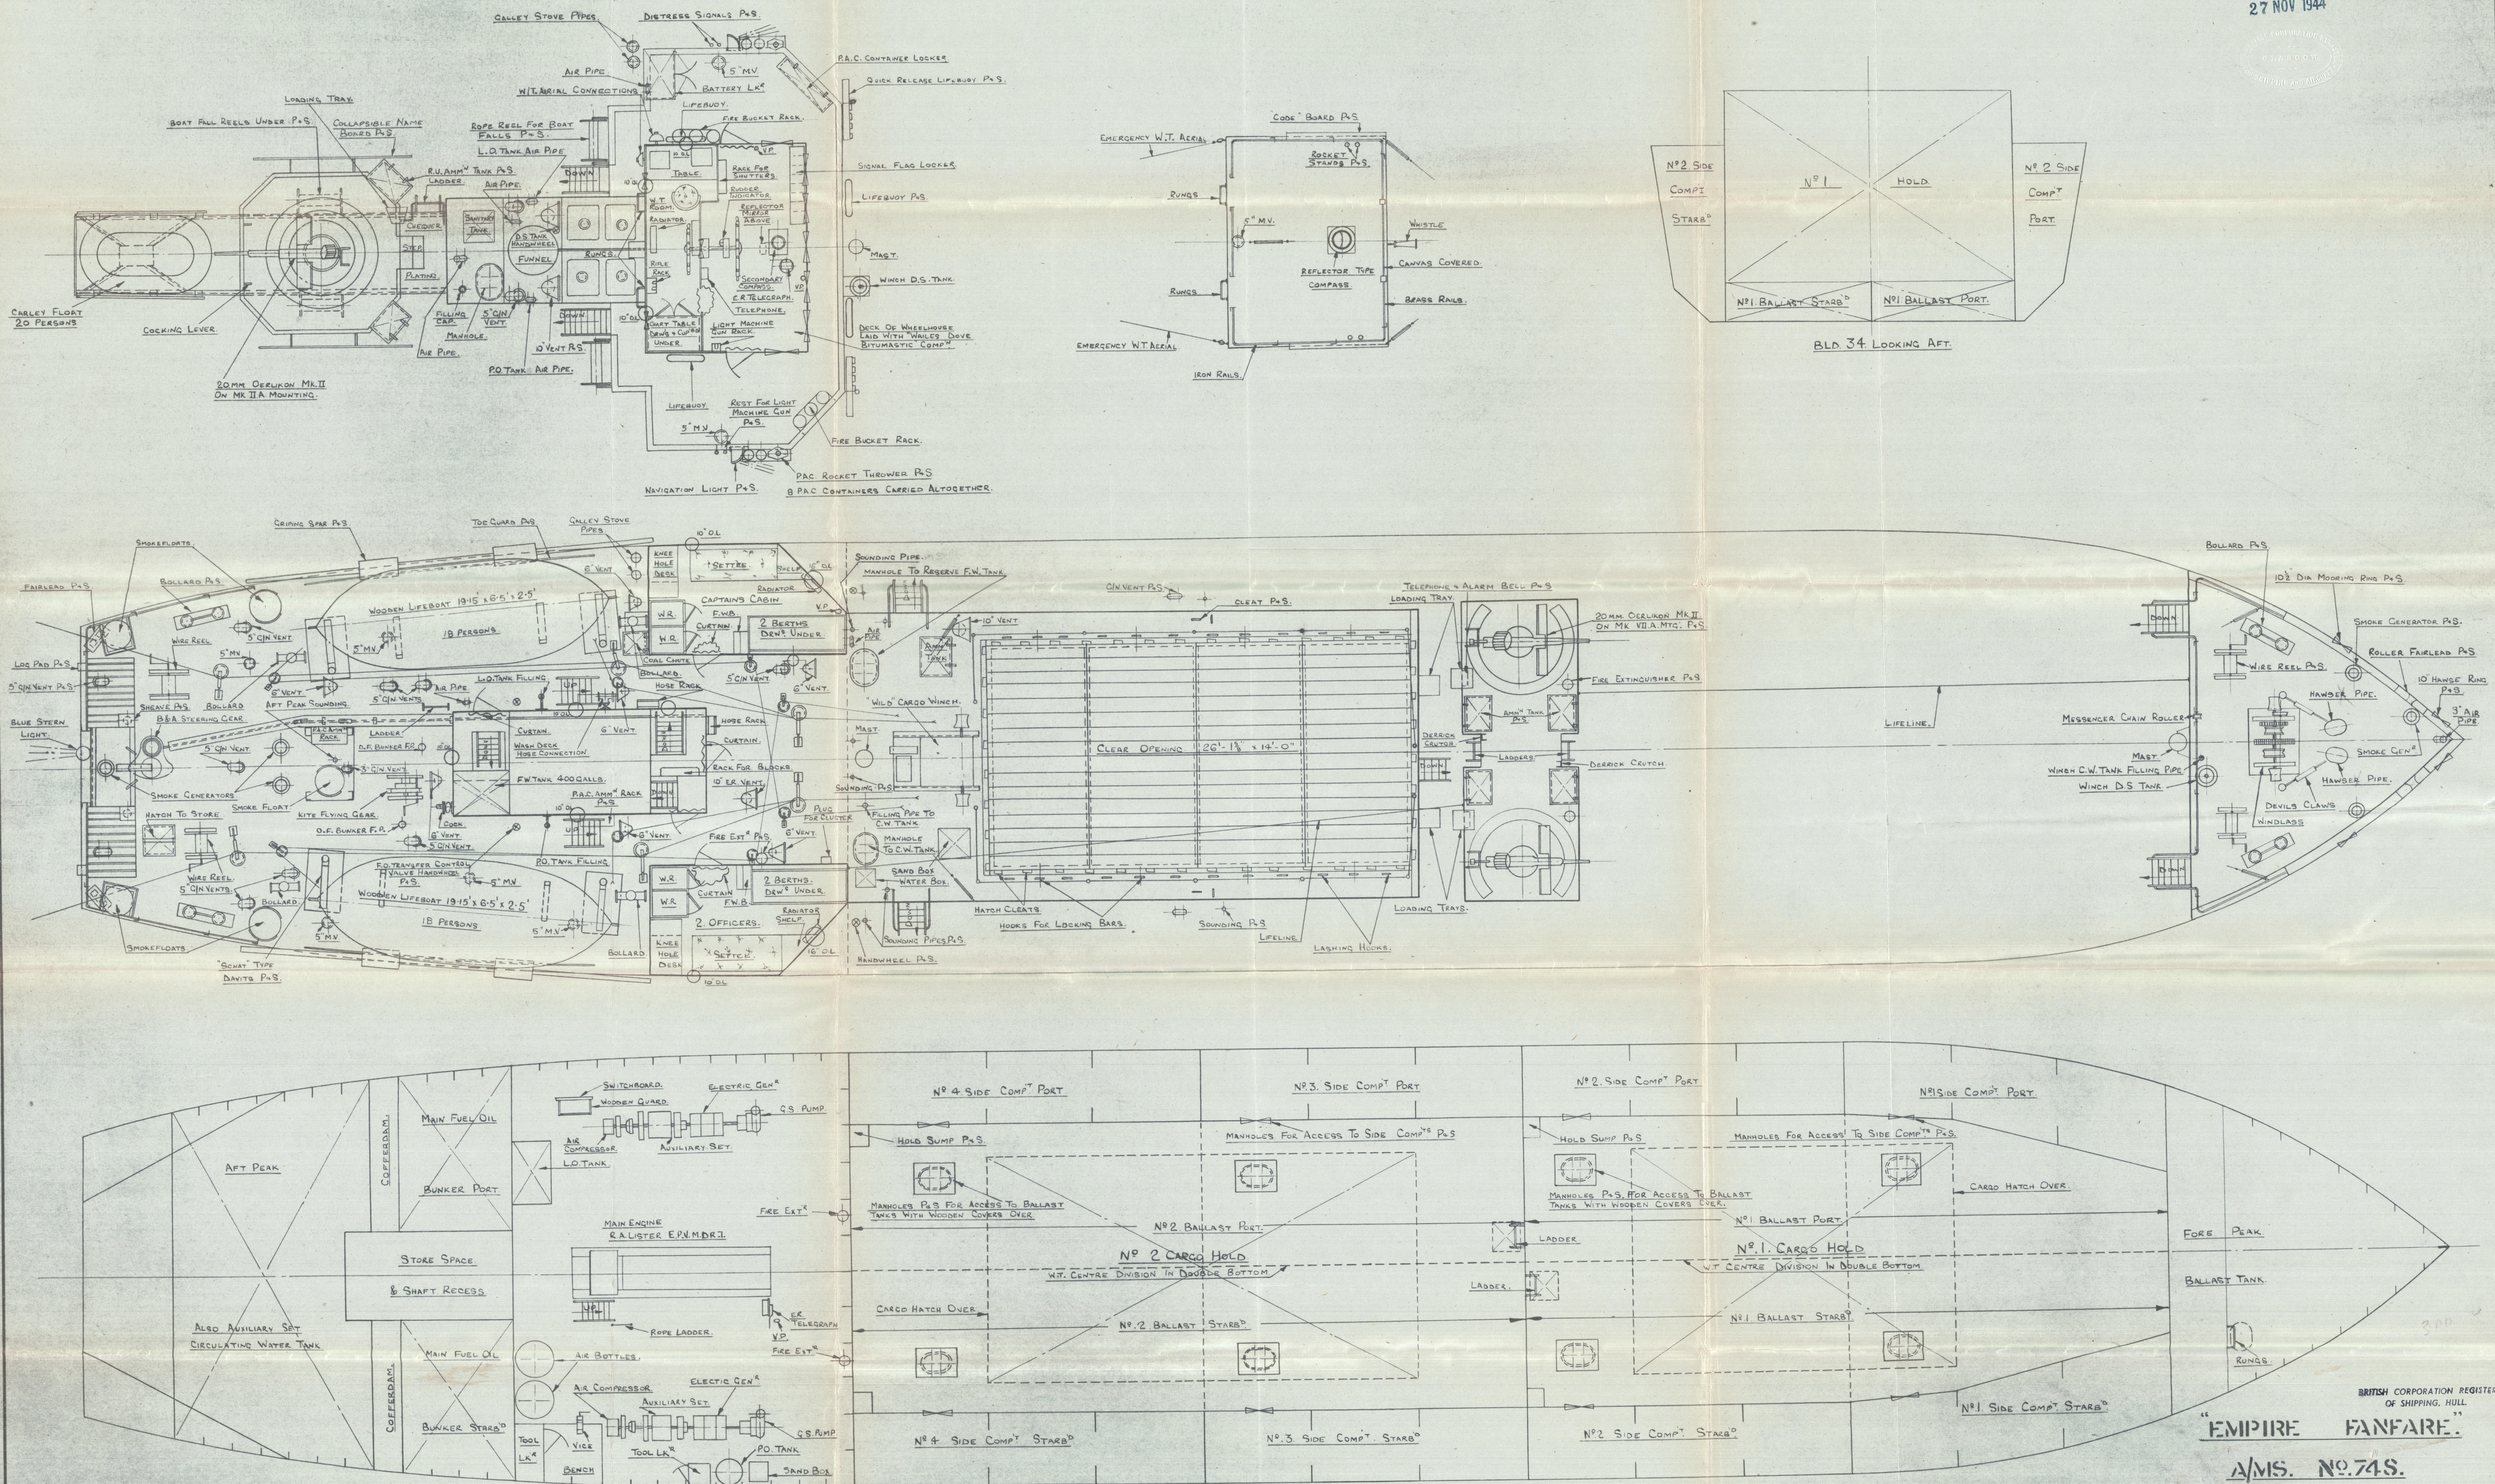

**RICHARD DUNSTON LTD.**  
SHIPBUILDERS,  
THORNE, YORKSHIRE

DRAWN BY	DATE	This Drawing and the Information it contains are the Property of RICHARD DUNSTON LTD. It is not to be Traced, Copied or Published without their Written Consent, nor is the Information thereon to be misused in any way.	
TRACED BY	DATE		
CHECKED BY	DATE	YARD No. 5.452.	
REVISIONS		DRG. No. 4525 / F.6	
No.	DATE	PARTICULARS	
1		TITLE: GENERAL ARRANGEMENT (As Fitted)	
		SCALE: 1/4" TO ONE FOOT	
		SHEET 2.	

002630-002638-0264 Lloyd's Register Foundation



1

General Arrgt - Weeks.

R Dunston Ltd

H. Scarvell No. 1152.

EMPIRE FANFARE <sup>now</sup> FESTIVITY



© 2020

Lloyd's Register  
Foundation

002630-002638-0264