



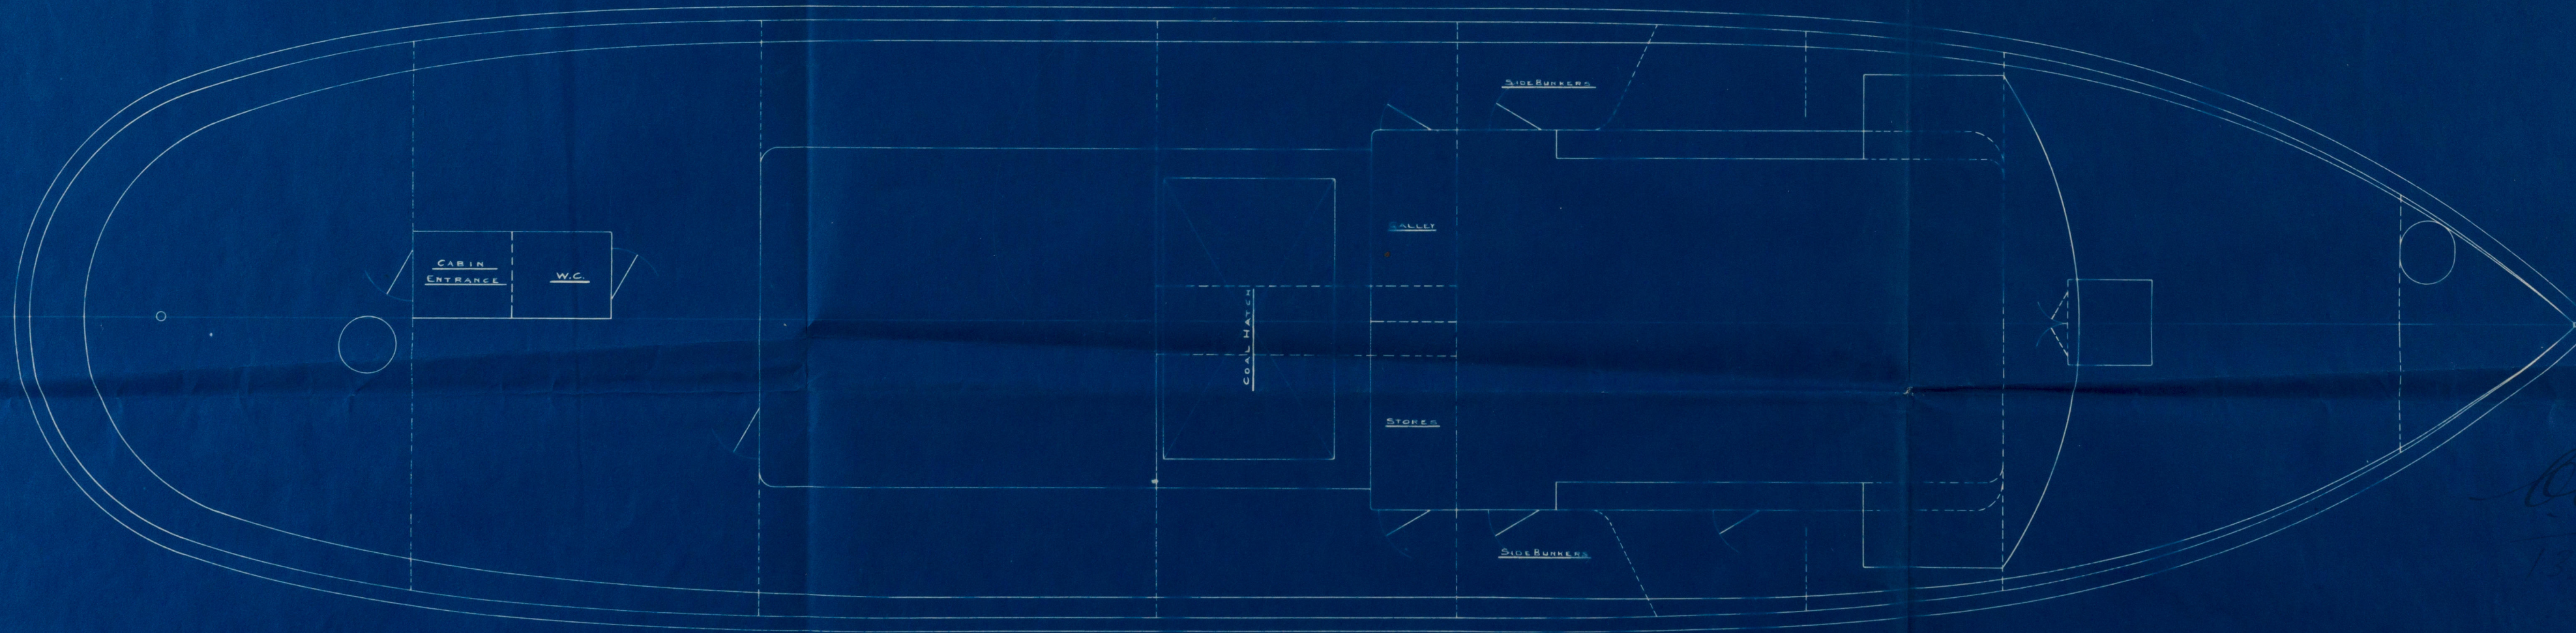

LLOYD'S NUMERALS	
TRANSVERSE NUMBER	31
LONGITUDINAL	2635

SINGLE SCREW STEEL TUG  
LENGTH B.P. 85 FT 0 IN  
BEAM MOULD. 21 FT 0 IN  
DEPTH 10 FT 0 IN  
SCALE 1/4 INCH = 1 FOOT  
CONTRACT NO 51415  
LLOYD'S CLASS 100A1 FOR TOWING PURPOSES

TRACING NO 794

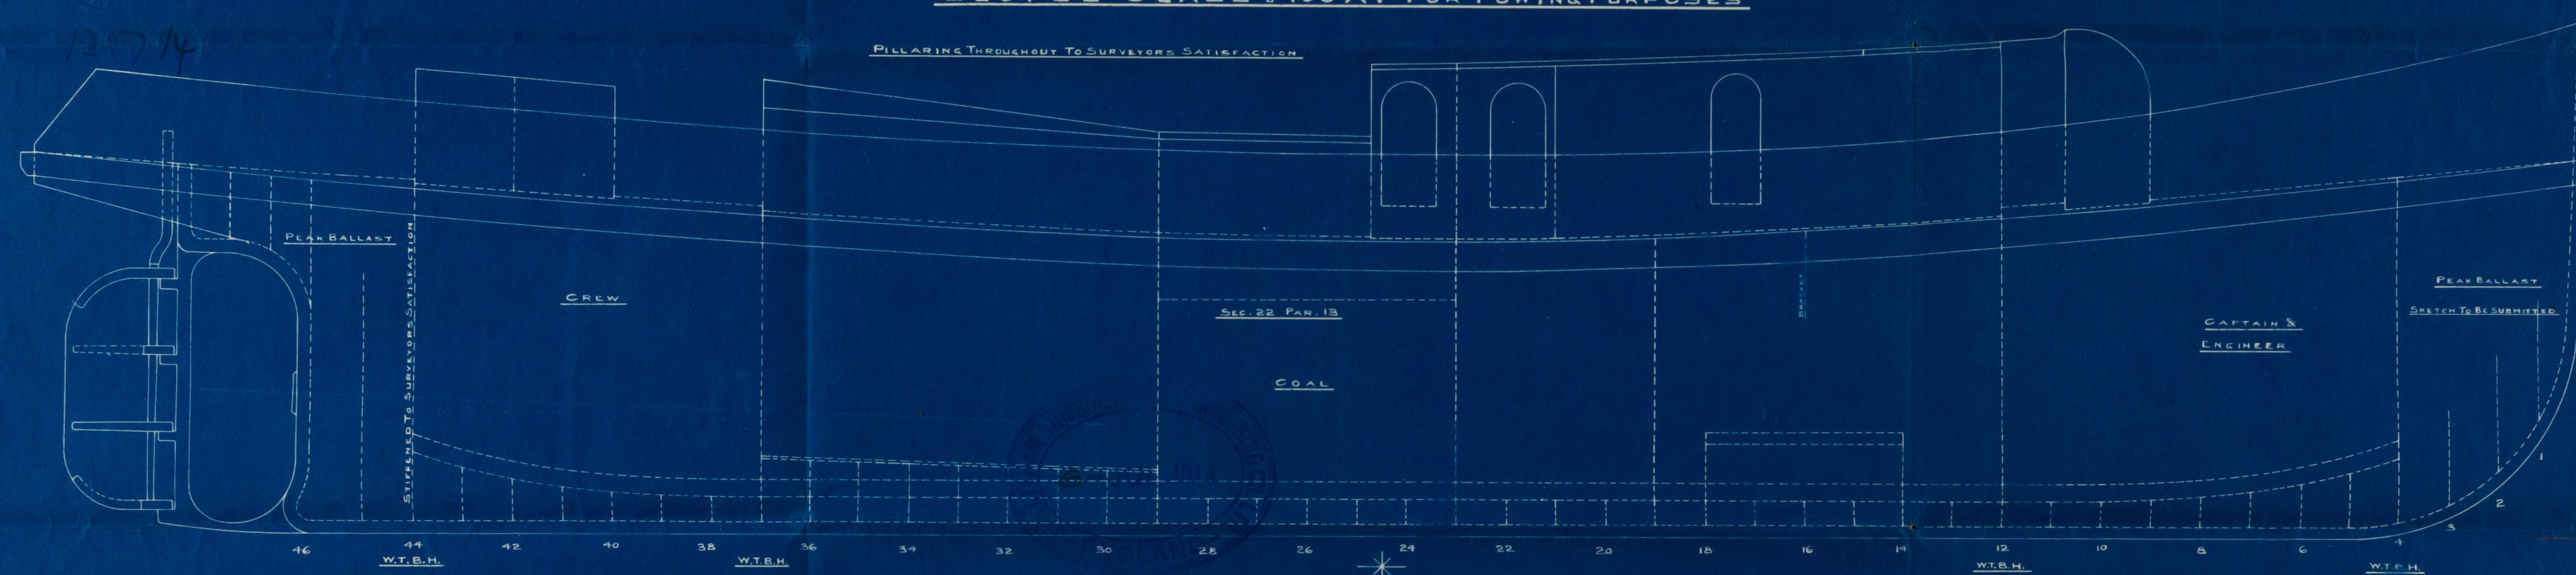

CCP  
13.7.14

John  
17/1/14





*Lytham*

*No 514 '03*

*Profile*

*Danegarth*

*Liv 73749*

*Graygarth*

*Liv 73820.*



© 2020

Lloyd's Register  
Foundation

002639-002646-0078



002639-002646-0078



© 2020

Lloyd's Register  
Foundation