


7.7.10
4.6.10
24.8.10
13.9.10
27.1.11
27.3.11

N^o 139
LONGITUDINAL SECTION
SCALE 1/8 INCH = 1 FOOT

PRINCIPLE DIMENSIONS

LENGTH OVER STEM & STERNPOST AT UPPER DECK	538' 0"
BREADTH MOULDED	44' 0"
DEPTH UPPER DECK BERN AT SIDE TO TOP OF KEEL	20' 0"
CLASS	100 A1 LLOYDS

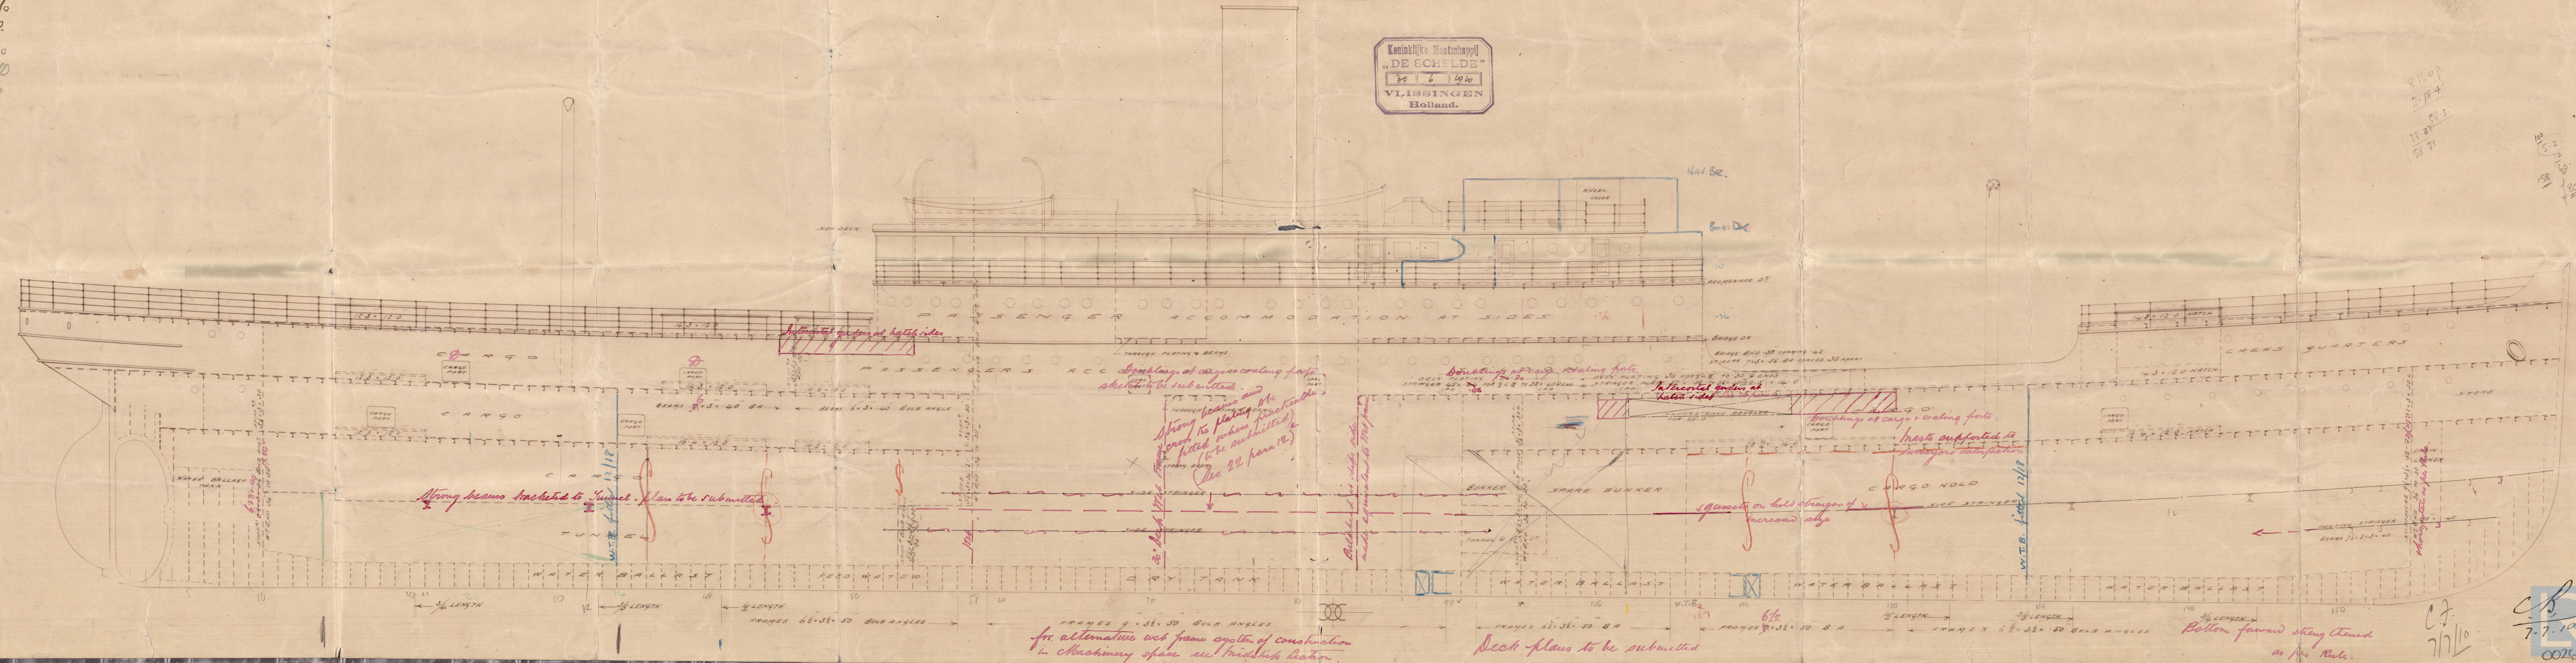


8/10
2-184
33 27 52 3
58 33

138
139
140
141
142
143
144
145
146
147
148
149
150

for alternative web frame system of construction in machinery space see midship section

Deck plans to be submitted



Bottom forward string framed as per Rule.

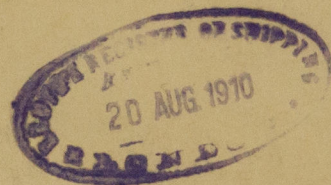

© 2020



Lloyd's Register
Foundation

Corintheu

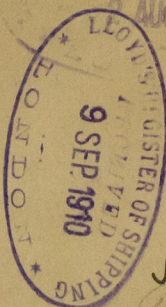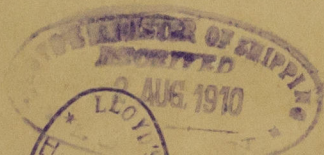

S. S. Grange nasfan
Profeta Dean.

Pydolan report no. 1254

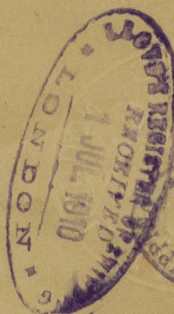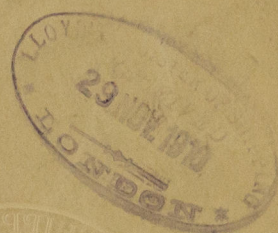

002639-002646-0101



© 2020

Lloyd's Register
Foundation