

R.C.

Speed 33 Knots at sea.

Hand-drawn technical drawing of a boat's transom and rudder assembly. The drawing shows the transom with a rudder post and rudder blade. Dimensions are given in inches. Annotations include "Rudder frame", "Rudder post", "Panama hole for fitting eyebolt for derrick and out pulley. 1/2 brass stud fitted when eyebolt not in use", and "5 3/8 brass studs sticking in one piece". The drawing is labeled "Fig. 1".

[illegible]

Brass key at back  
tighten bush.

Section at C. P.



C. J.  
4/8/10



S. P. Graue nasau.

<sup>u</sup>  
Rotterdam report. no. 7249

Plan of. Rudder and Lignframe.

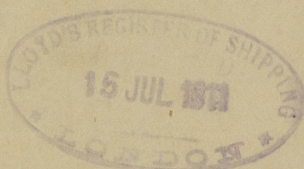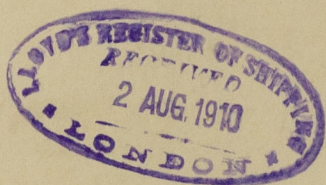

002639-002646-0102



© 2020

Lloyd's Register  
Foundation