




NOTE: GENERAL SERVICE PUMP TO BE DISCONNECTED FROM BILGE MAIN.
 ALL SUCTION VALVES ON OIL FUEL TANKS TO BE CONTROLLED FROM DECK.
 ALL EXISTING LEAD PIPES IN STOKES & ENG. ROOM TO BE REPLACED BY M.S. PIPES.
 STEAM STOP VALVE FOR ENG. TO BE CONTROLLED FROM DECK.

ARRANGEMENT OF OIL FUEL PIPES & STEAM TO OF AUXILIARIES & FIRE EXTINGUISHING PIPES.

SCALE: 1/8" = 1 FOOT.
 S.S. ARNEWOOD.
 S.S. DASHWOOD.
 JOHN READHEAD & SONS LTD.
 SOUTH SHIELDS.

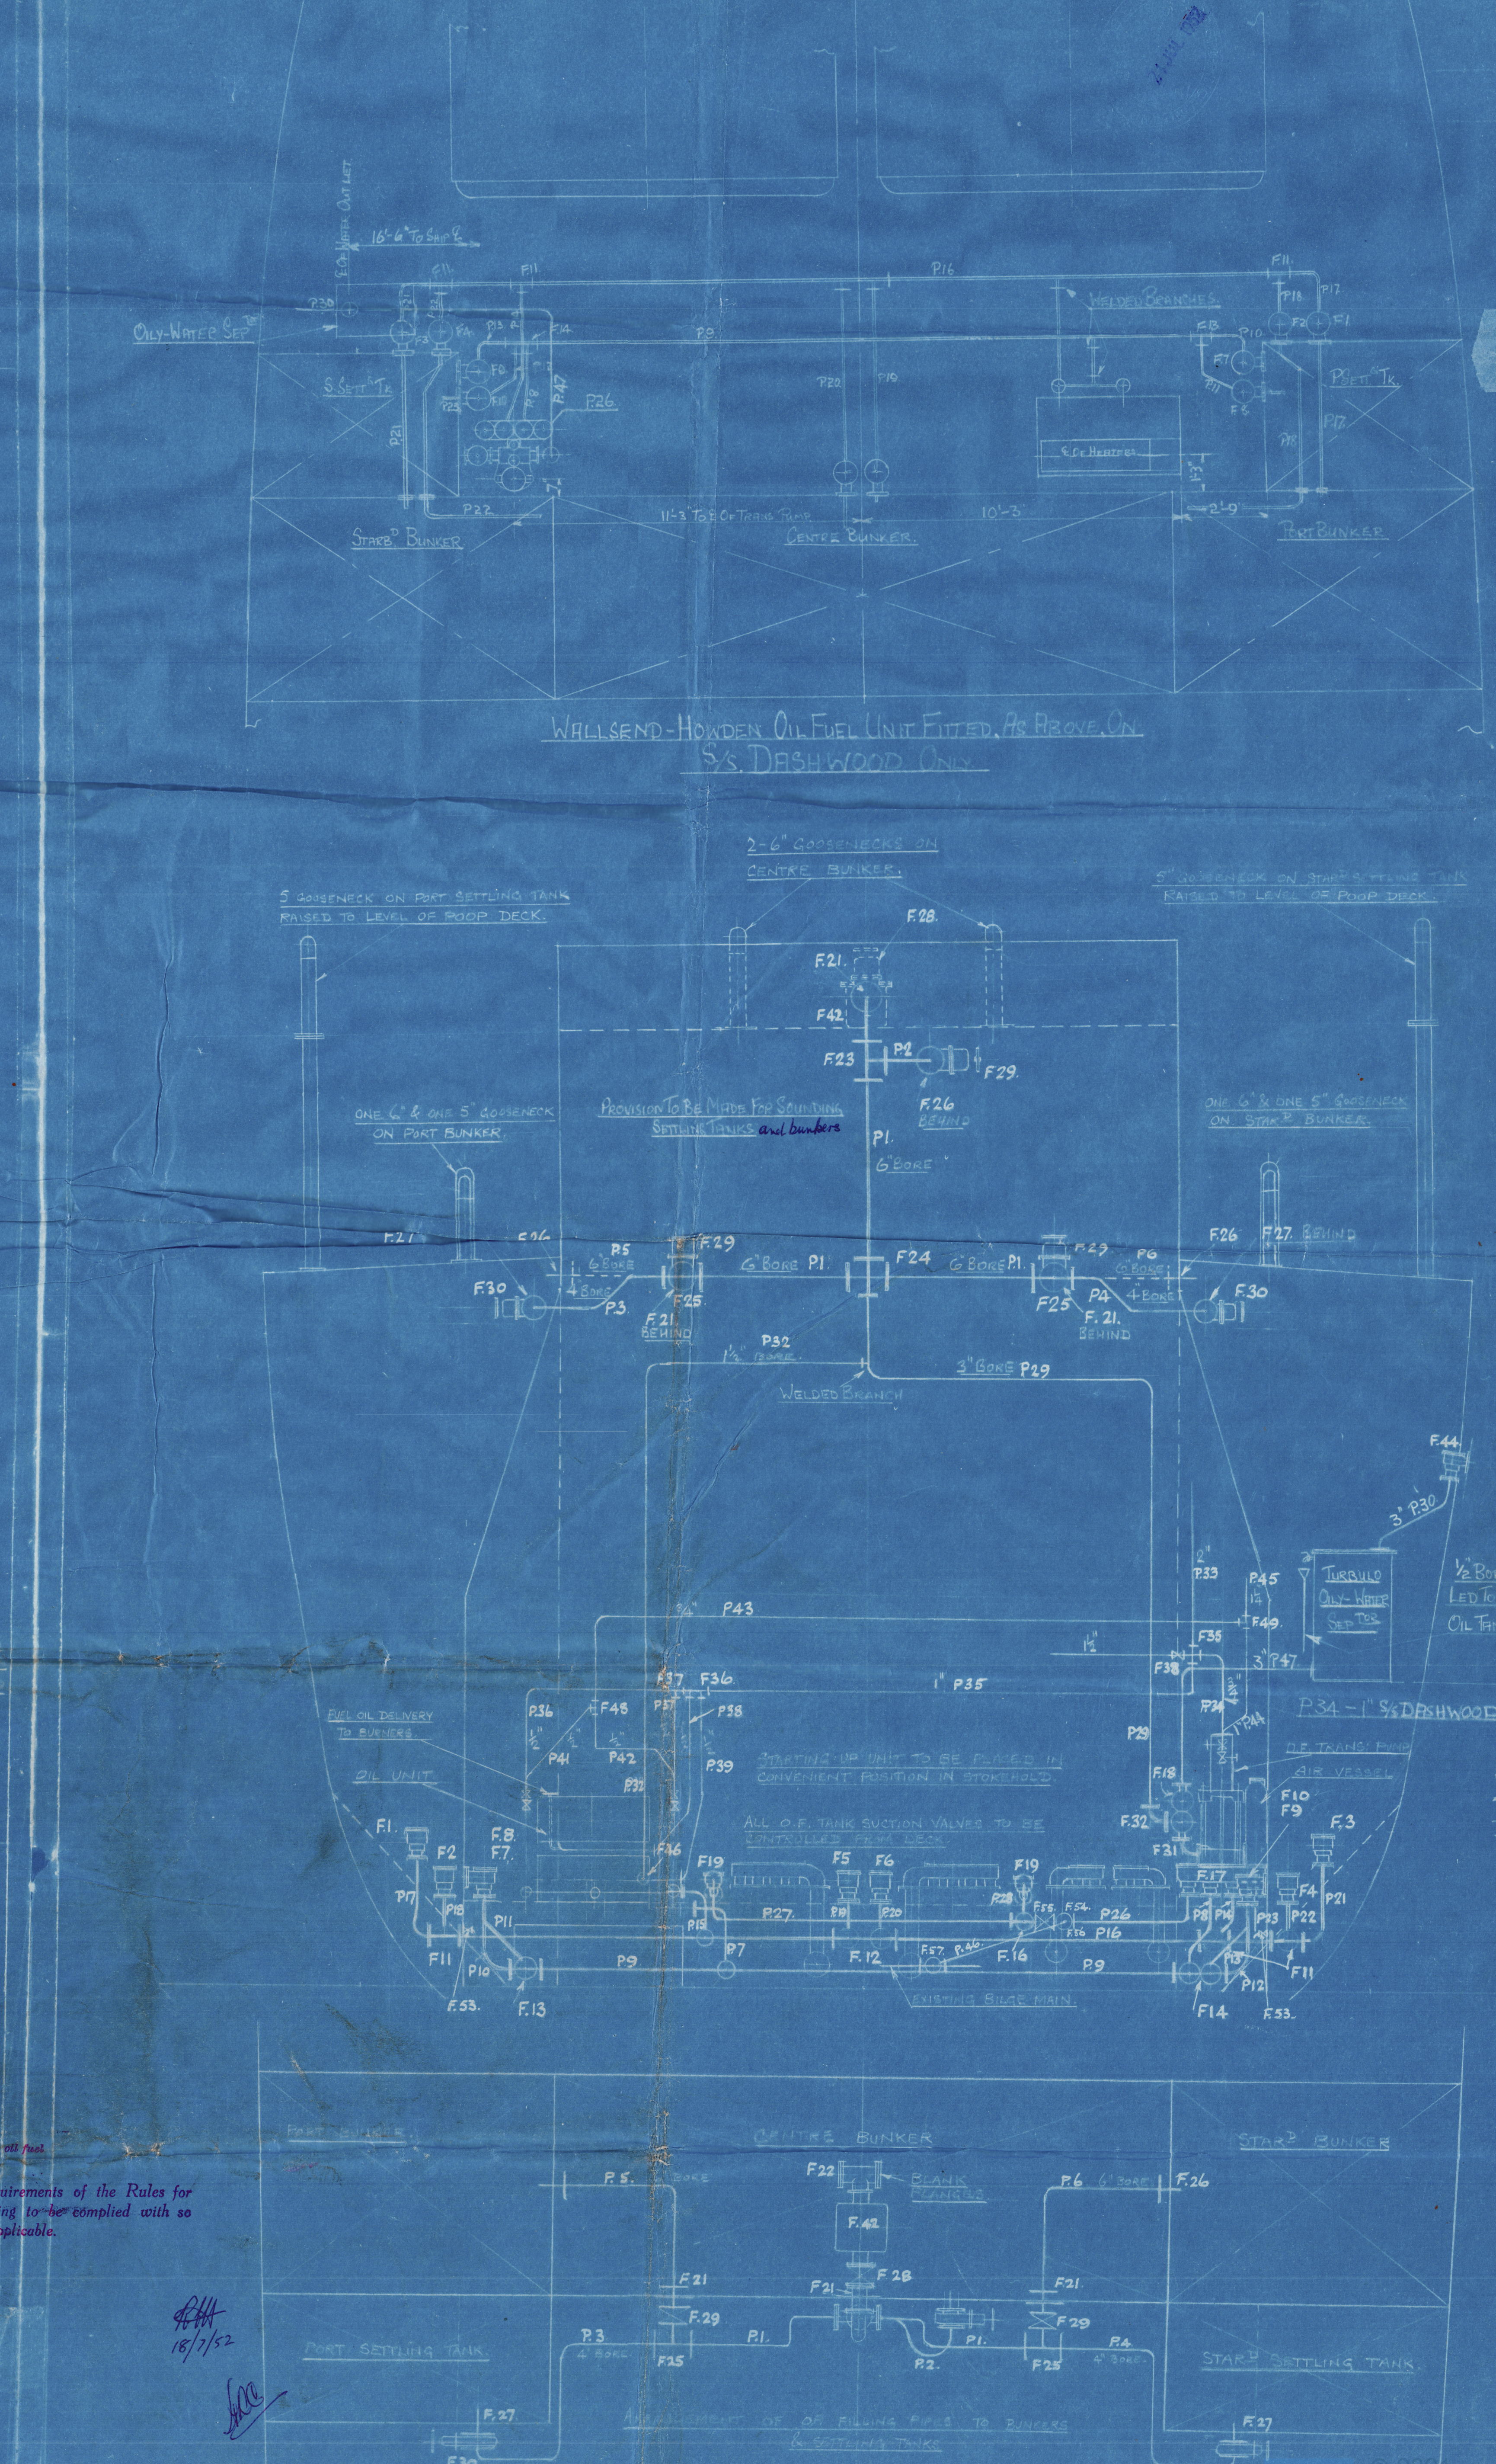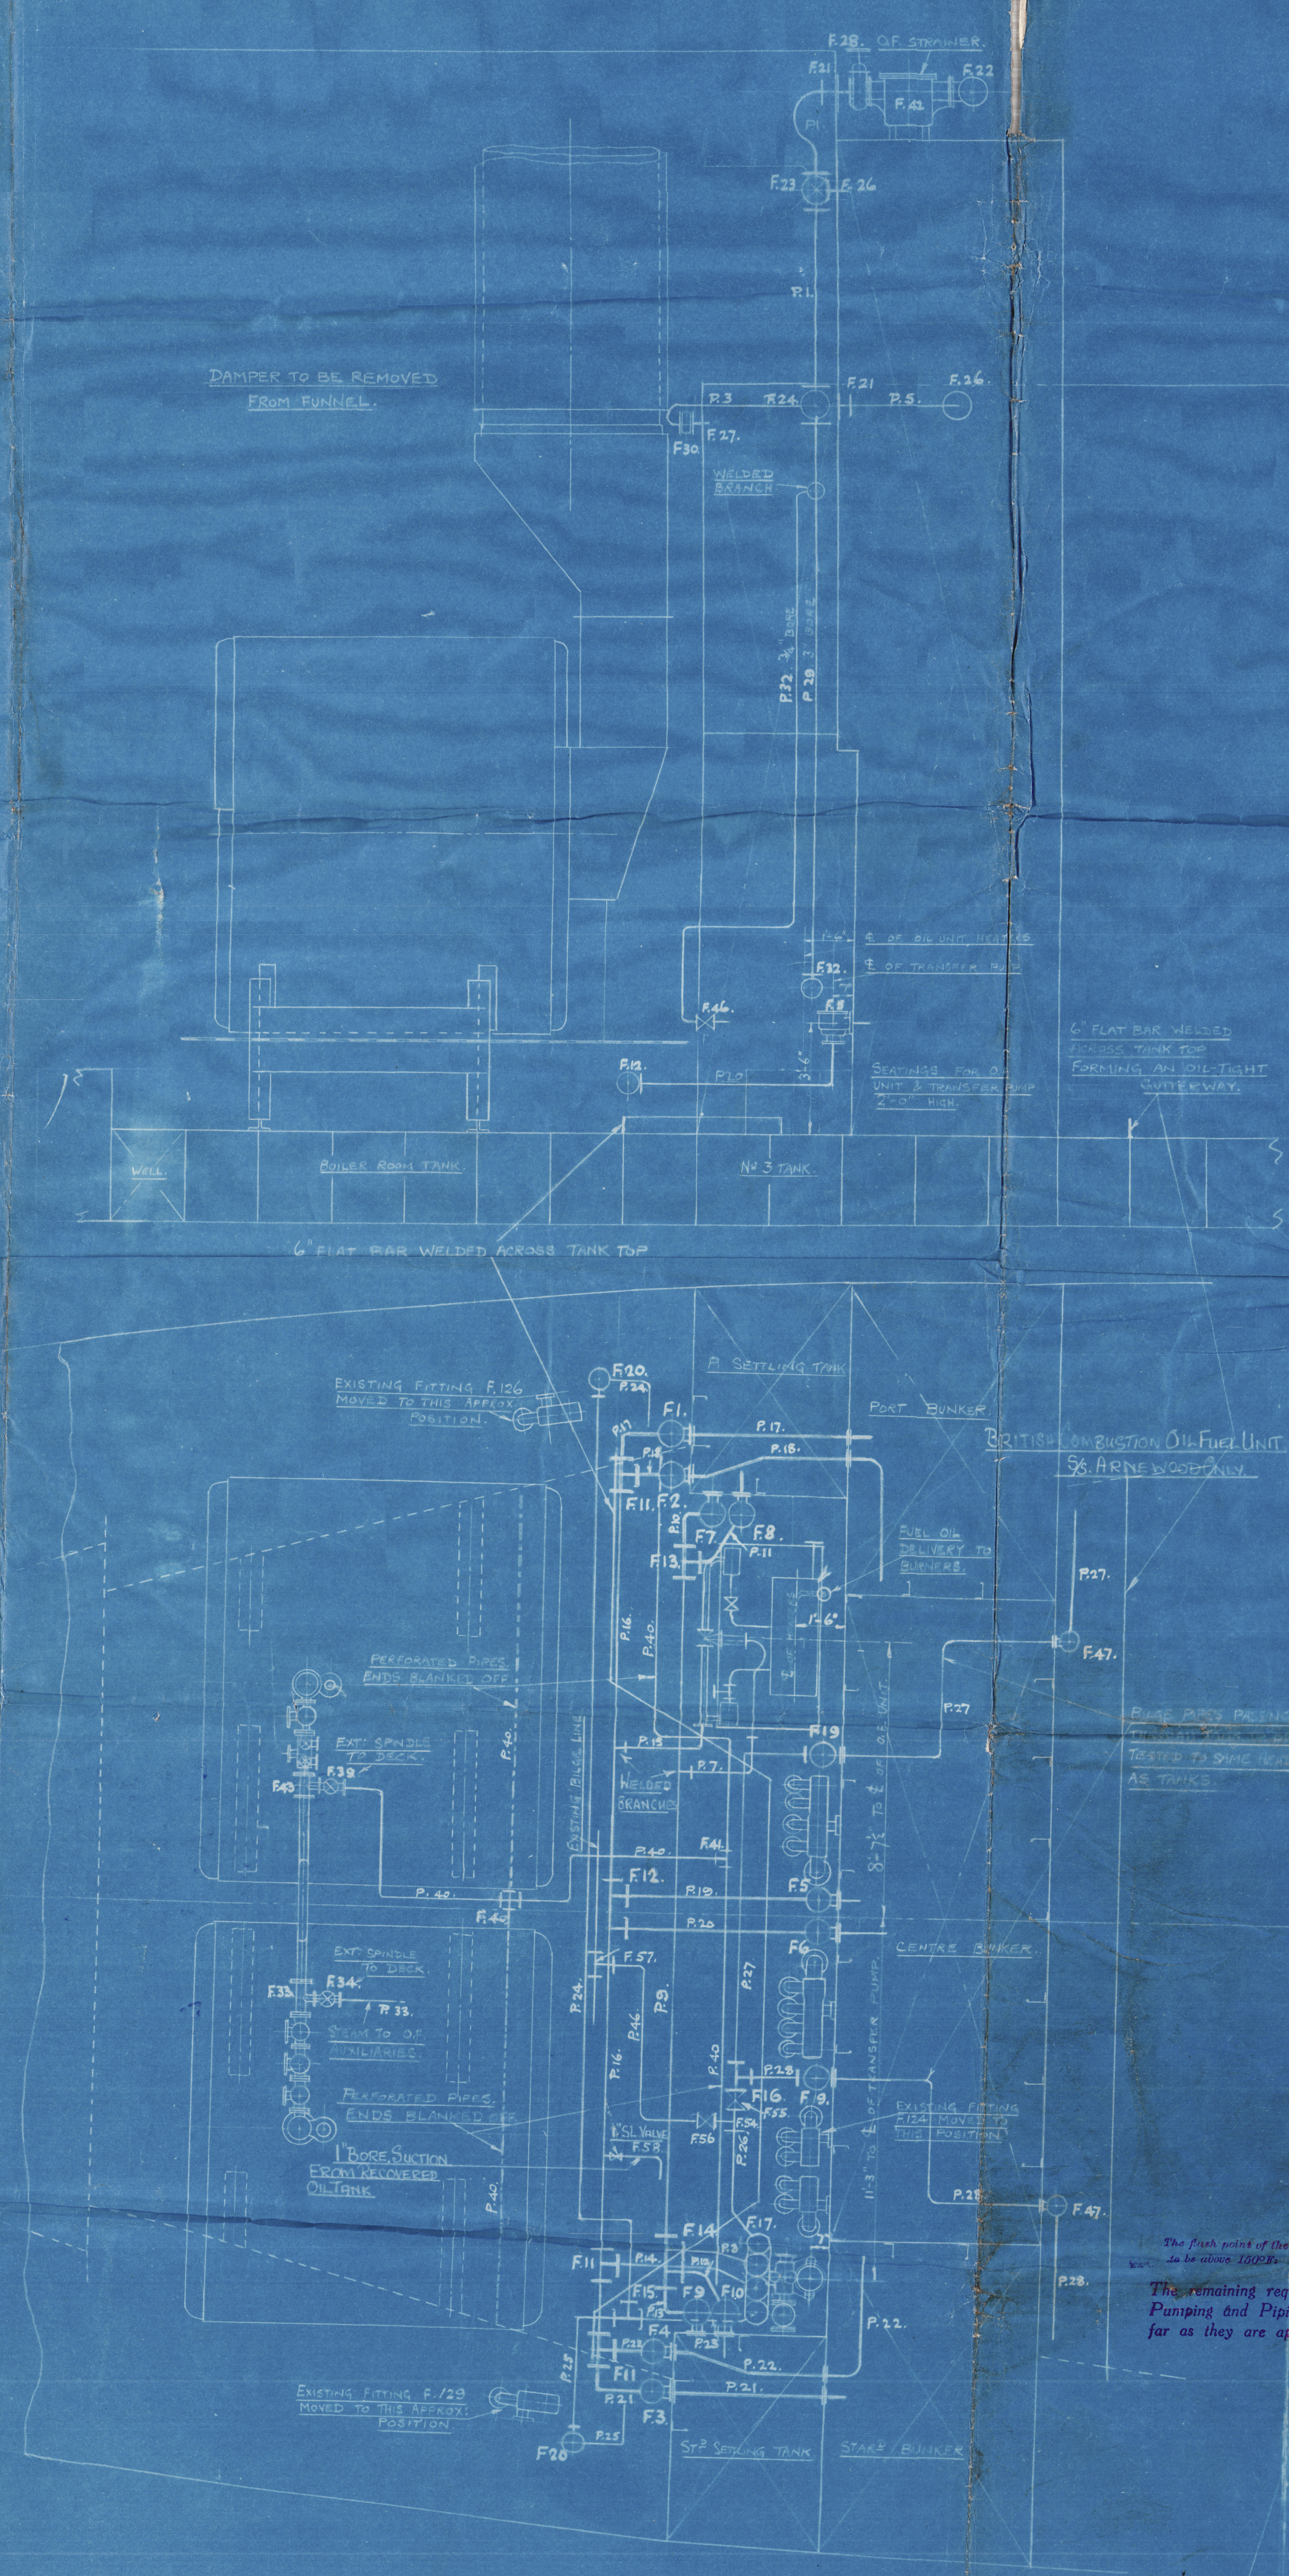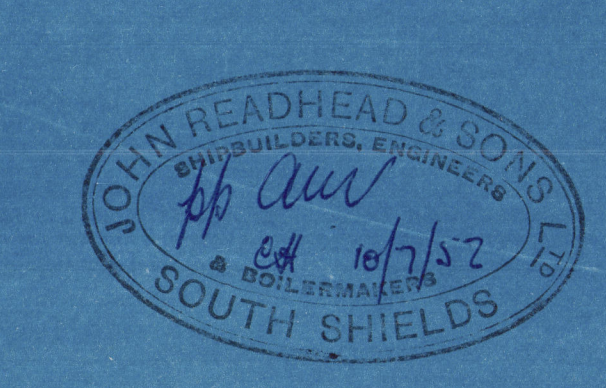


SS Deeshwood.

Arrangement of O.F. Pipes
and Steam to O.F. auxiliaries
and Fire Extinguishing Pipe

approved. 21. 7. 52


(John Readhead & Sons Ltd
South Shields)

NEWCASTLE-ON-TYNE, No 109490

TO ACCOMPANY..... N.W.C. REPORT No. 10972

DATED..... 9. 52

002647-002652-0048

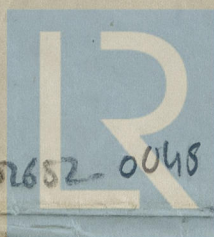

© 2021

Lloyd's Register
Foundation