


Lloyd's Register of Shipping. SWS 22920.

Ship's Name "NORTHLEIGH"

Official No. 165543

Memorandum of alterations reported since ship was surveyed for assignment of Load Lines in 1934.

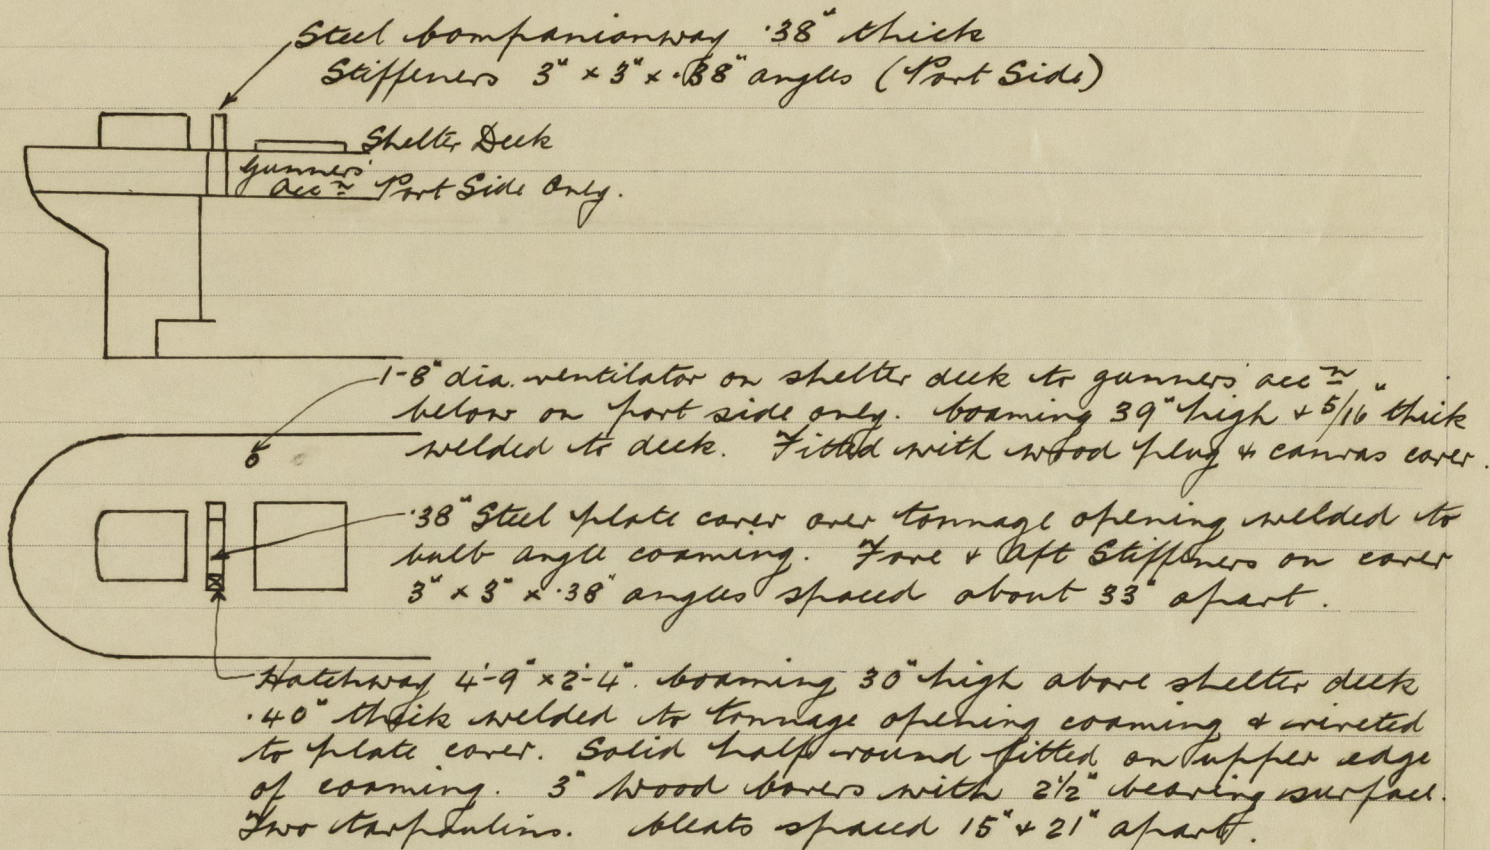

Entrance to gunner's accommodation in companionway on port side only (inboard side) Solid wood door with 28" coaming above shelter deck. Side Scuttles to gunner's accomⁿ on port side only. 4-9" dia. of substantial construction & fitted with hinged deadlights. About 2'-0" below shelter deck.

1- Sanitary discharge from gunner's accommodation on port side only fitted with bronze storm valve and gate valve controlled from shelter deck.

Freeing ports in tonnage well and all overboard scuppers from shelter tween decks permanently closed.

Lifelines and suitable end attachments provided.

Scuppers provided from shelter tween decks to bilges on each side of ship at after end of engine space and immediately forward of boiler room.

Forecastle End Bulkhead closing appliances.

5 Hinged Steel Doors Manipulated from both sides.

Size of Opening = 4'-3" x 1'-10". Height of sill = 18"

2 Hinged Wood Doors Manipulated from both sides

Size of Opening = 4'-3" x 2'-10". Height of sill = 18"

Noted

W.B.

9/3/42

In Wake

Swansea 5th March 1942