


DETAIL SKETCH OF  
PINTLE.

23.2.15  
16.5.16 (244)


SPLIT PIN

# RUDDER S.S. N° 242.

SCALE 1"=1'00"

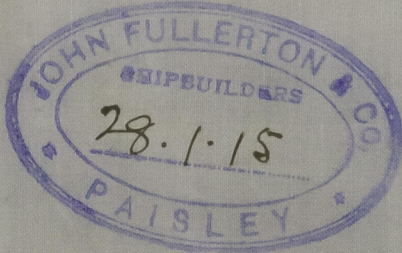

STOP ON TOP PINTLE (ONLY.)

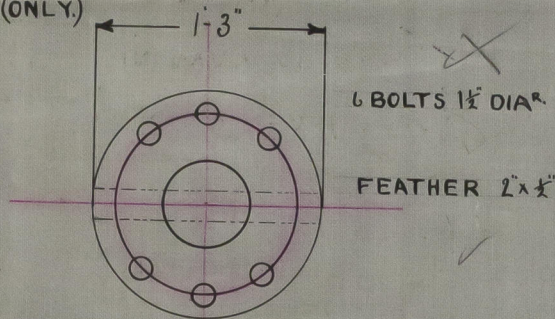

5 1/4  
5  
5  
DIA.  
DIA.  
DIA.

see below for  
speed

10  
SPEED UNDER 10 KNOTS.

AREA OF RUDDER 45.48 SQ. FT.

A x D = 100.05.

3 1/2 x 1"  
RIVETS 1 1/8 DIA.  
SPACED 4 1/2 DIA. APART.

C.G.


2'-2 1/2"

4  
P<sub>1</sub> 82 (REDUCED OWING TO ARMS,  
BEING SPACED ONLY 45"  
INSTEAD OF 52")

STOCK INCREASED 10%  
IN WAY OF ARMS.  
AS PER RULE.

Arms spaced  
closed, reduction  
in size of same  
due thickness of plate  
might be allowed

16.5.16  
20/1/15

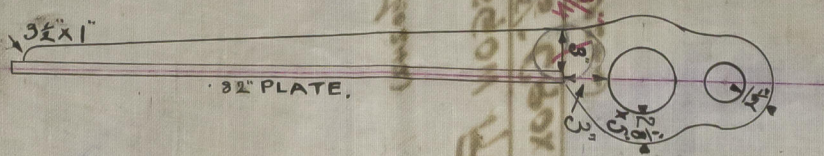

16.5.16  
20/1/15



© 2020  
Lloyd's Register  
Foundation



Rudder  
J Fullertons  
17<sup>th</sup> 24<sup>th</sup> 74.

---

GLASGOW REPORT No 371874

(No 242) 9<sup>th</sup> Aigburth

GLASGOW REPORT No 37610

5<sup>th</sup> CROXTETH:

(No 244)

DAUGARTH FORCE



© 2020

Lloyd's Register  
Foundation

002658-002658-0023