



1-2-15  
23-2-15  
16-5-16 (244)

BRIDGE LENS 15 3/10  
2. COXLEY  
3. COXLEY  
not marked  
1. 1/2  
2. 1/2  
S.S. N° 242

195' 0" x 31' 0" x 14' 0" M.P.  
TO CLASS 100 A.1. AT LLOYDS & BUILT UNDER SPECIAL SURVEY.  
SCALE 1/4" = ONE FOOT.

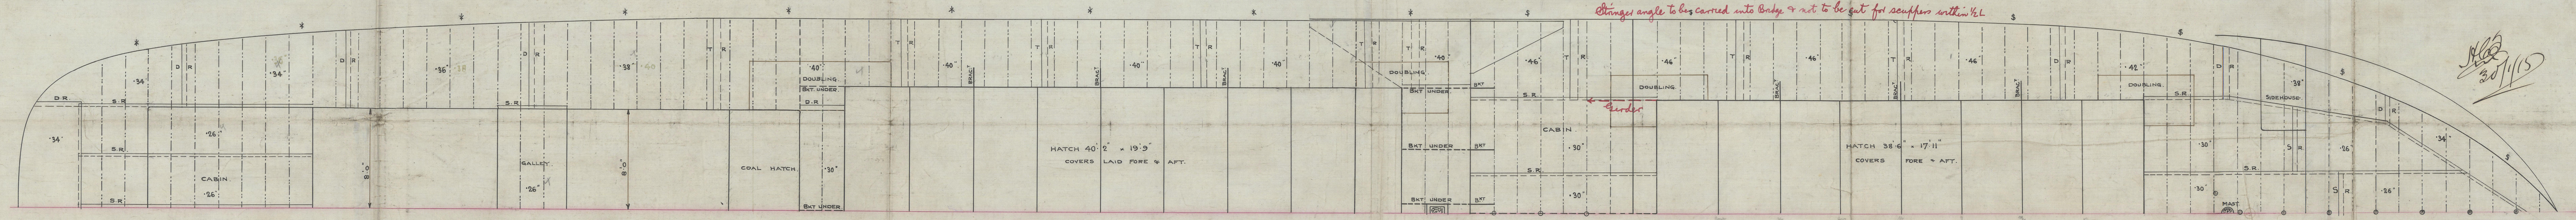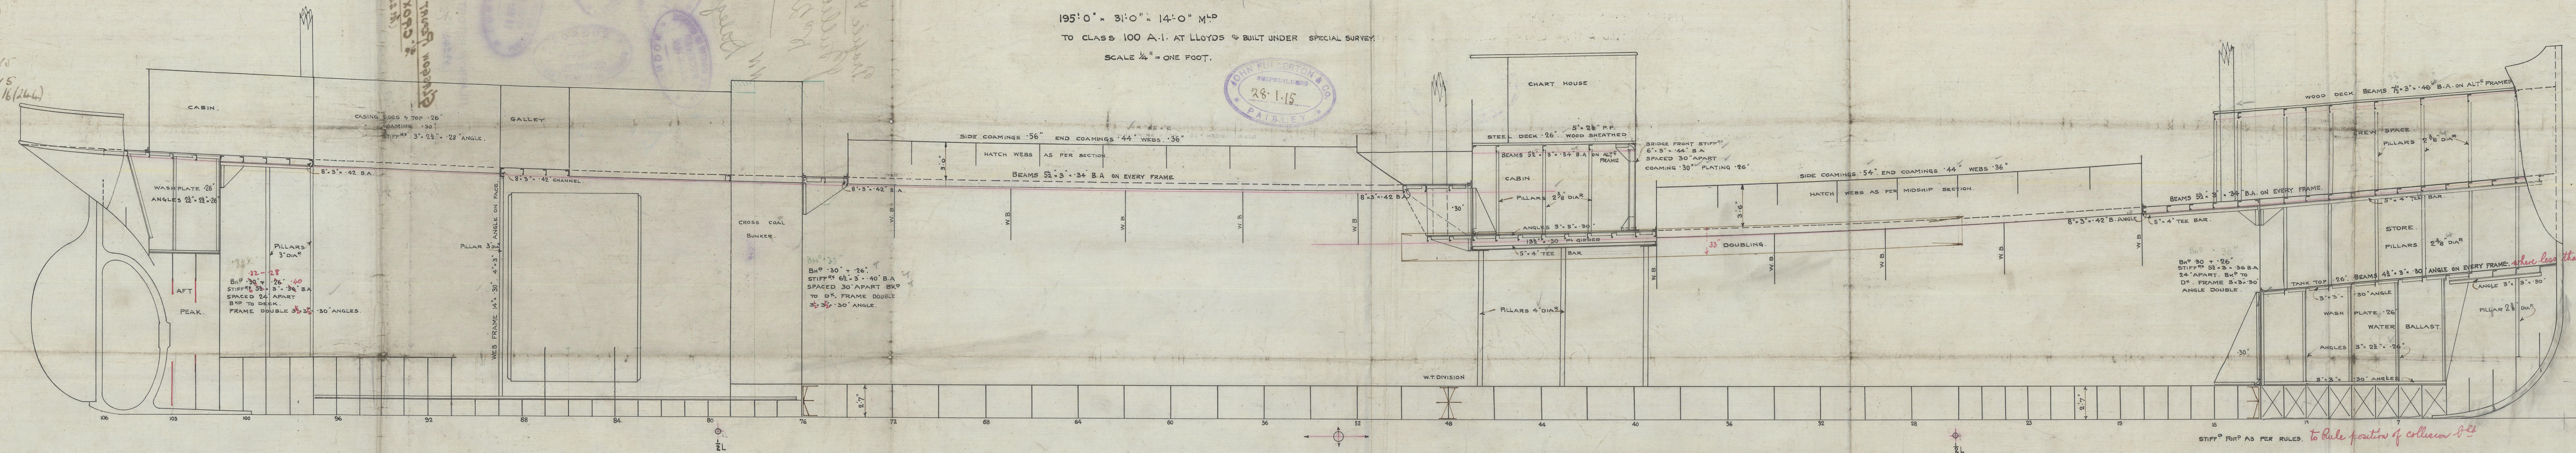

Changes angle to be carried into Bridge & not to be cut for scuppers within 1/2 L

20/1/15



16-5-16  
15-2-15



Profile & Deck plan  
of Fullerton H<sup>o</sup>  
N<sup>o</sup> 242 + L.

NN

Dalegarth Force

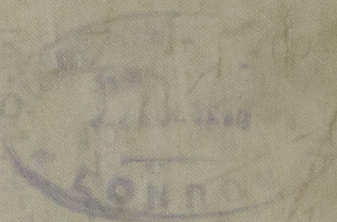 

GLASGOW REPORT No 34181 +  
No 242 1/2 CROXTETH  
GLASGOW REPORT No 34610  
1/2 CROXTETH.  
(No 244)

002653 002653 10074