




17/1/19

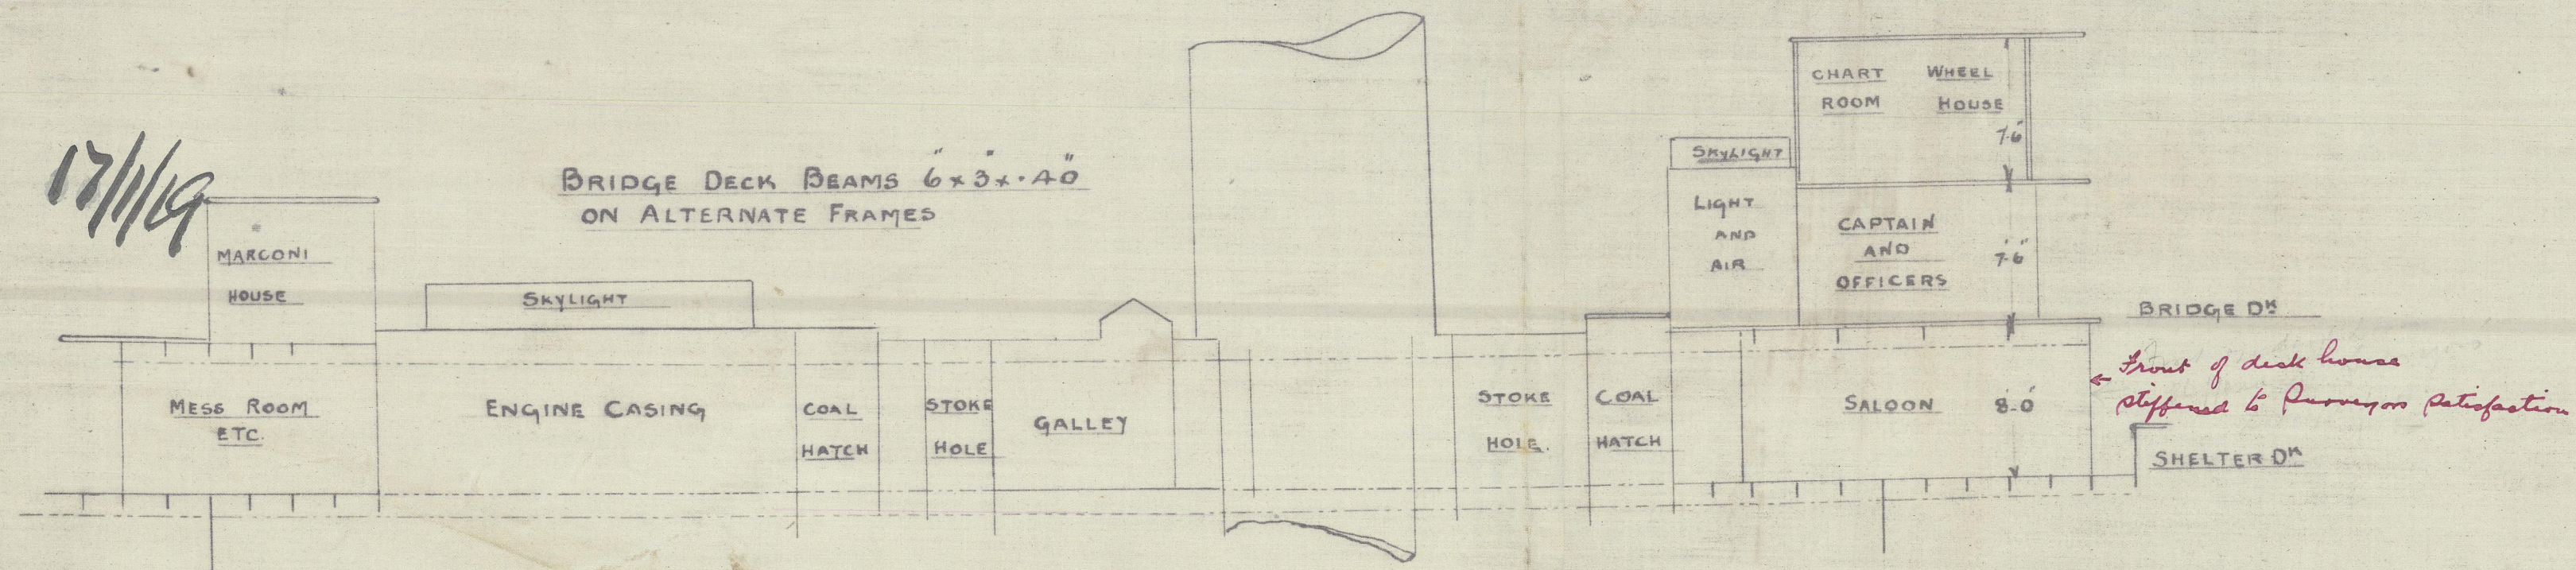

ELEVATION

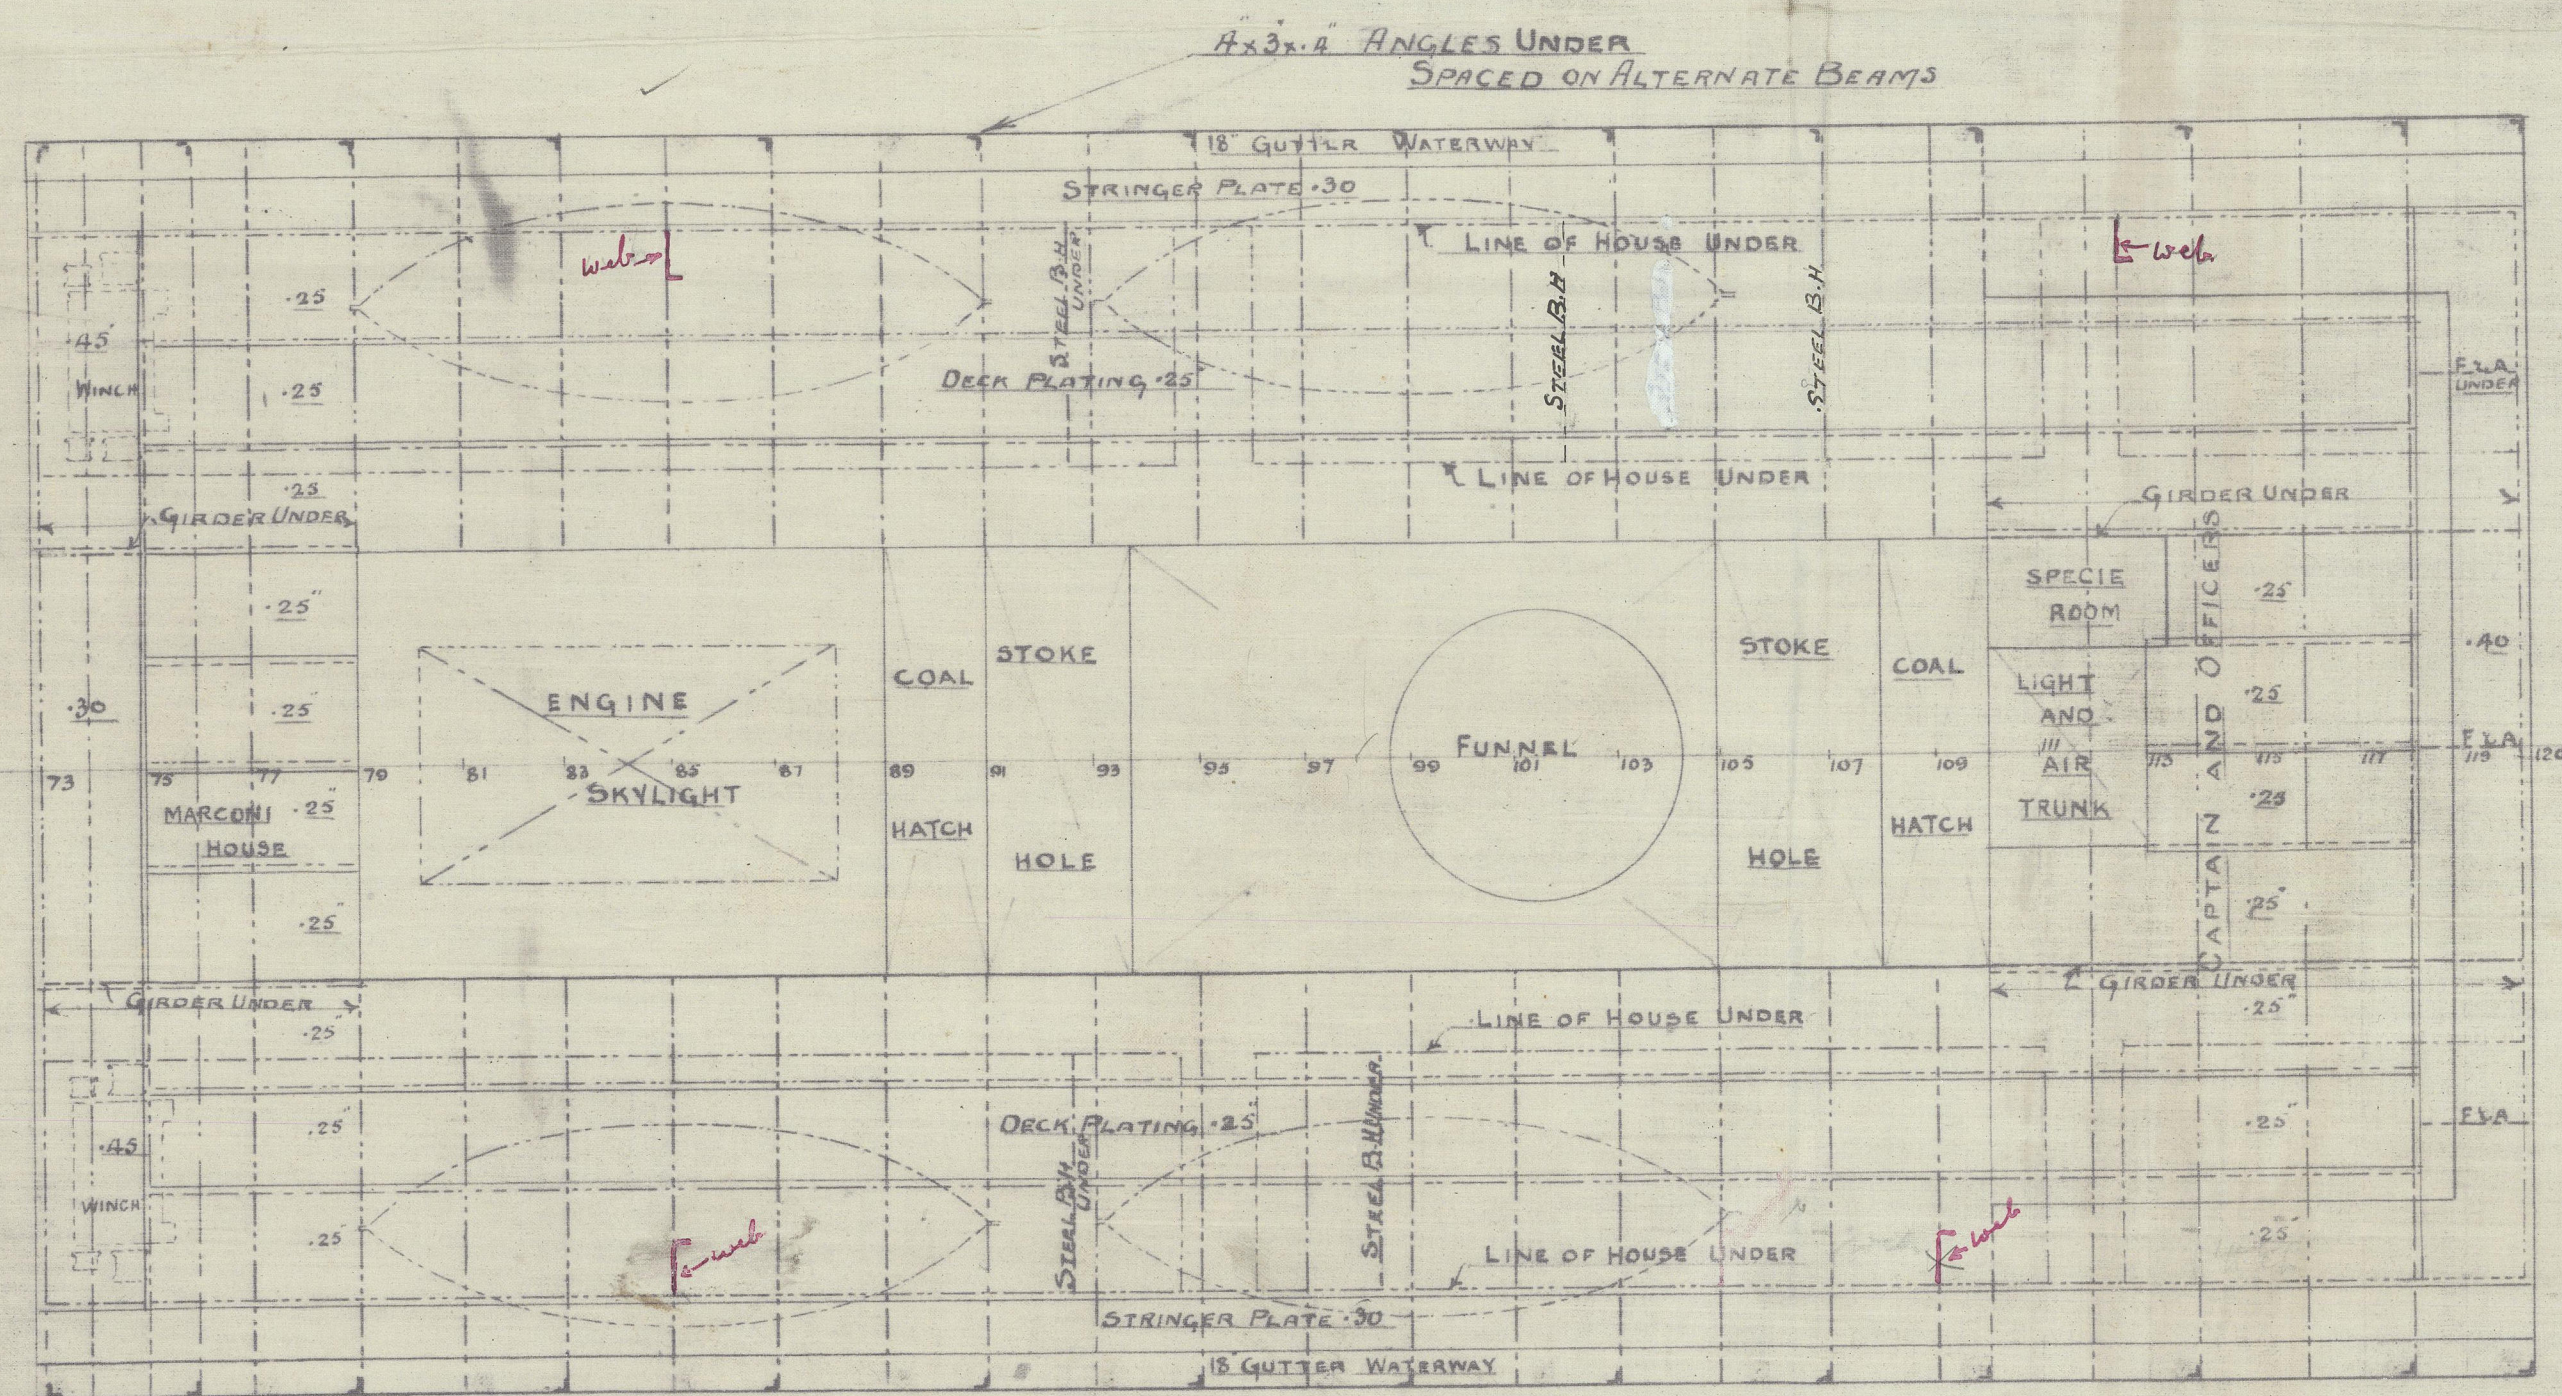

PLAN

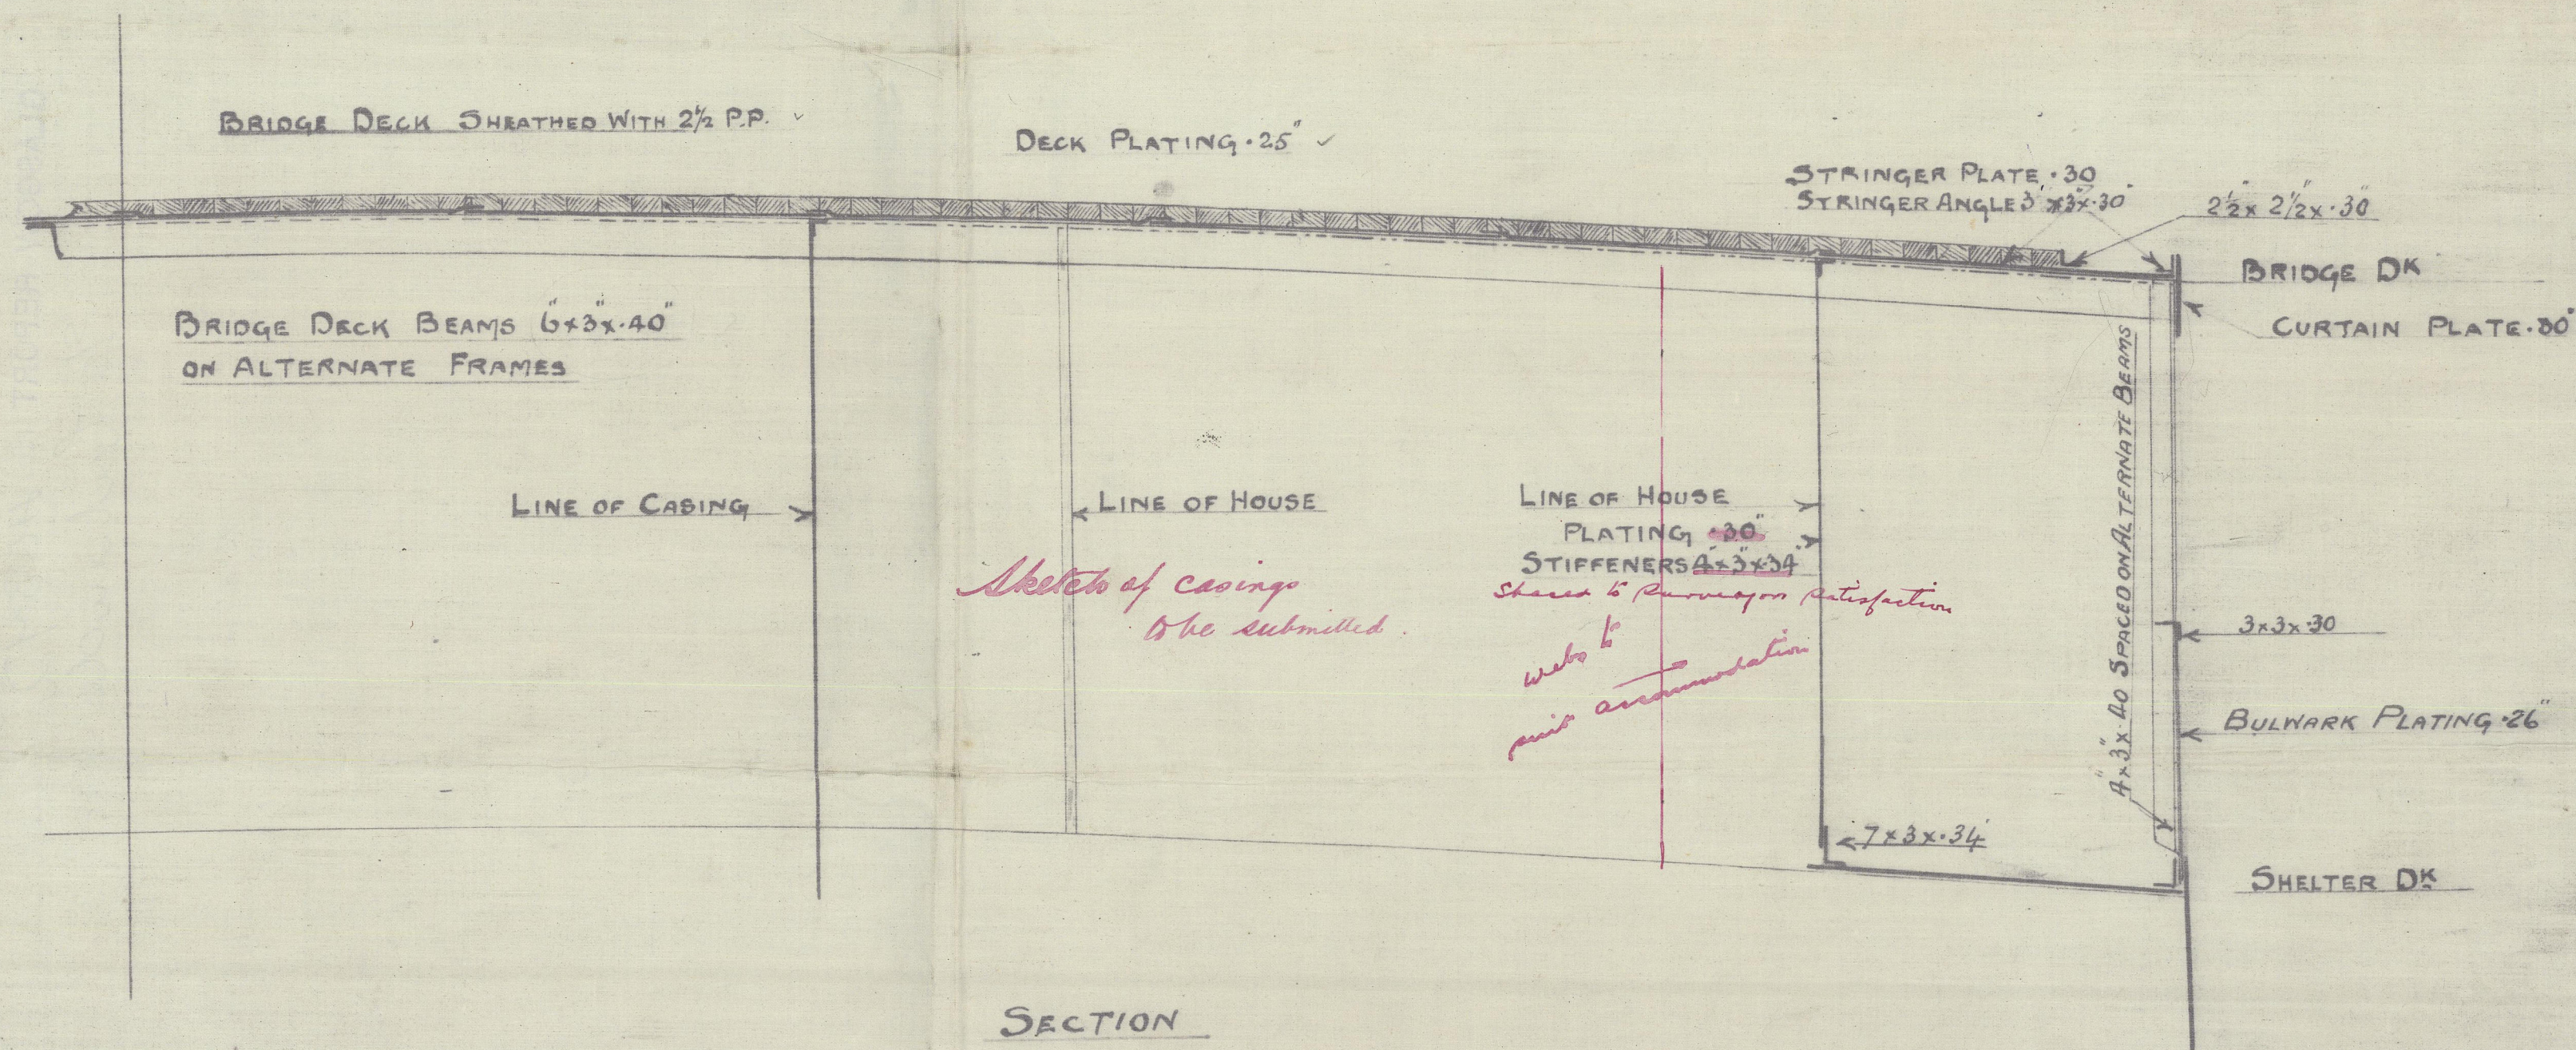

SECTION

No 503
BRIDGE DECK PLAN
SCALE 1/8" = 1 FT

C.T.
17.1.19



N^o 503

Budn Dead Plan

Don Henderson & Co



GLASGOW REPORT No. 40342
s/s Lalande.



© 2020

Lloyd's Register
Foundation

002653-002658-0090