


3.3.19


# HOLD BALLAST TANK

S.S. N° 503


SCALE 4" = 100'

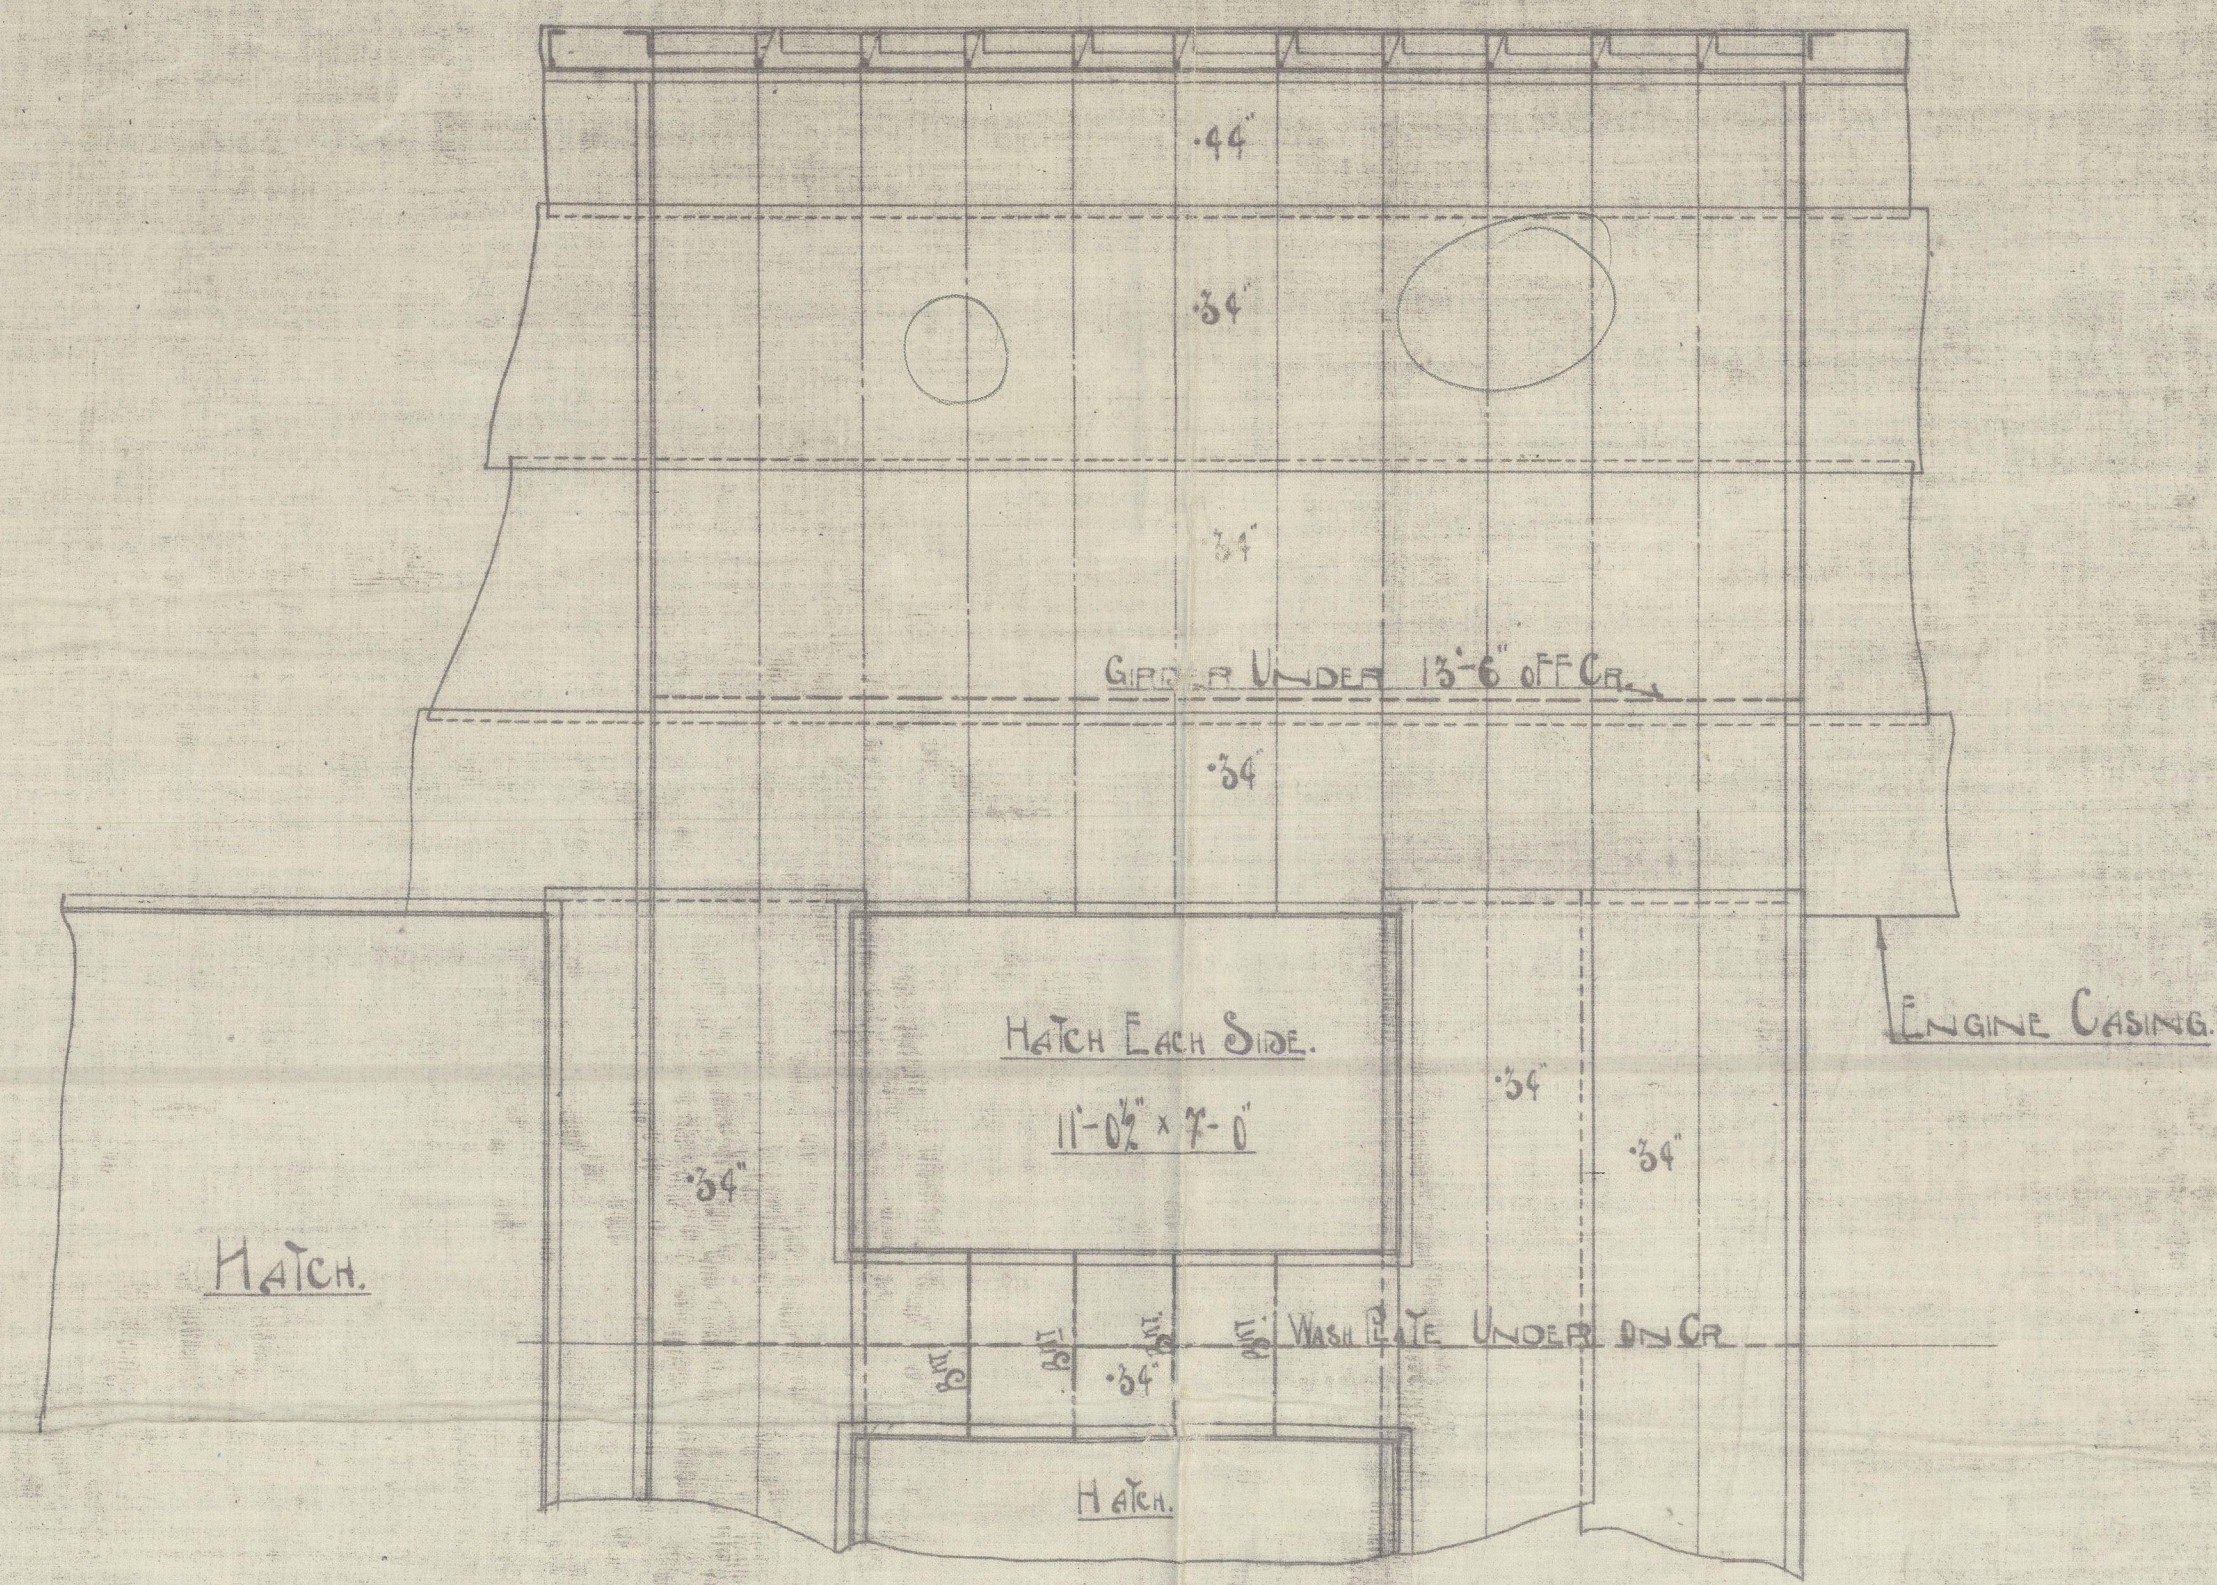




PLAN VIEW AT MAIN D<sup>5</sup>

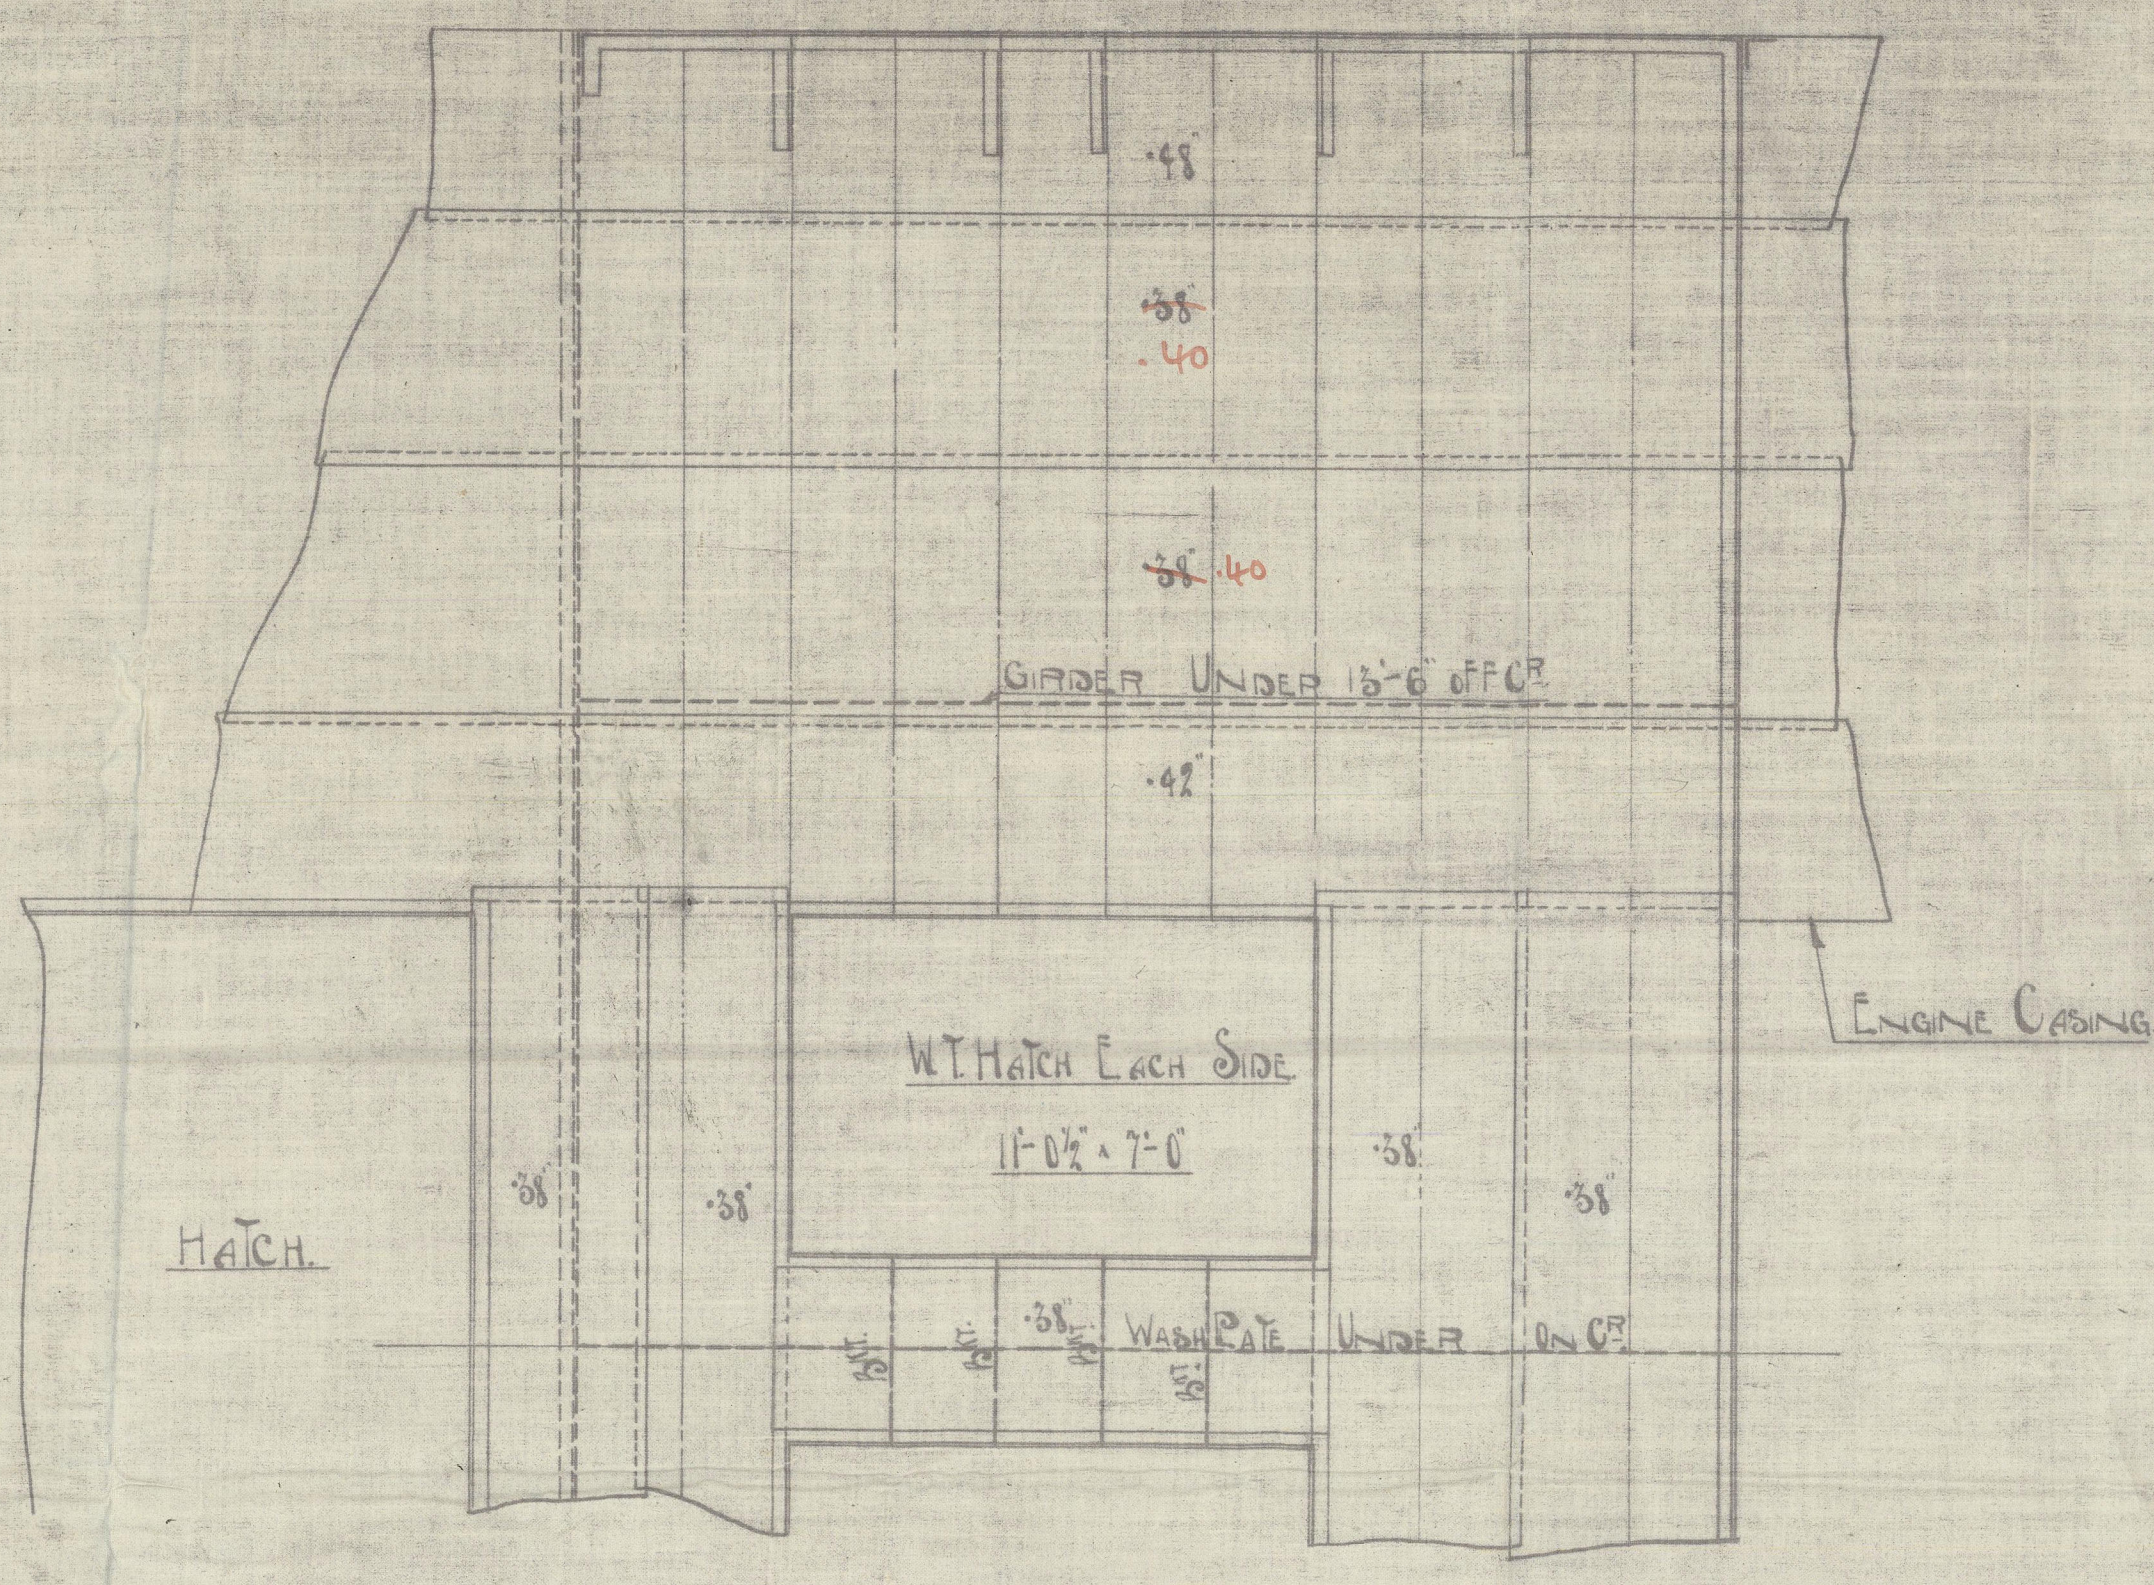


PLAN VIEW AT UPPER D<sup>5</sup>

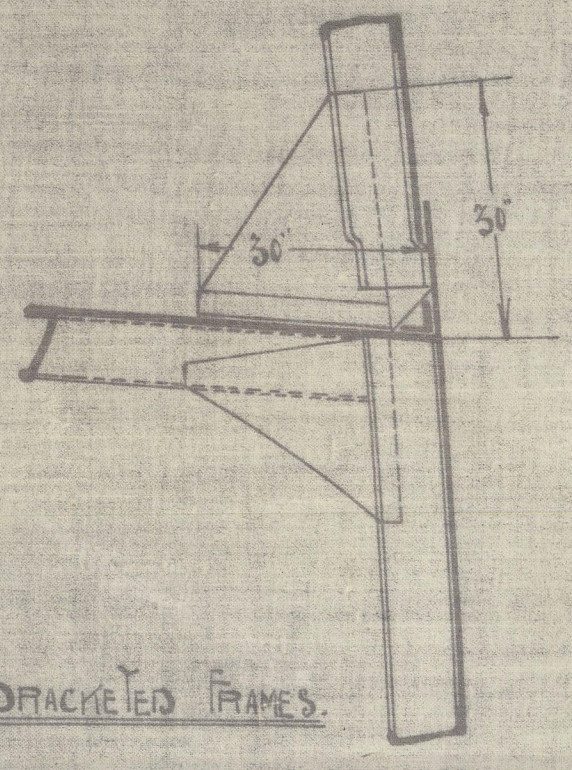



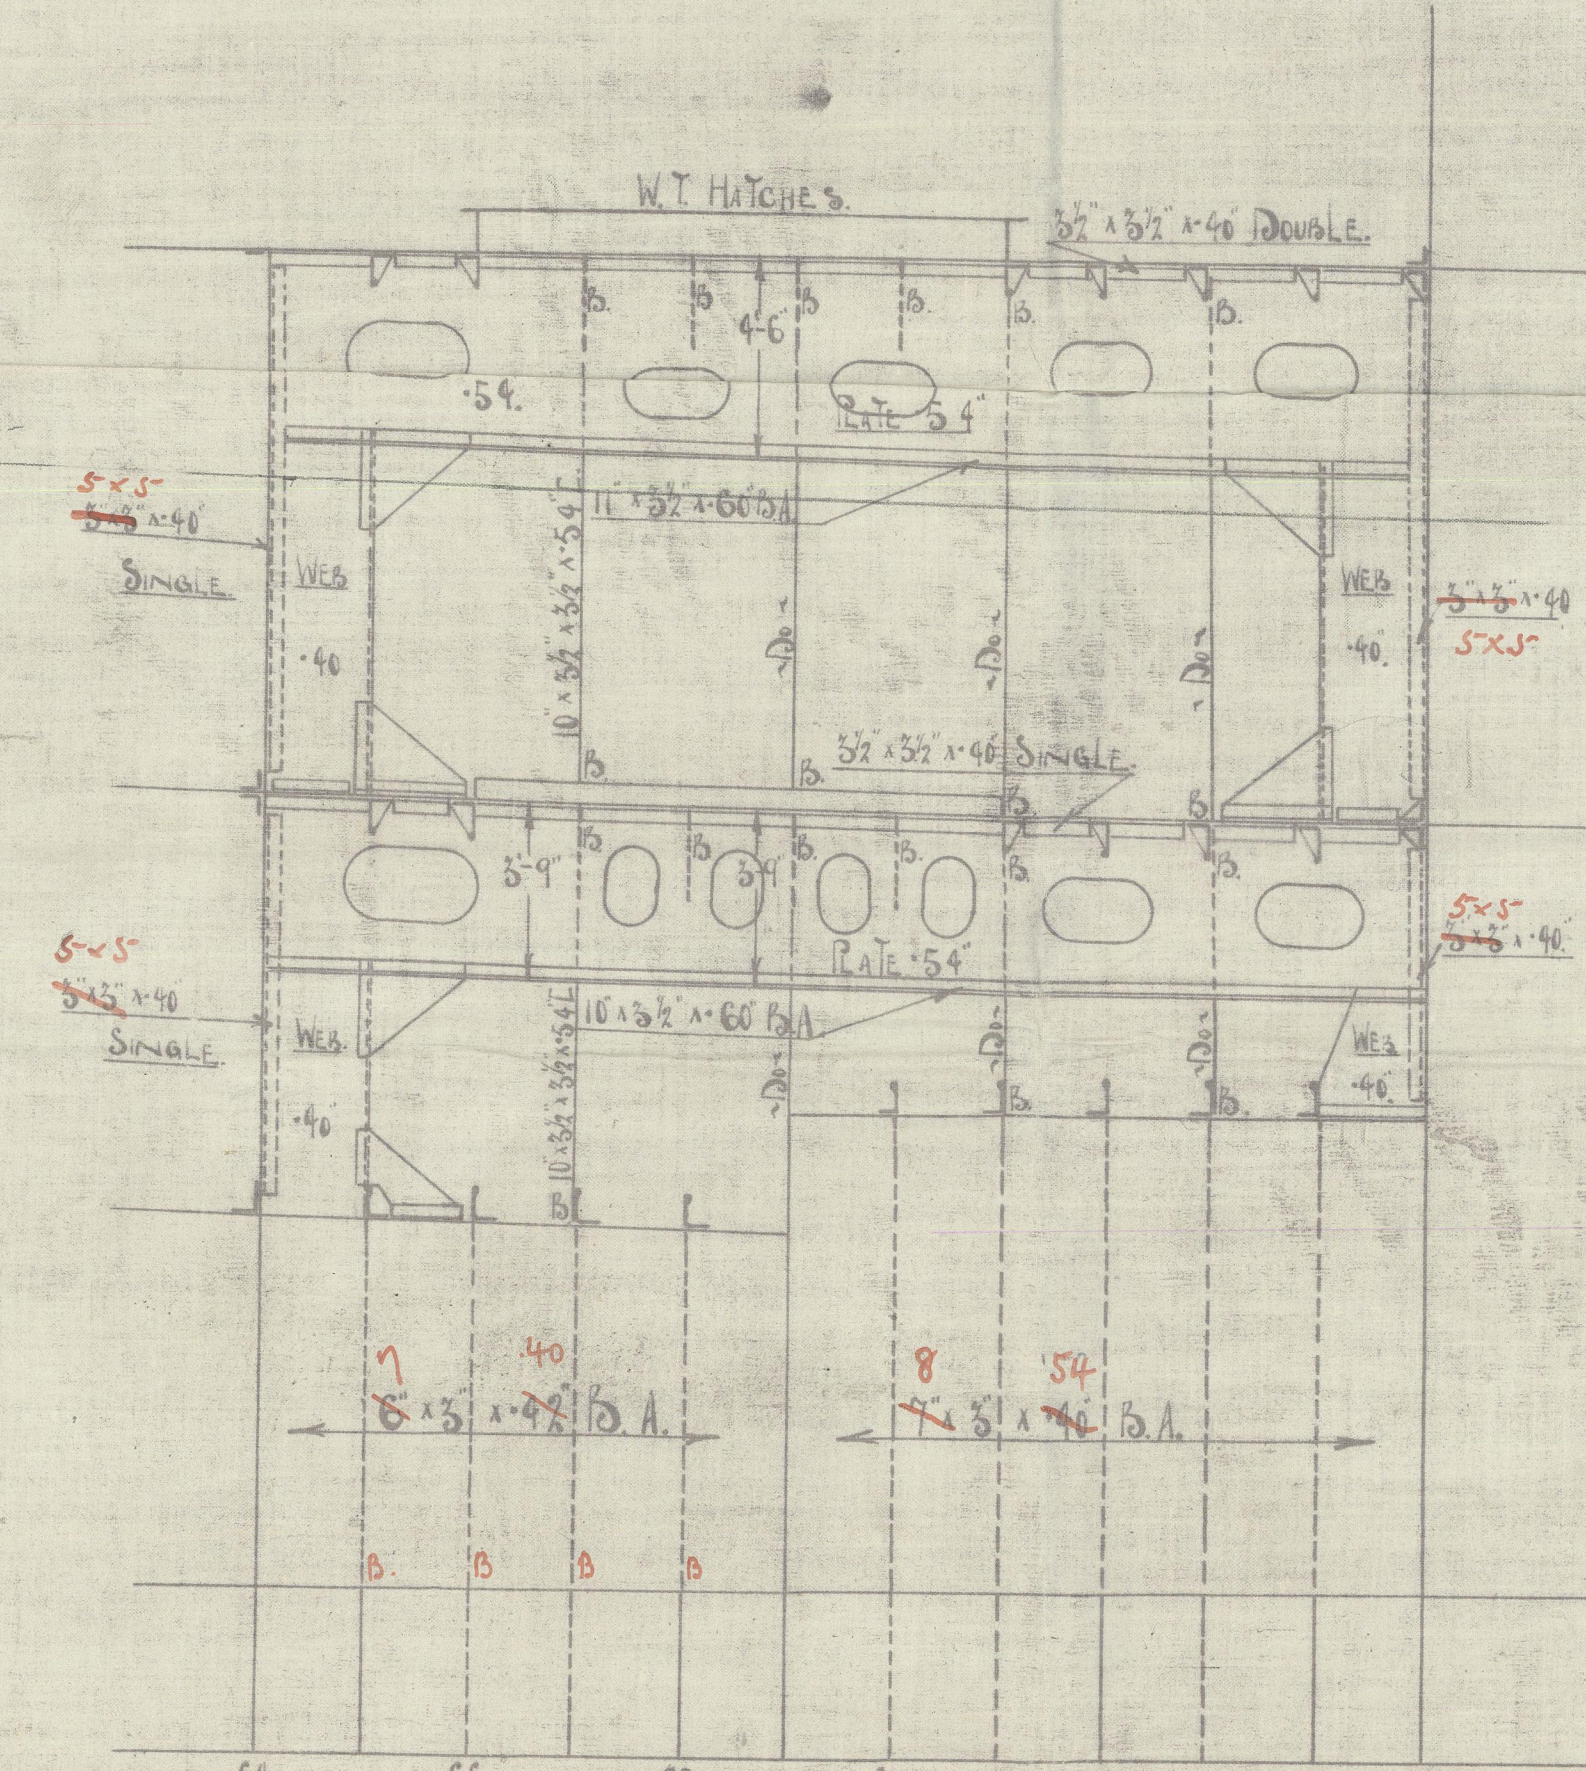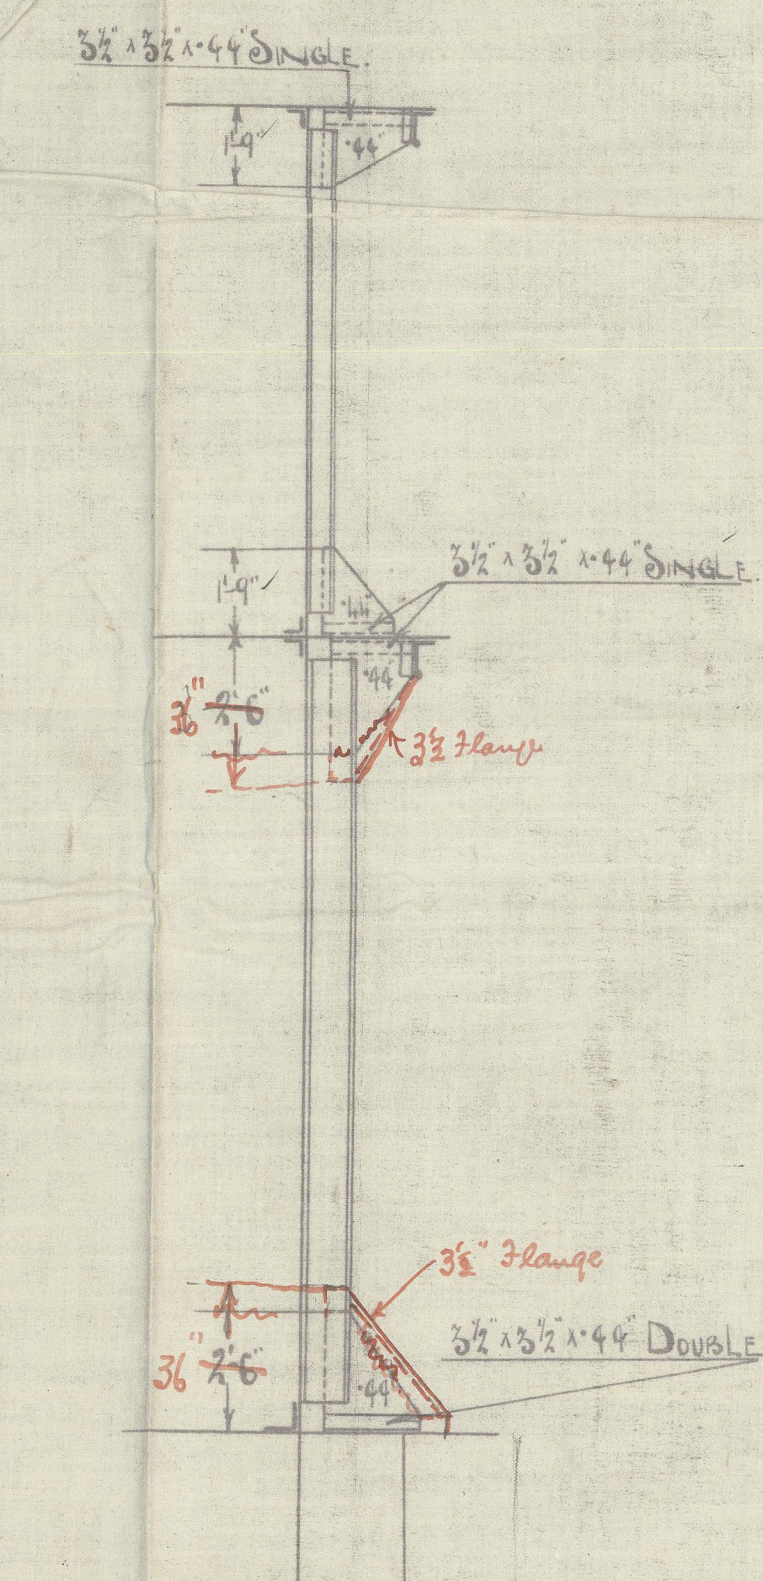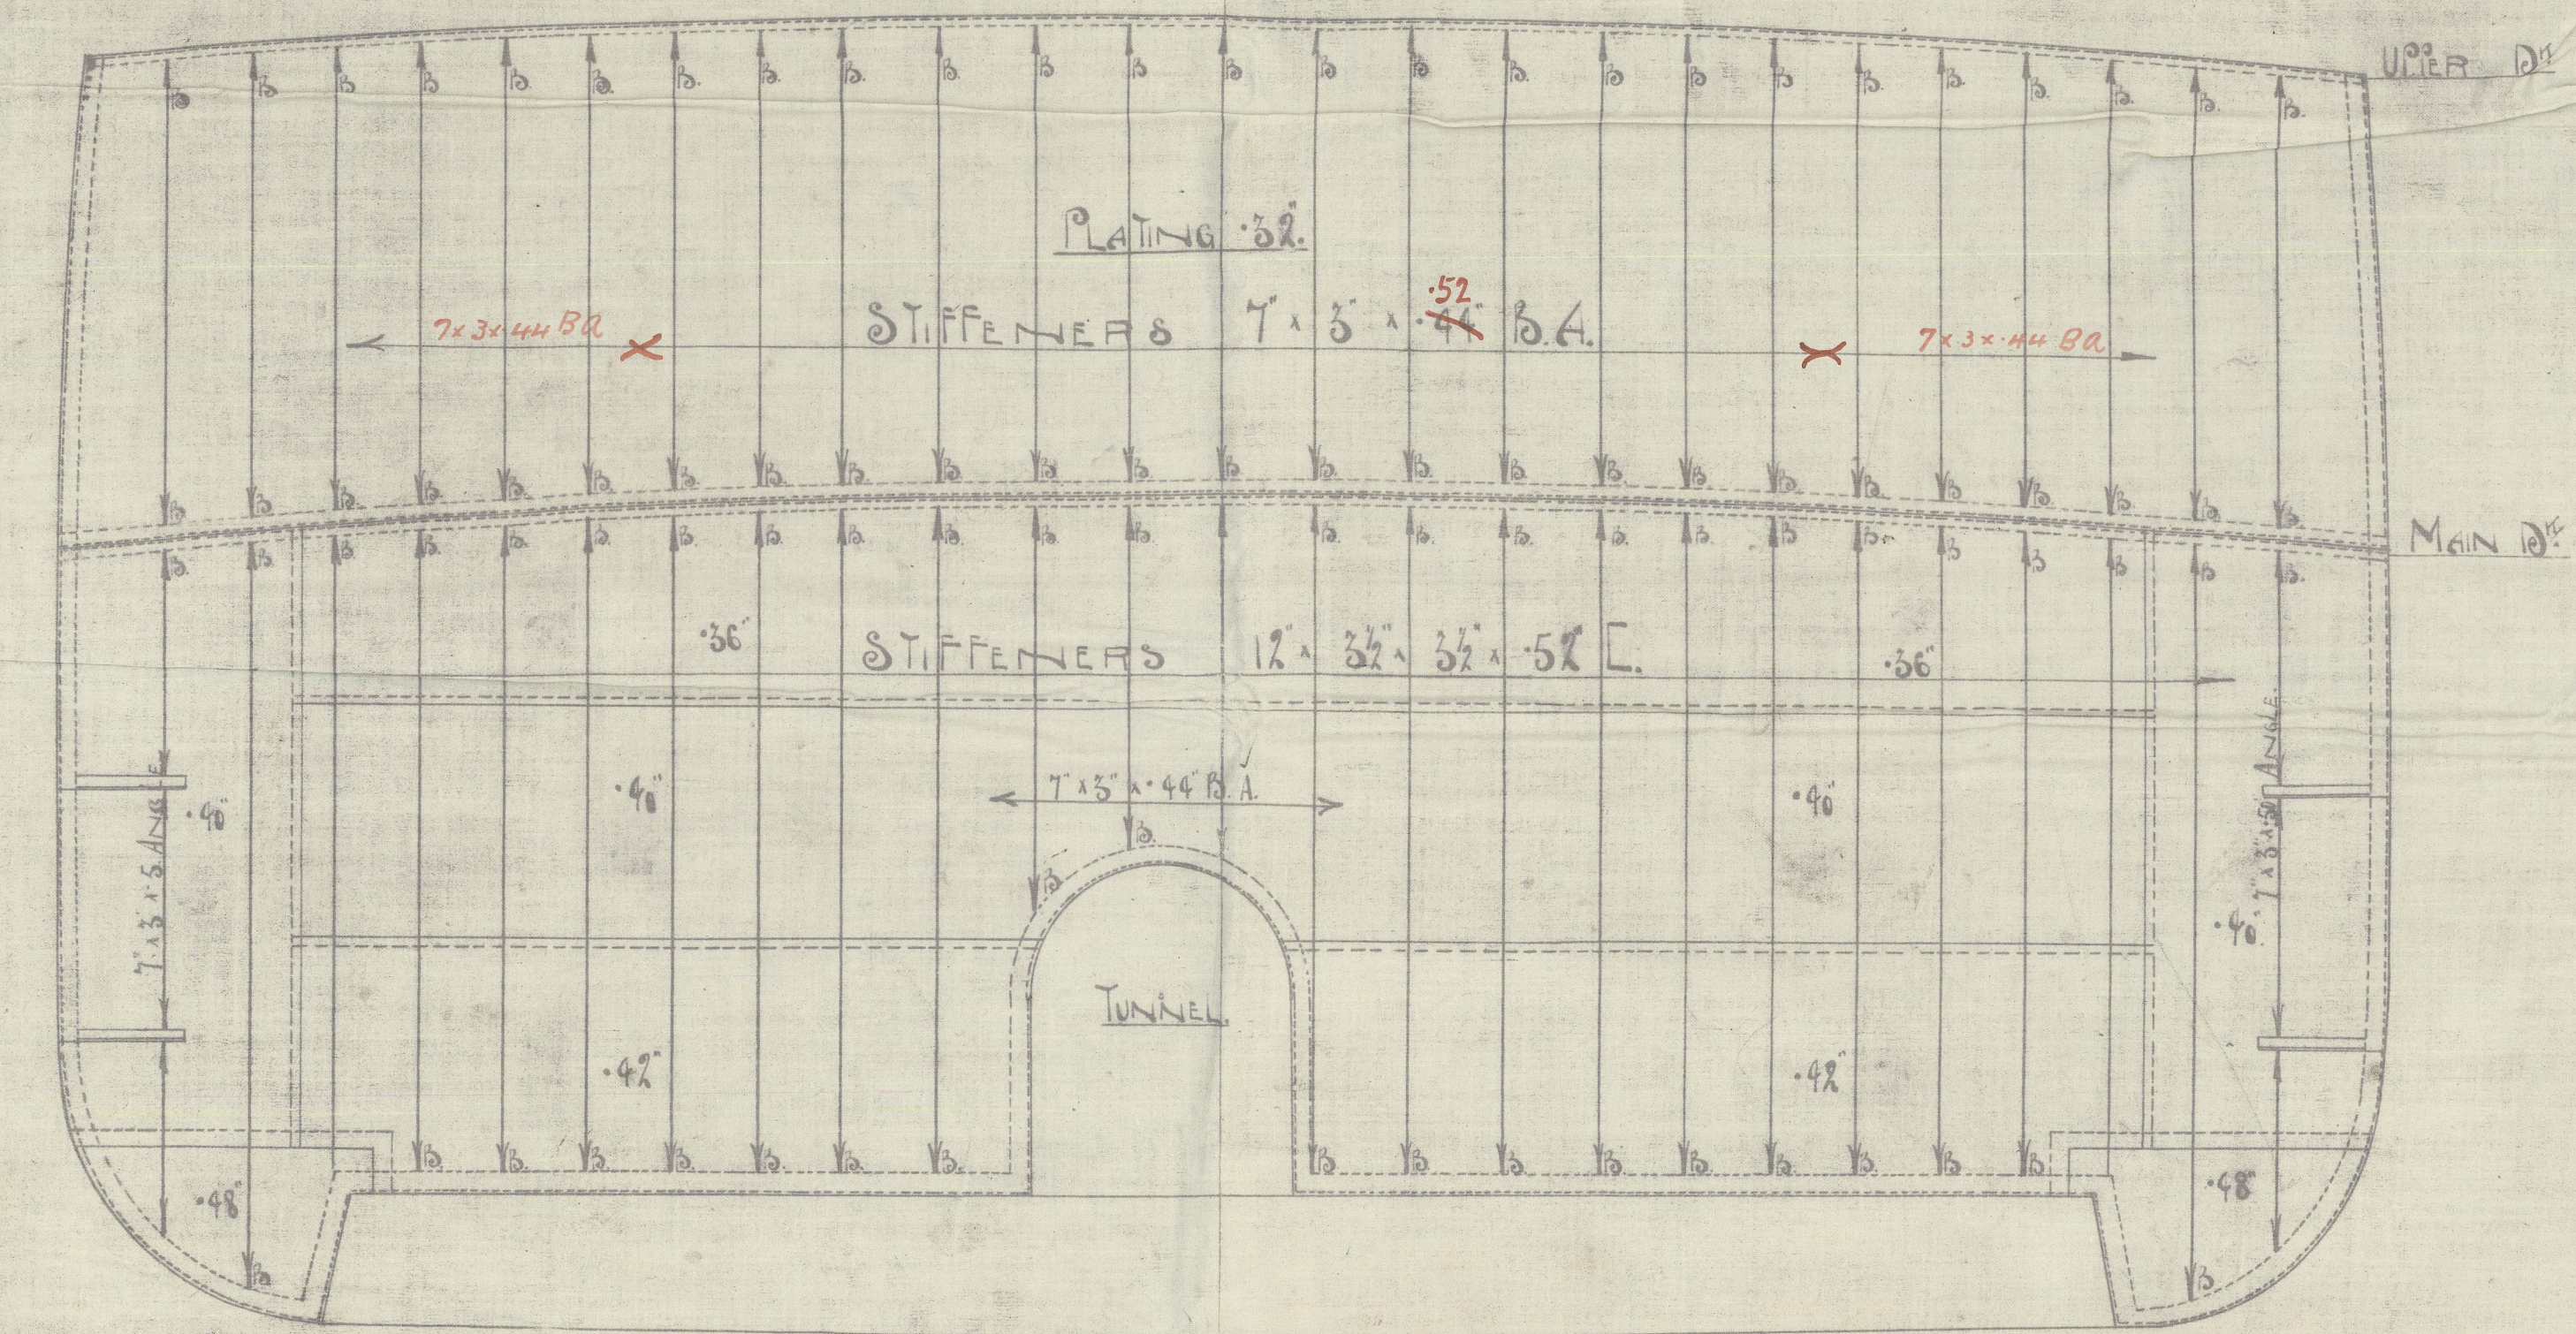


ELEVATION OF DEEP TANK

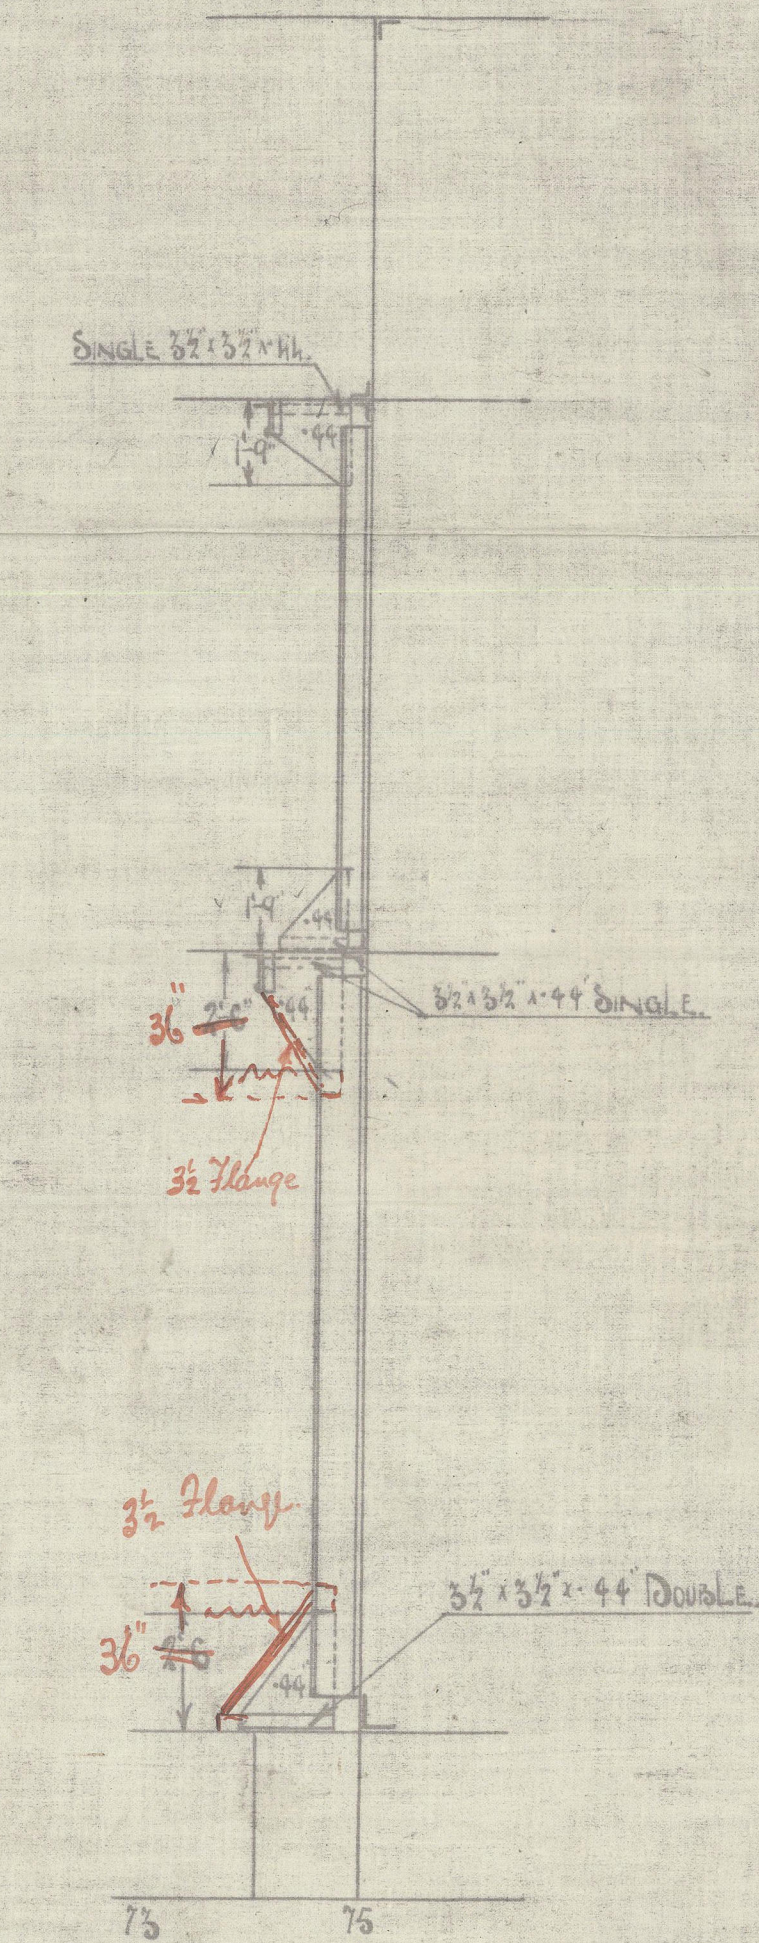


SECTIONAL ELEVATION THROUGH D<sup>5</sup> 75

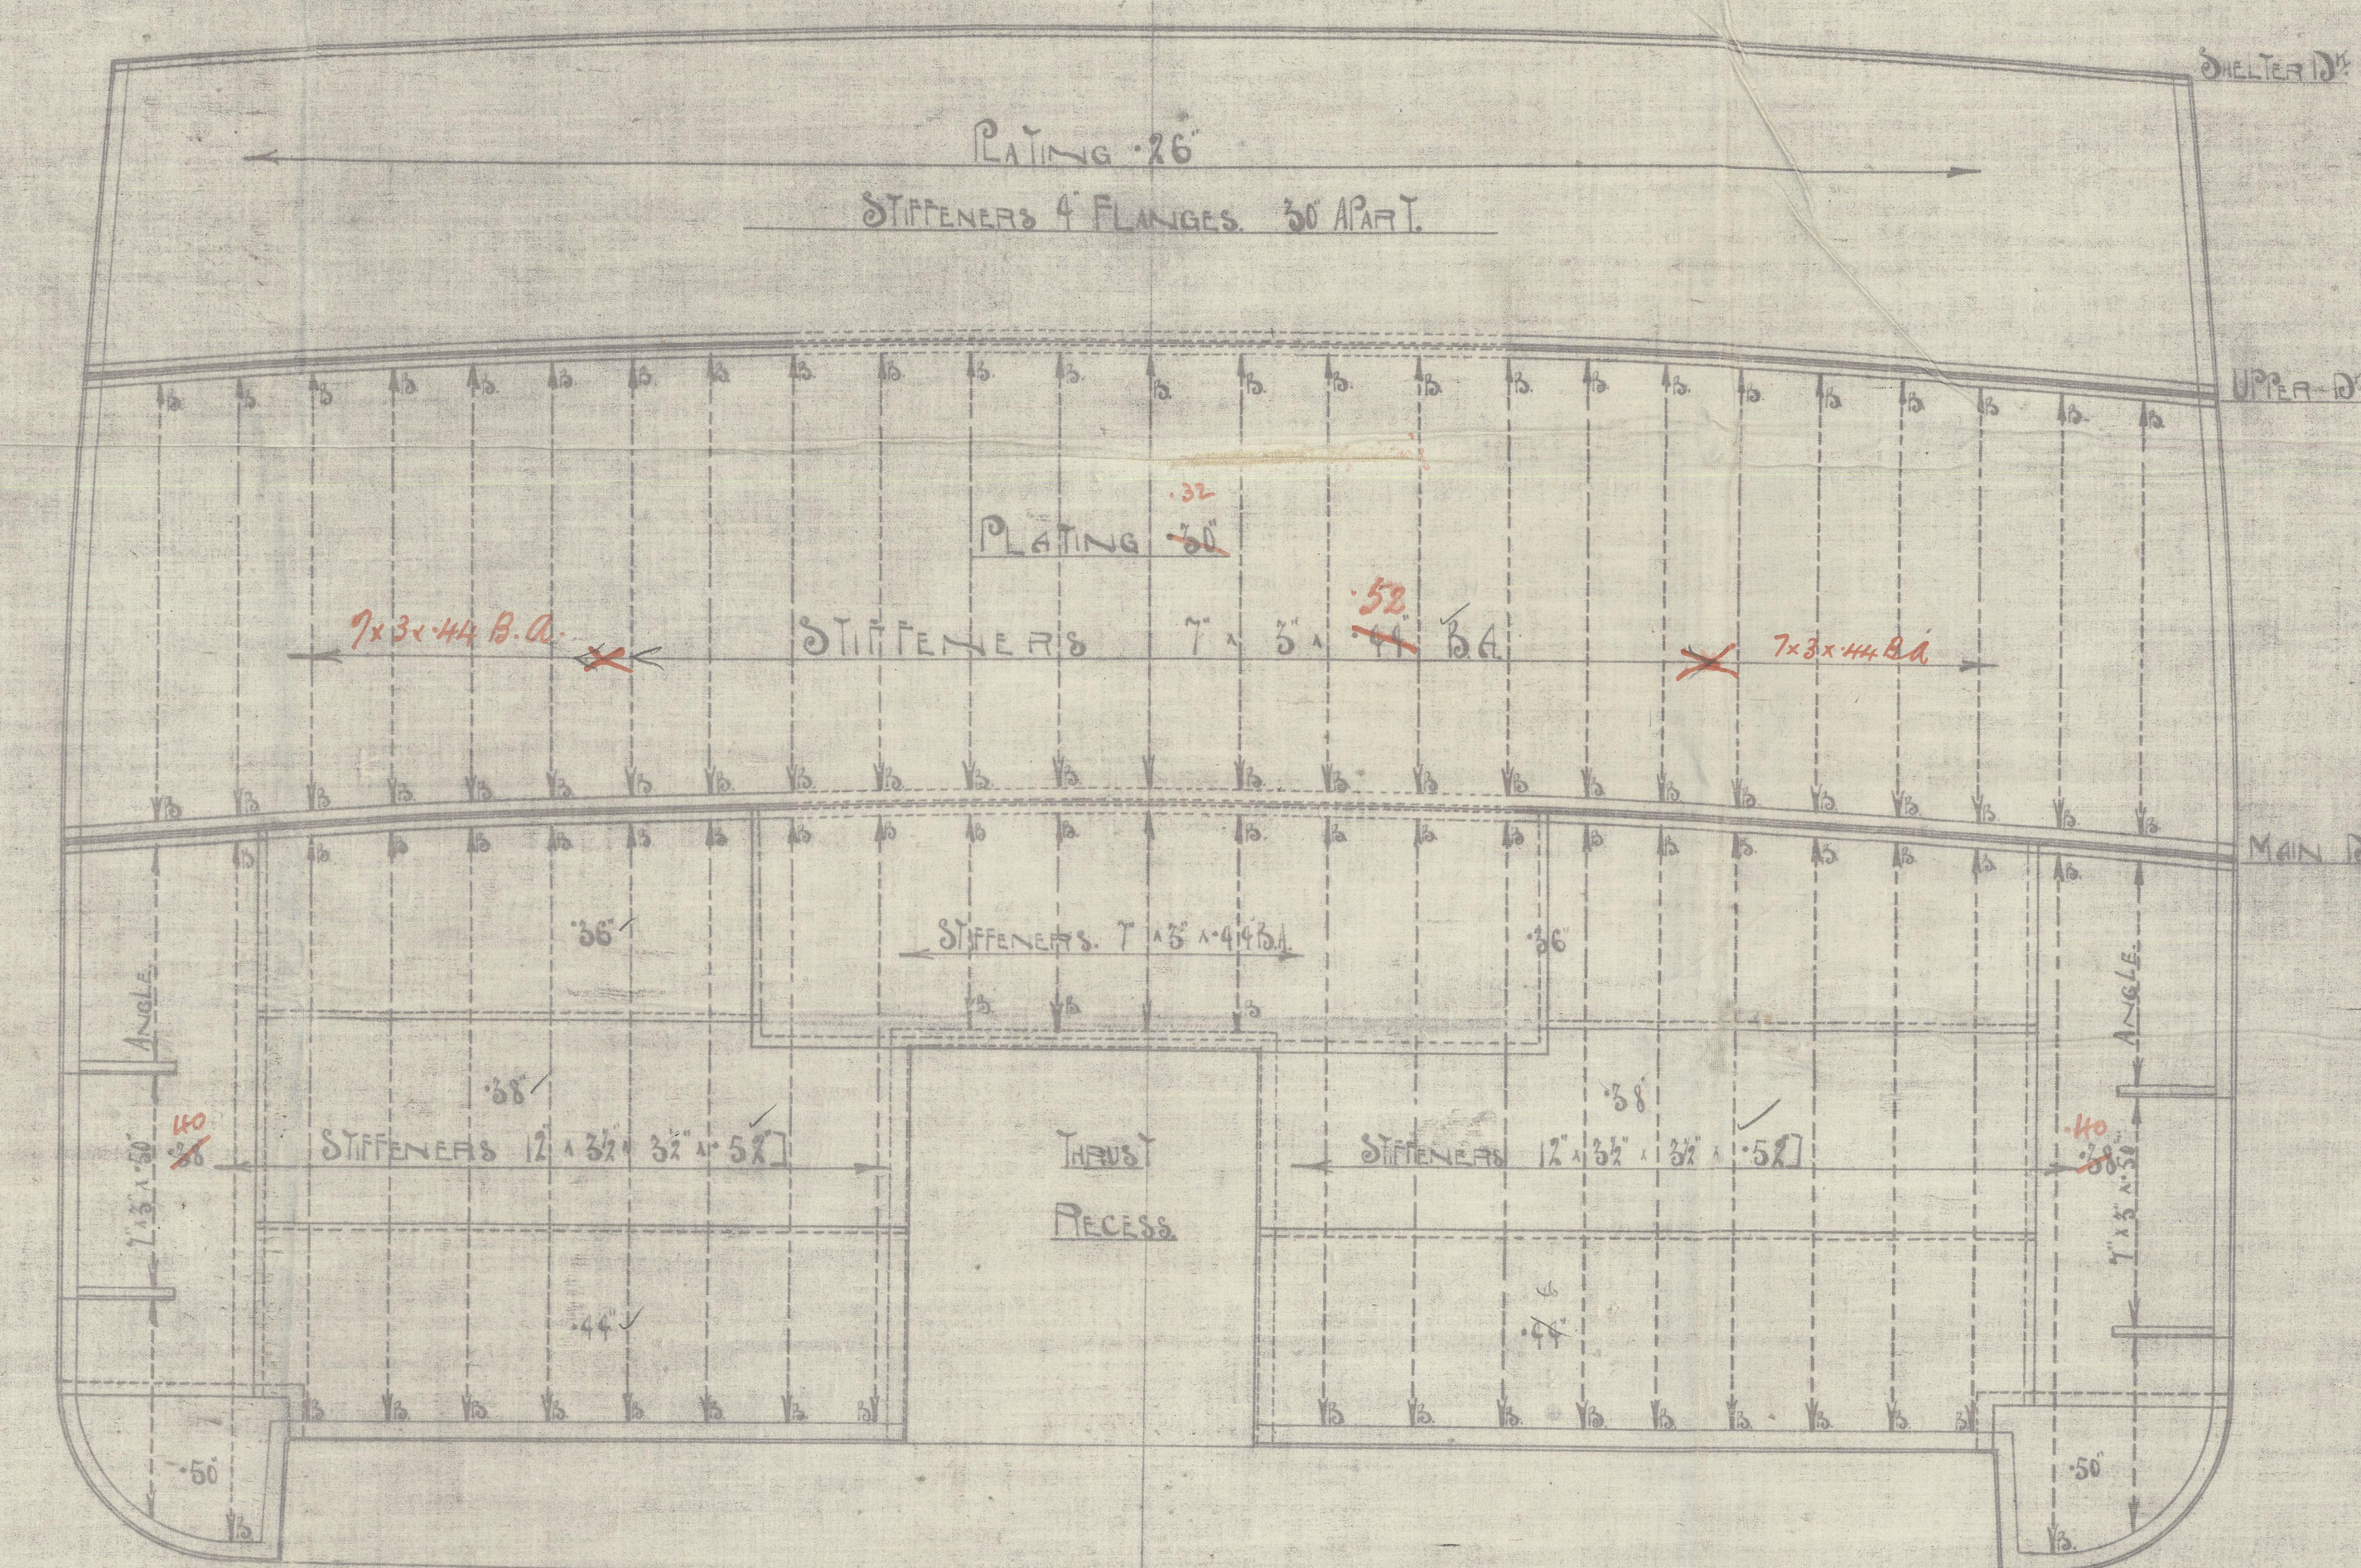

PLAN VIEW THROUGH HOLD

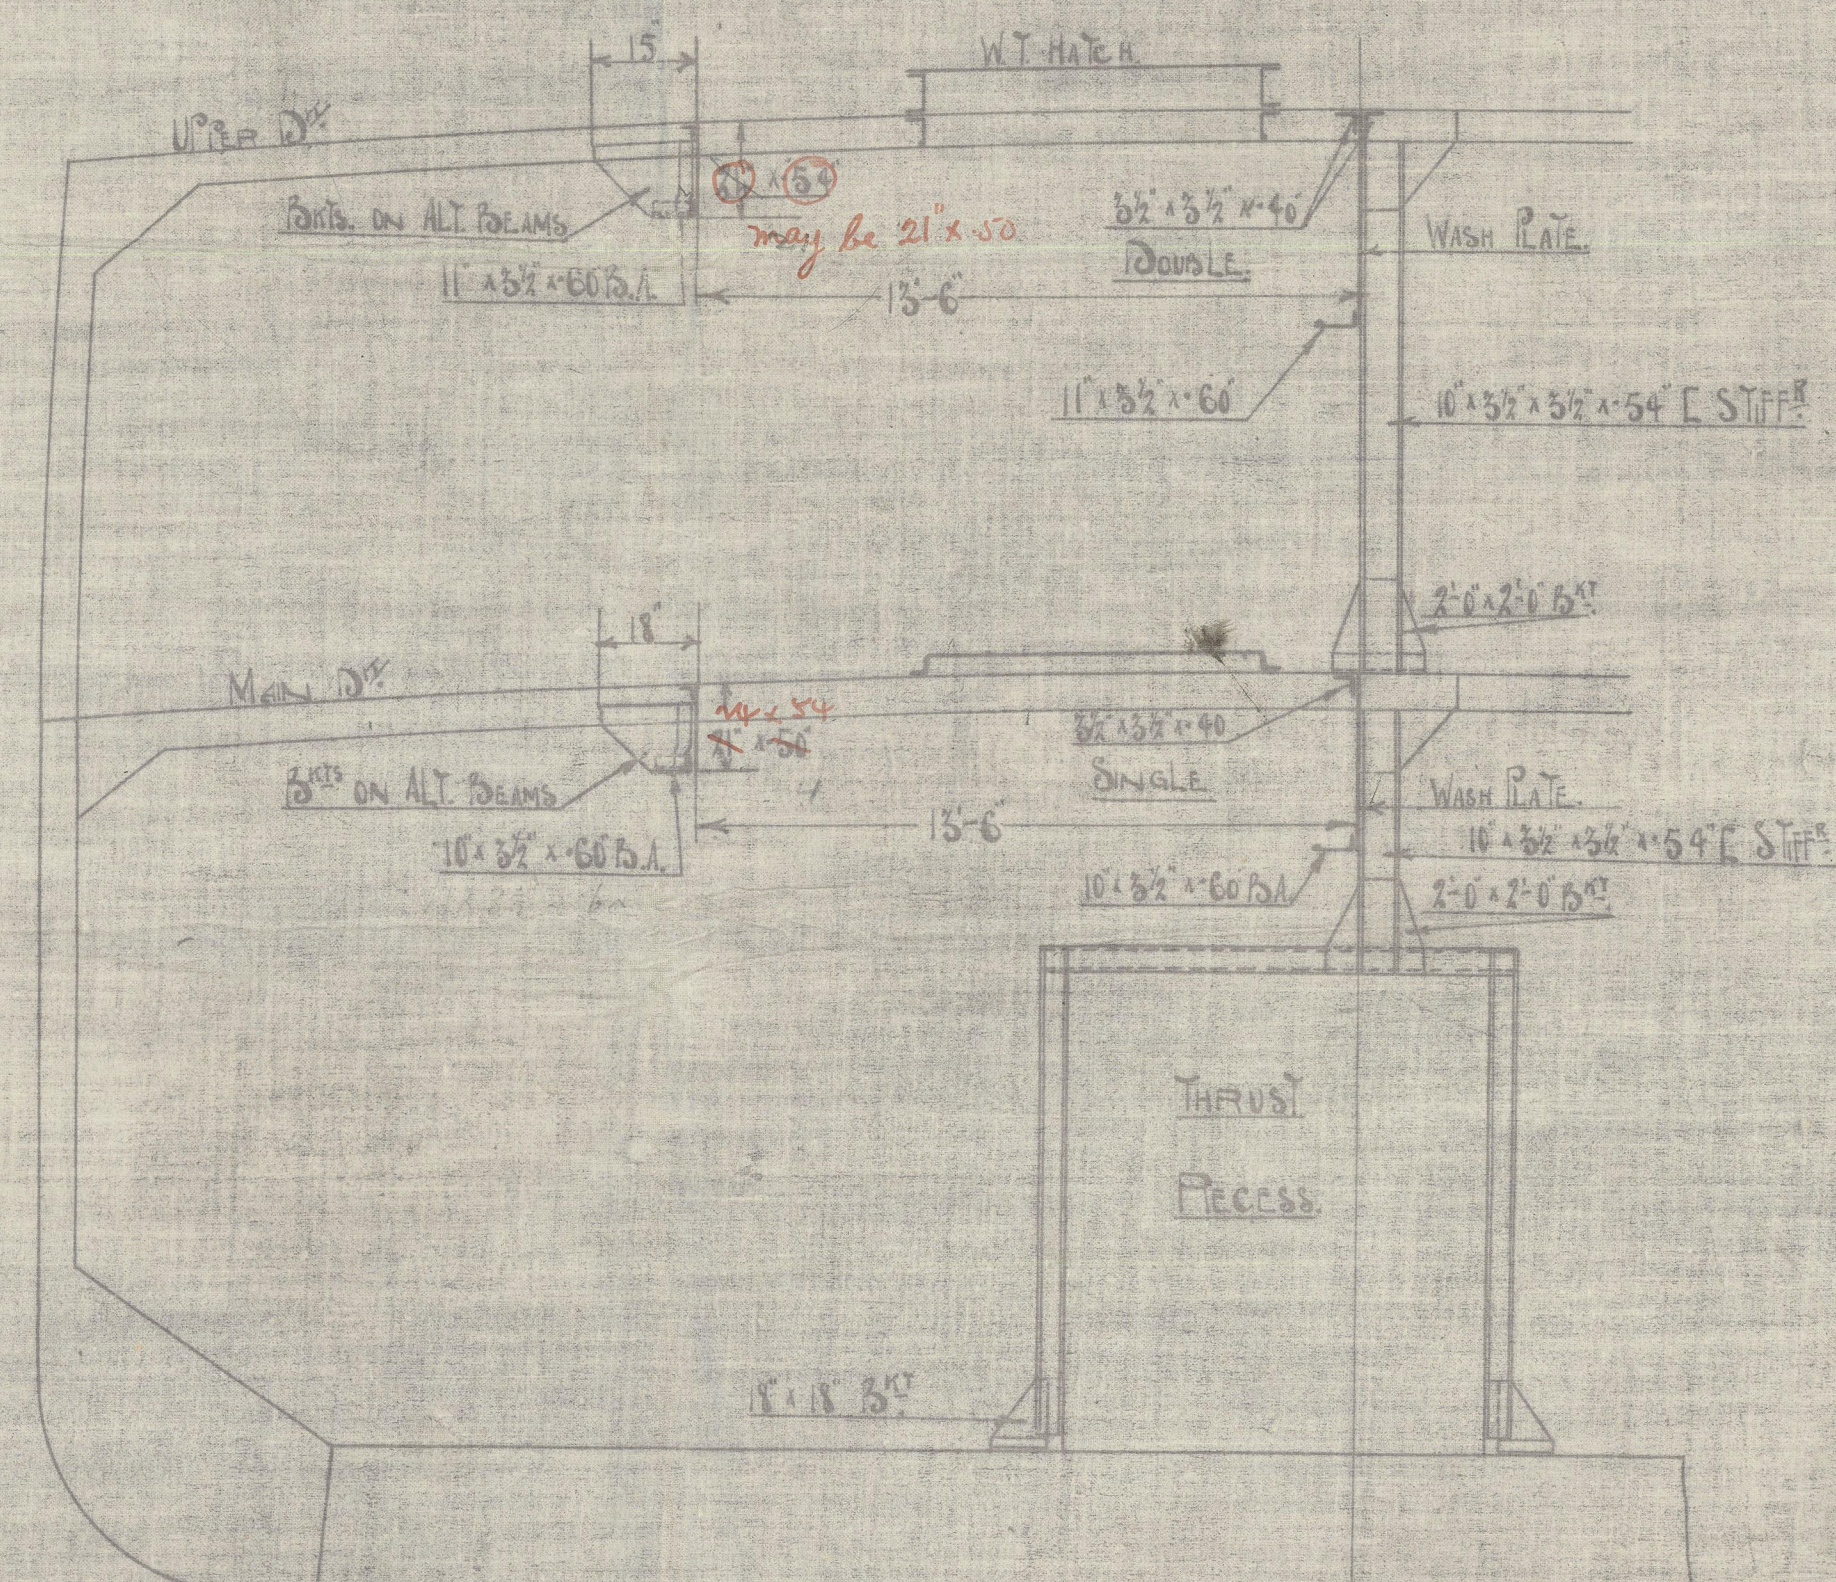

PLAN SECTION THROUGH HOLD IN WAY OF TUNNEL RECESS

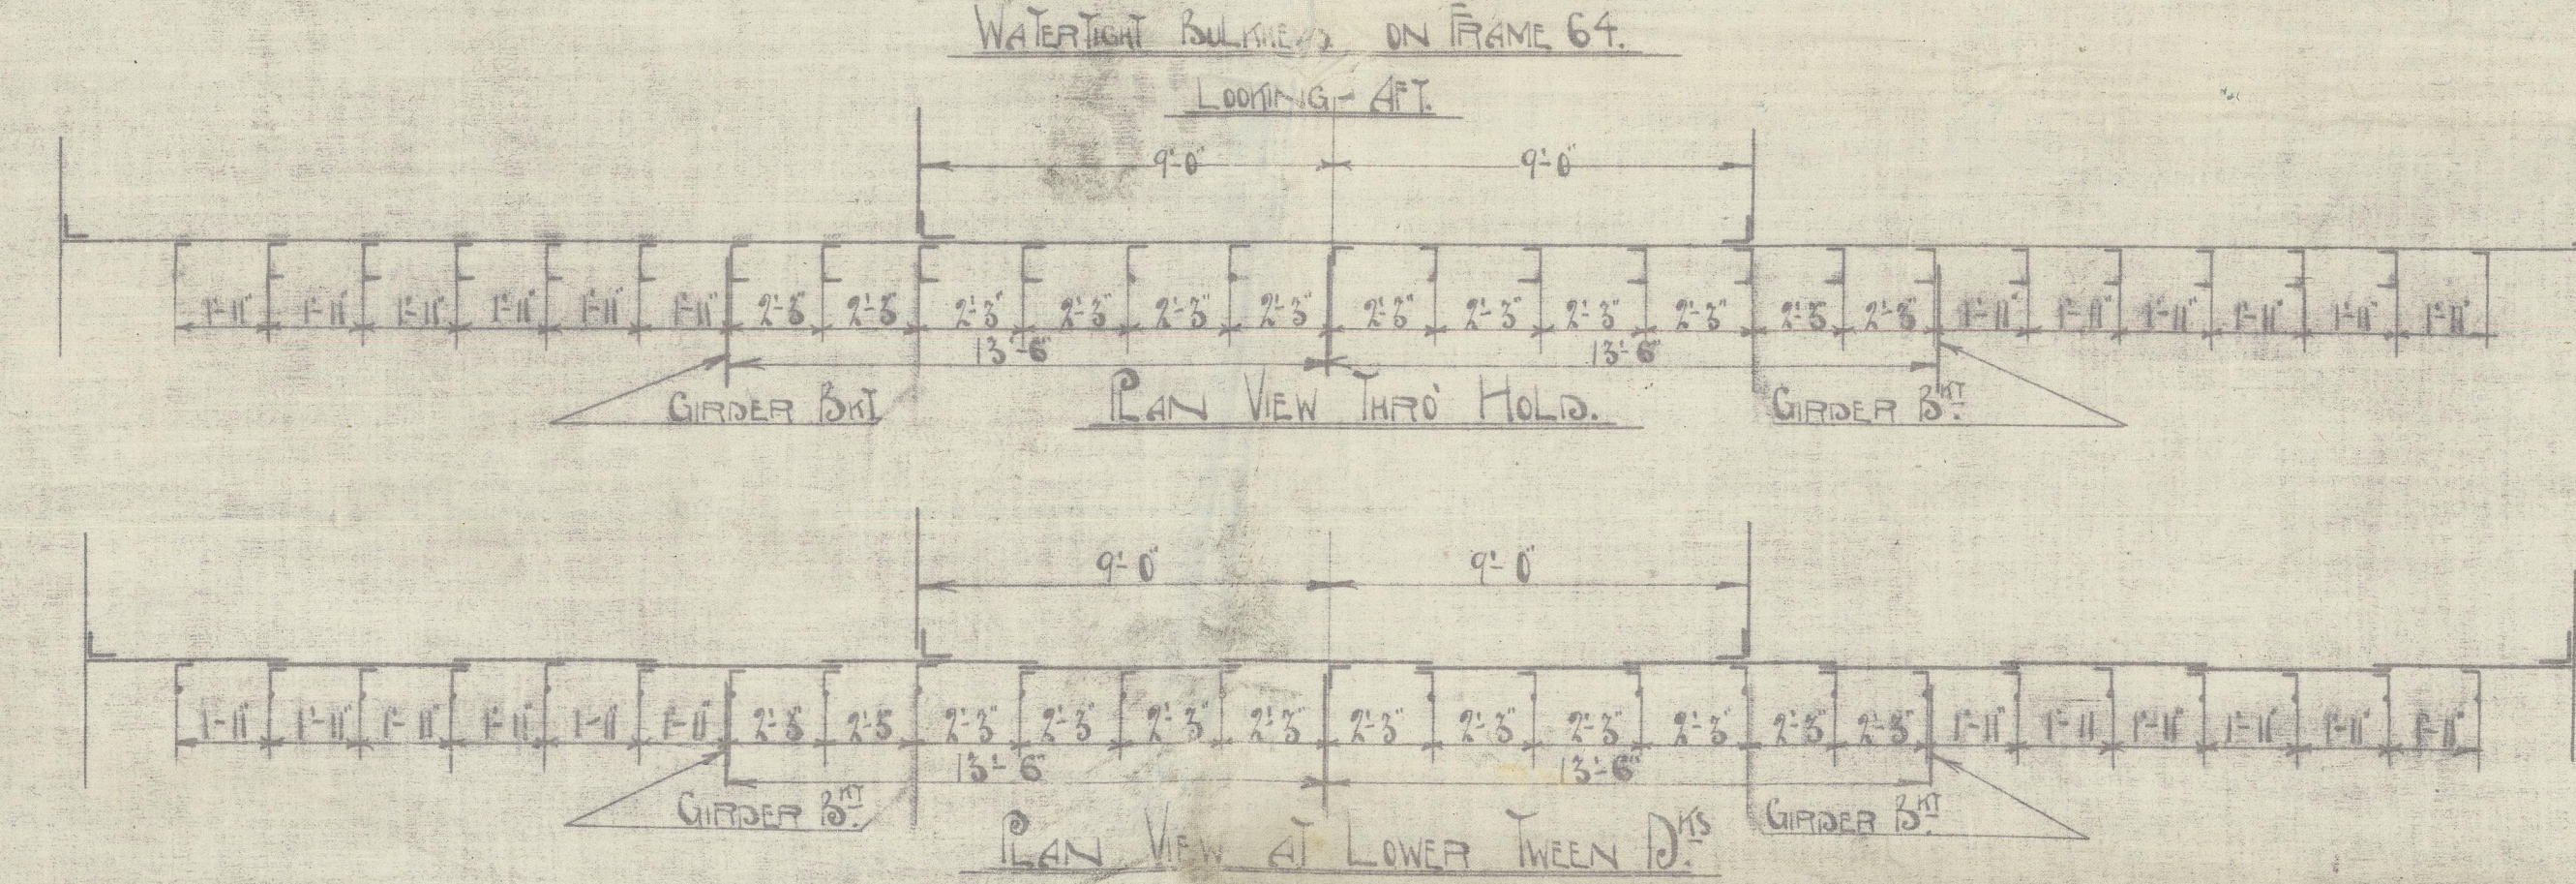

PLAN VIEW THROUGH HOLD

PLAN VIEW AT LOWER TWEEN DECK

C.T.  
1.3.19



N<sup>o</sup>. 503.

Deep Tann Plan

---

J. W. Henderson v1

GLASGOW REPORT No. 40 342

S/s Lalande

002653-002658-0091



© 2020

Lloyd's Register  
Foundation