

19/2/18
3-3-19
14-4-19
23-6-19



1/2 N°503

PROFILE & DECK PLANS



SCALE 1/8"=1 FT

DIMENSIONS 442'-0" x 55'-0" M² x 58'-0" M² TO SHELTER DECK

TO CLASS 100A AT LLOYD'S SHELTER DECK

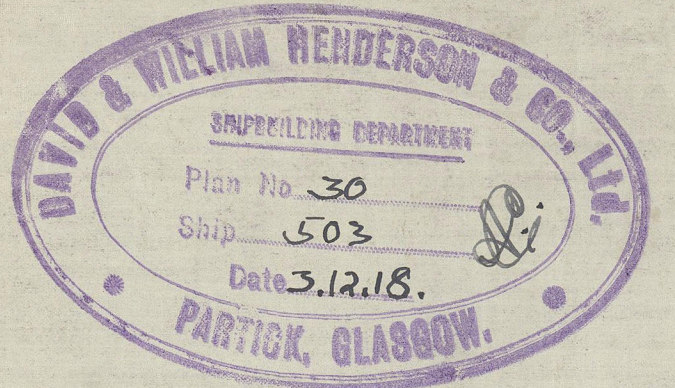 

PLAN OF PAINTING ARRANGEMENTS TO BE SUBMITTED

 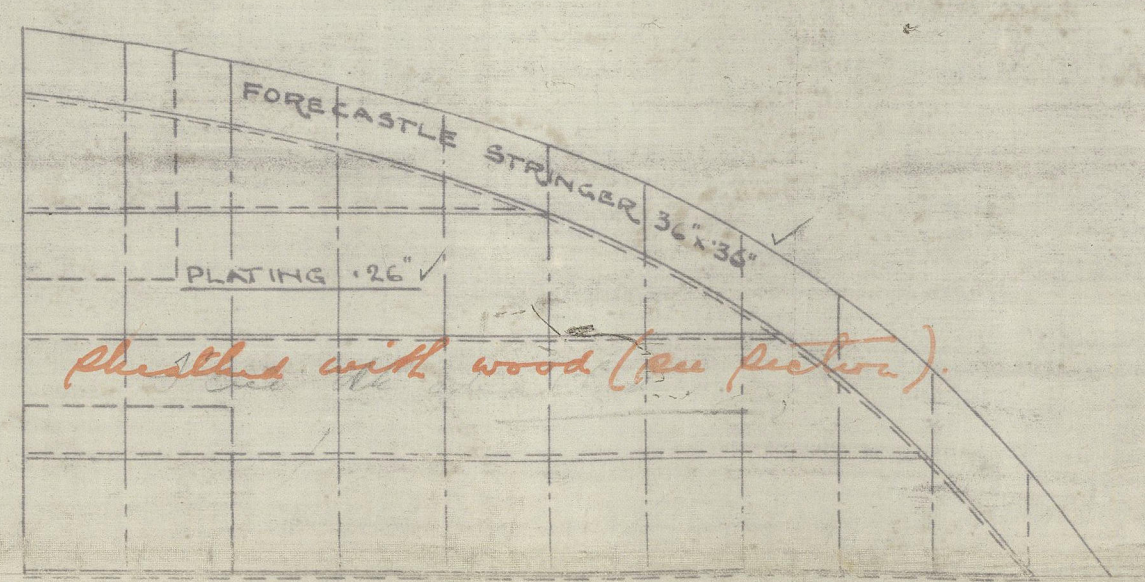

FORECASTLE DECK

SHELTER DECK

UPPER DECK

MAIN DECK

SHED













TYPICAL SECTION THRO HATCHES

SCALE 1/8"=1 FT

© 2020

Lloyd's Register

Foundation

N^o 503.

Profile & Dear Plans
Don Henderson H.



GLASGOW REPORT No. 440342

5/5 Salanda

Proline Mica

002653-002655 1092



© 2020

Lloyd's Register
Foundation

