

$$24 \mid 6 \mid 36$$


Lloyd's Register
Foundation

S. S. "LALANDE"

LIVERPOOL

Report No. 107590.

DETAILS OF STEEL
HATCH COVERS

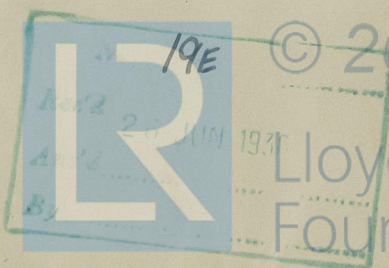

9600-859200-38200