

# S. S. FORMA

## MIDSHIP SECTION

SCALE:  $\frac{1}{2}" = 1 \text{ FOOT}$


BRITISH INDIA  
ENGINEERING WORKS  
KARACHI  
DRAWING OFFICE  
DATE: 11.8.51

Class A1 "For Young Service" - the limits of which will require to be defined  
in association with a freeboard corresponding to summer mild draught of 13'-0"  
Equipment to rule regts. - Table 54 Grade 6560

FRAMES SPACED 22 APART ALL FORE & AFT.

The scantlings on the plan have been compared  
with the original plan & found to be  
substantially in agreement.

Your original plan see "RAOFORD"

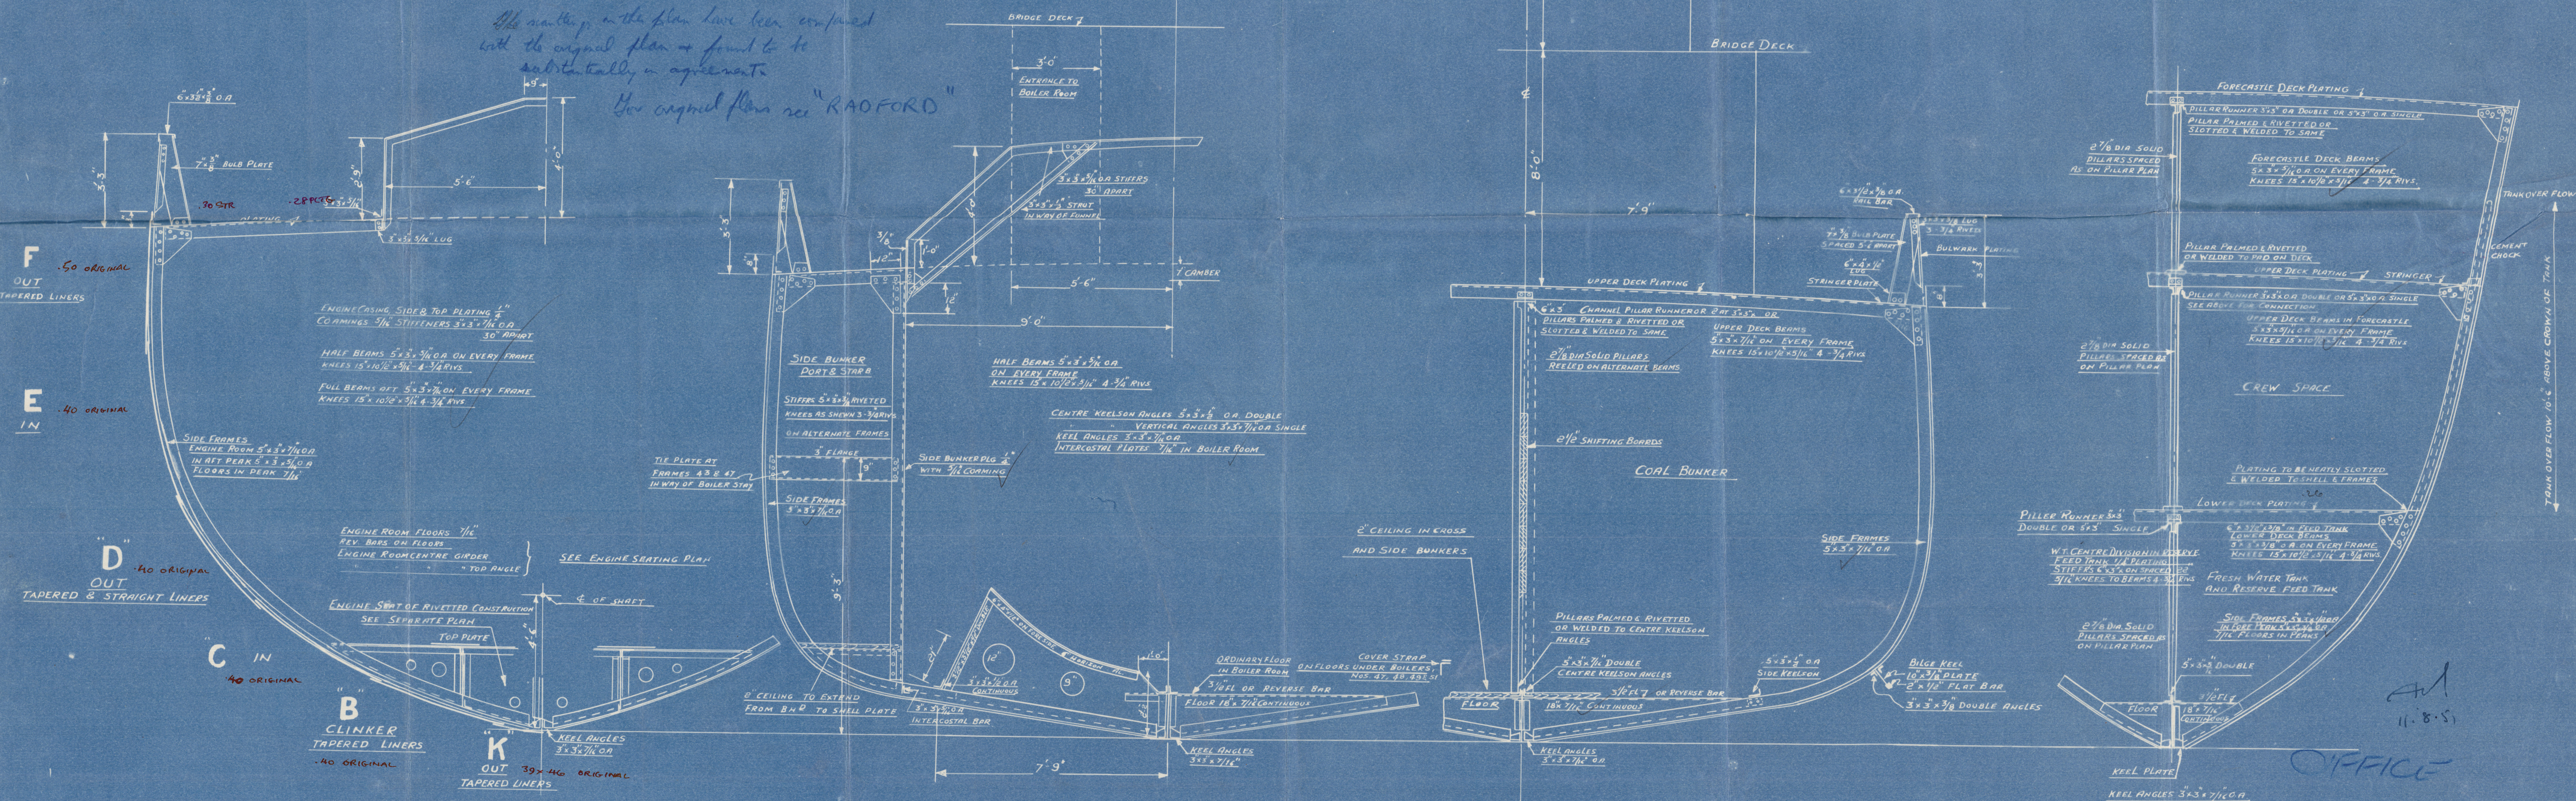

BRITISH INDIA  
ENGINEERING WORKS  
DRAWN BY  
TRACED BY  
CHECKED BY  
DATE

© 2020  
Lloyd's Register  
Foundation

"FORMA"

MIDSHIP SECTION

OFFICE

002659-002666-0001



© 2020

Lloyd's Register  
Foundation

RECORDS DEPT  
LONDON

3

Forma

Midship Section



© 2020

Lloyd's Register  
Foundation

002659-002666-0001