


BASSETT TRAWLER (EX. H.M.I.S. TRAVANCORE) CONVERSION TO TUG

SCALE 1/4" = 1 FOOT


CLASS - 7A 1/2 inch Keelback - conversion to tug on ship's design
for fitting Service, Interior, Hull, Machinery, and Deck
Machinery and Equipment.

SH. INDIA
ENGINEERING WORKS
ARCHT.
DRAWING OFFICE
10-10-49

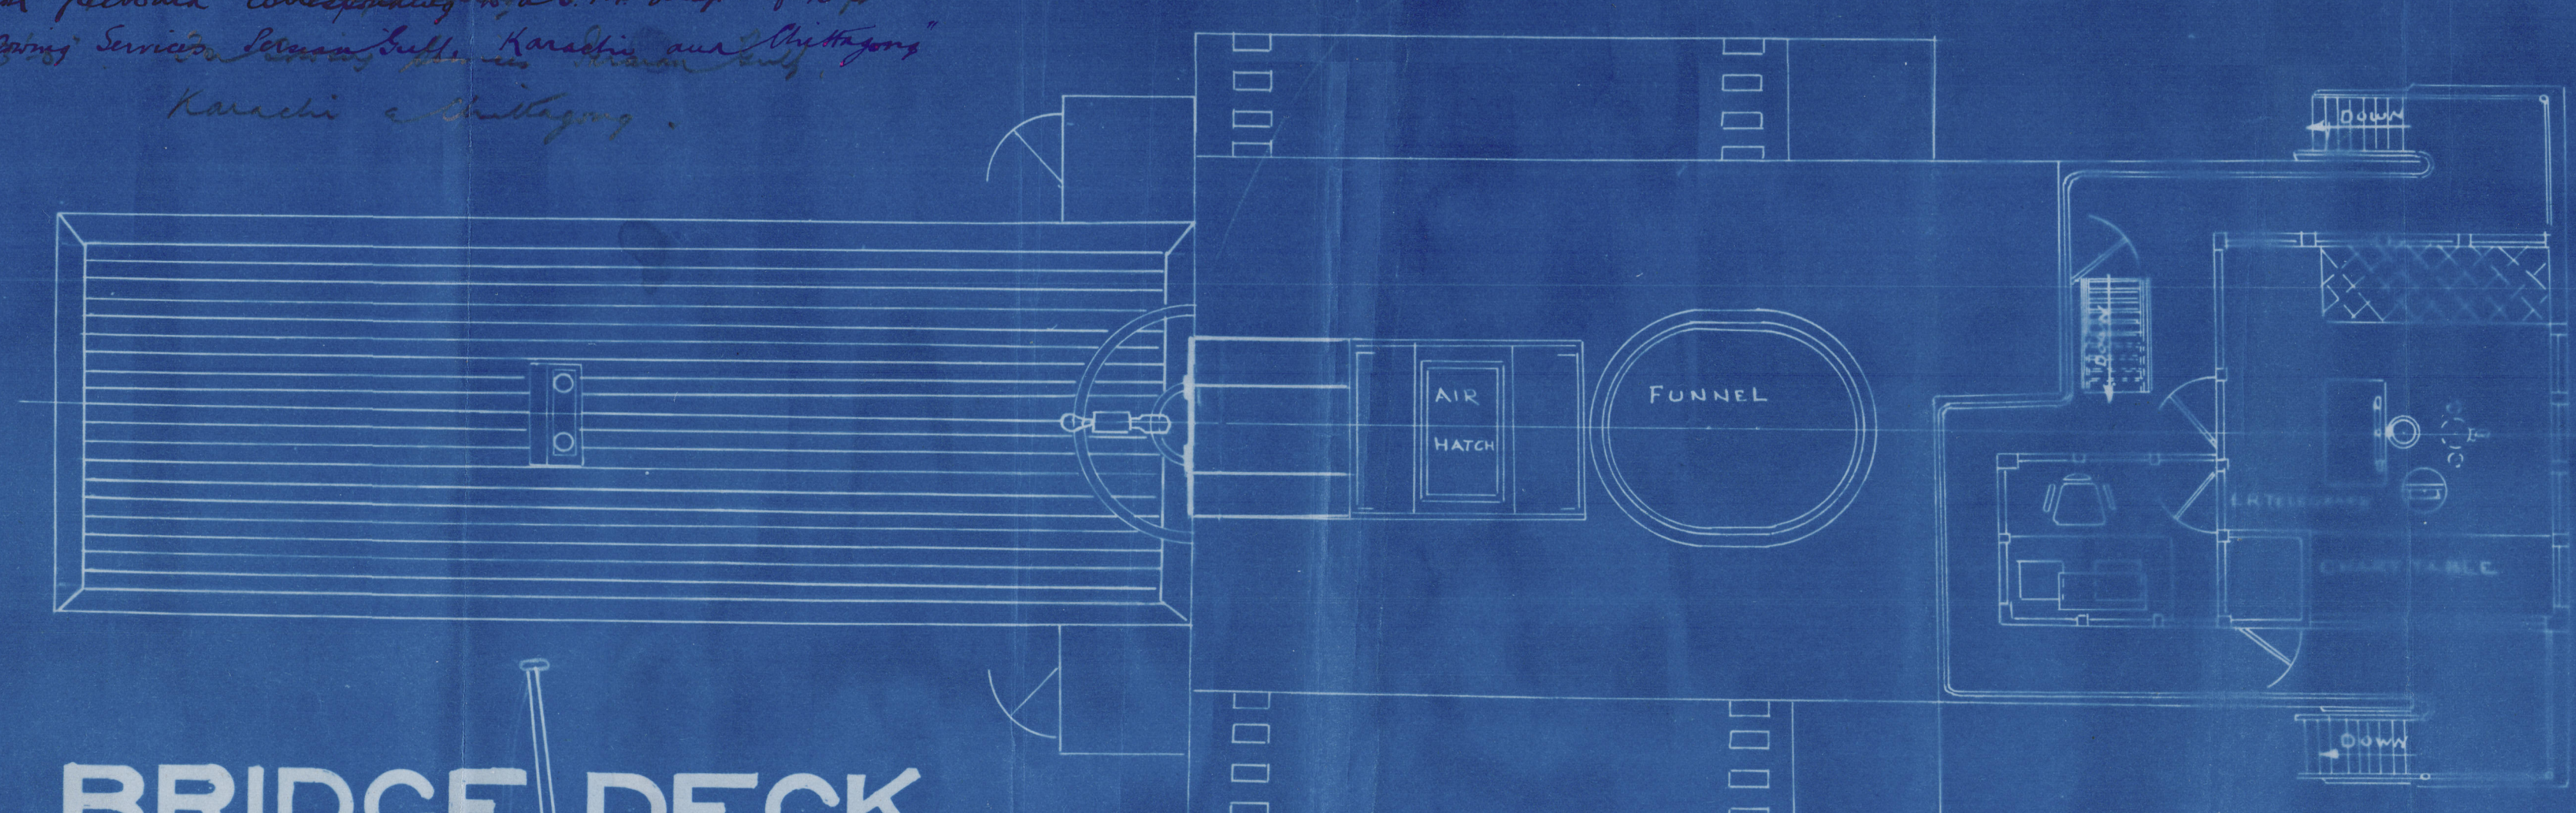


BRIDGE DECK

L.B.P. - 150'-0"
B.M.L.D. - 27'-6"
D.M.L.D. 15'-0"
2ND LONG NO. - 6375
EQUIPMENT:-
2 @ 15 CWT STOCKLESS ANCHORS
135 FATHS X 1 1/4" STOD LINK CHAIN
60" X 7" MANILLA HAWSER
60" X 5 1/2" WARD

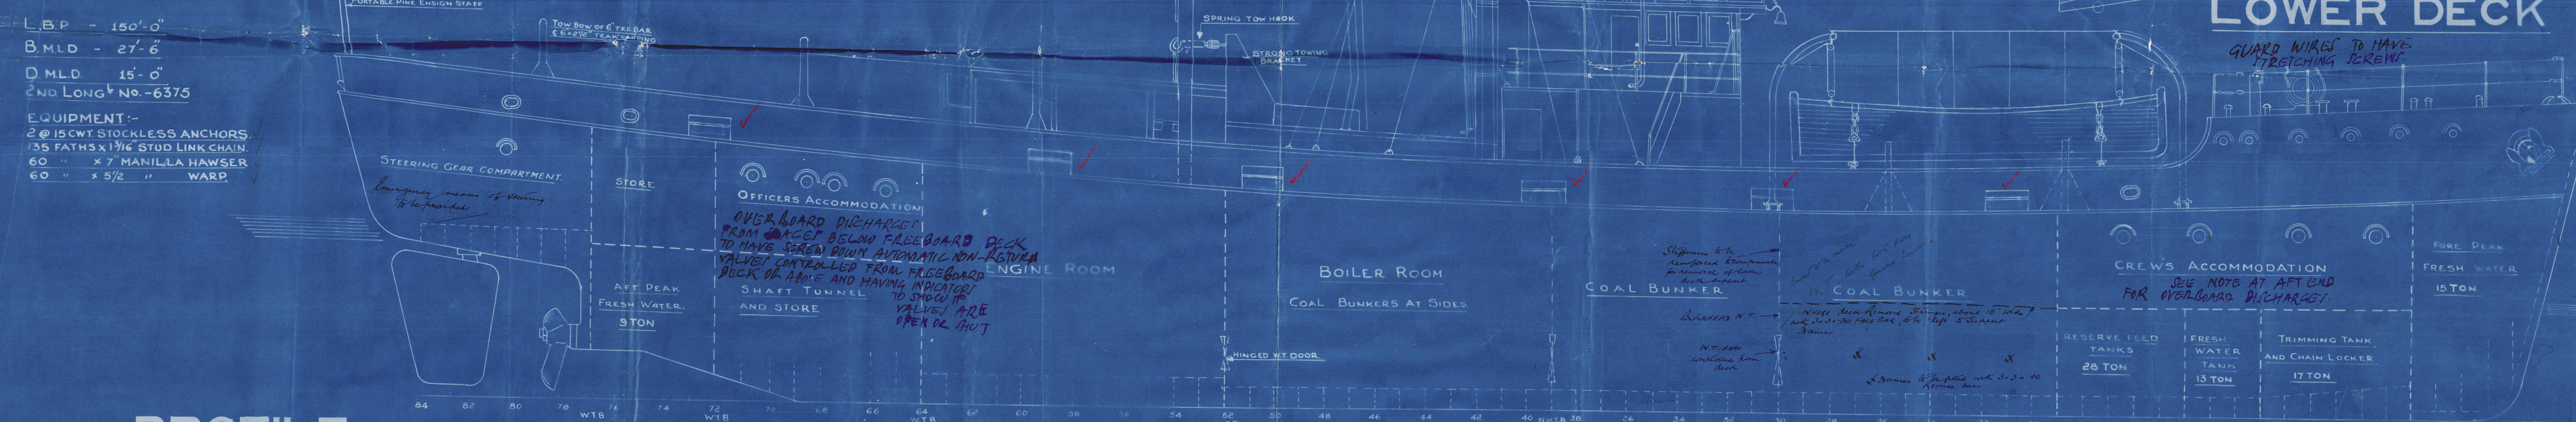

PROFILE

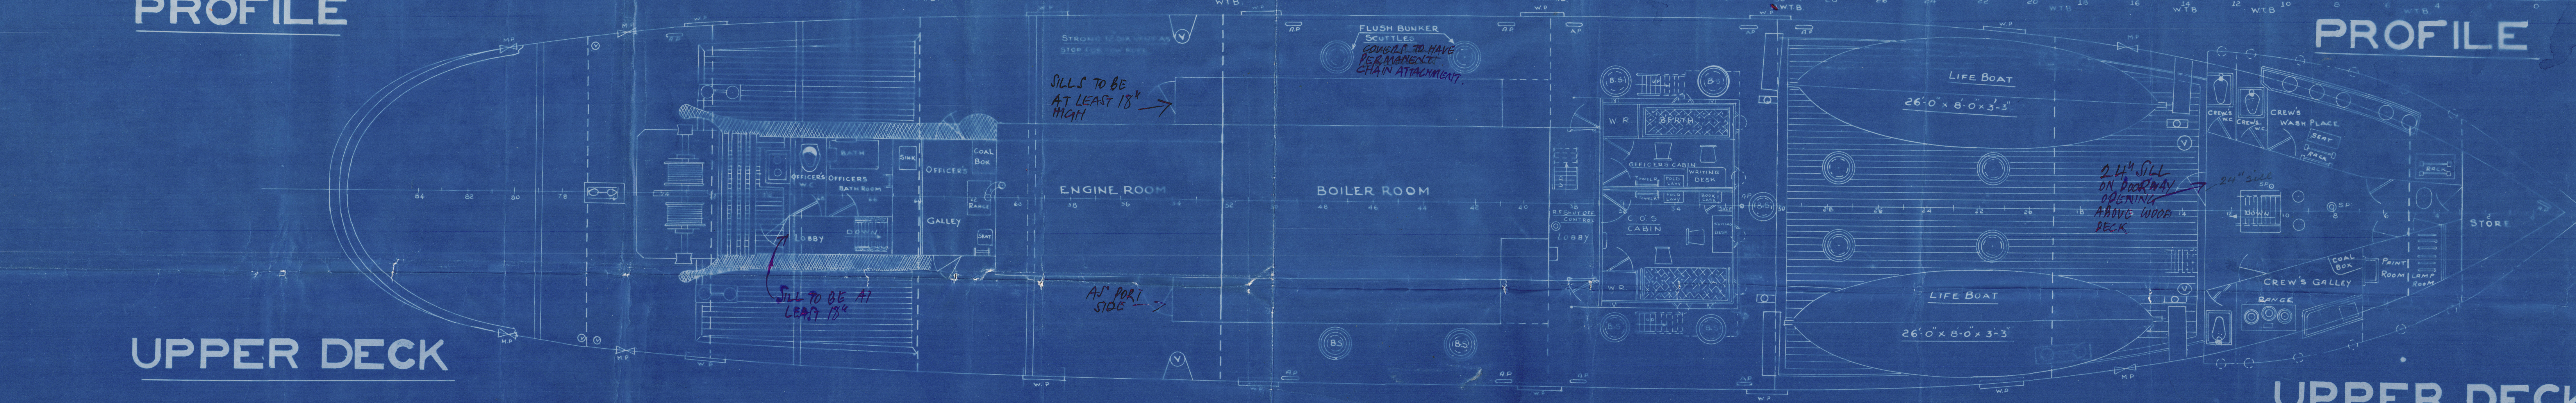

UPPER DECK




LOWER DECK

HOLD

HOLD


RECORDS DEPT
LONDON

Forma

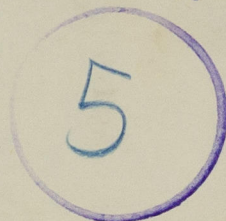

Profile Conversion to Aug.

G/A

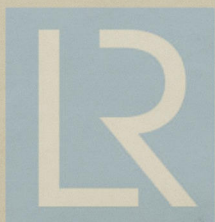

© 2020

Lloyd's Register
Foundation

002659-002666-0003