


27 NOV 1944

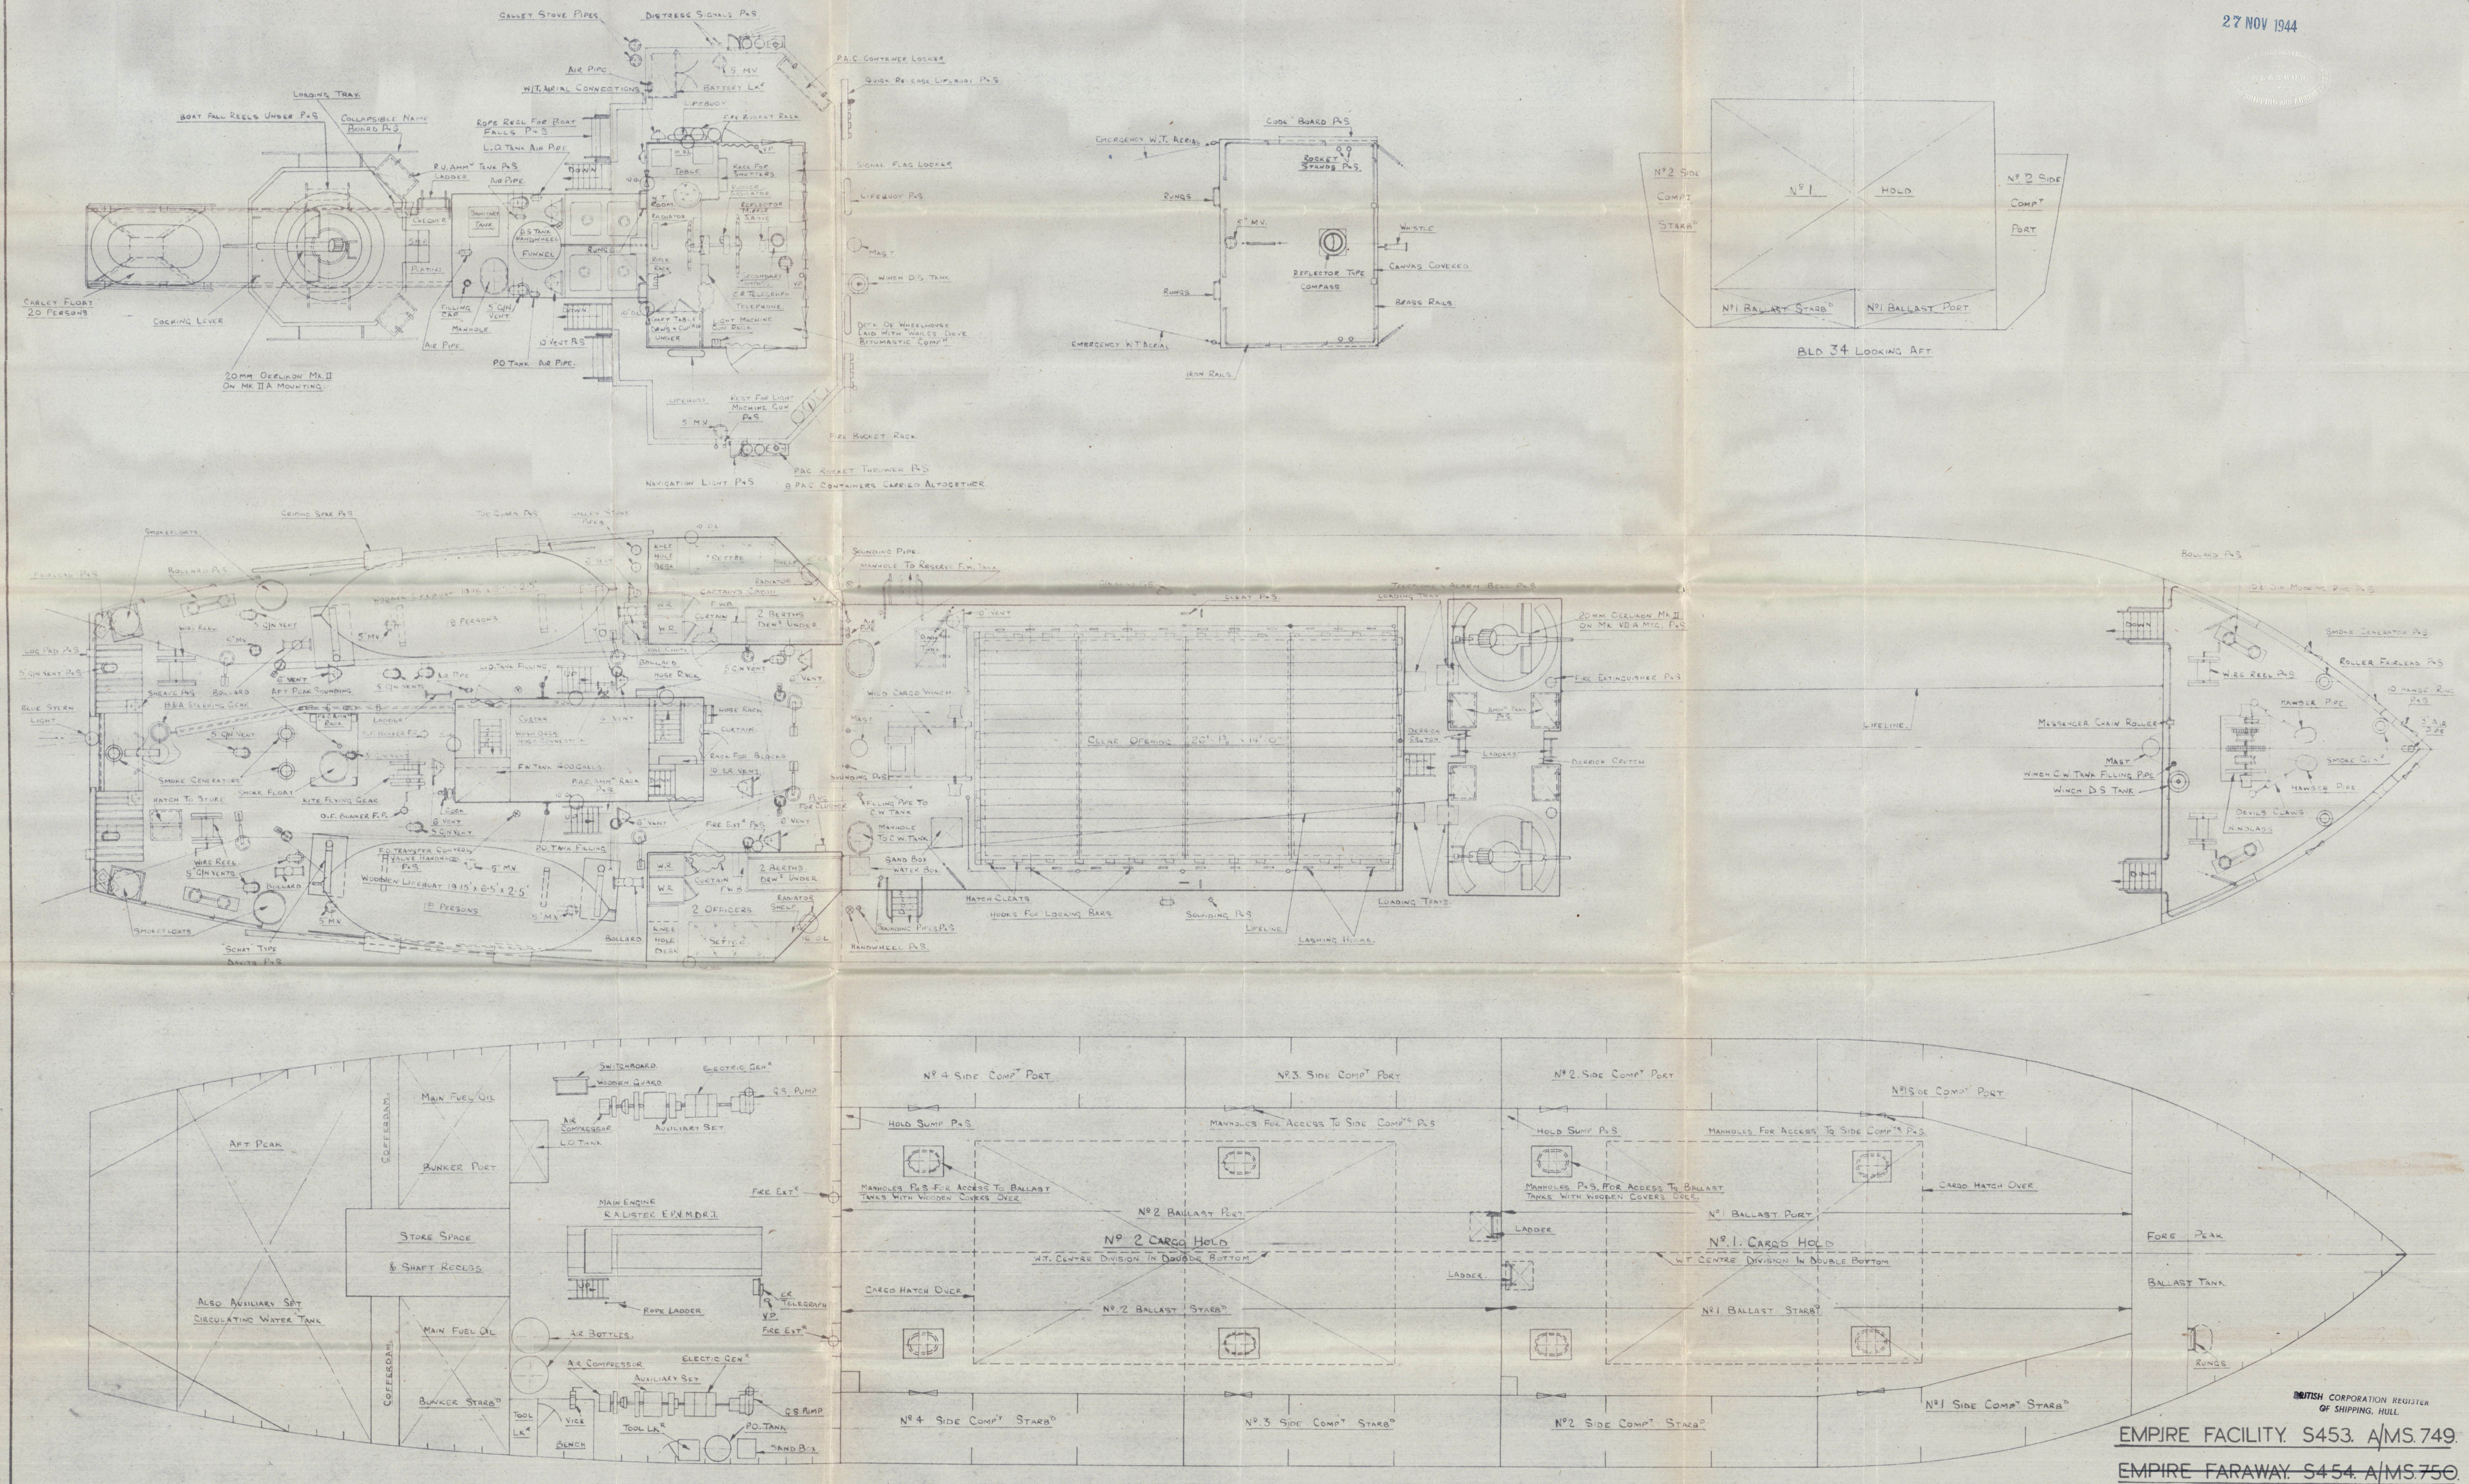

**RICHARD DUNSTON LTD.**

SHIPBUILDERS,

THORNE, YORKSHIRE

DRAWN BY	DATE	This Drawing and the Information it contains are the Property of RICHARD DUNSTON LTD. It is not to be Traced, Copied or Published without their Written Consent, nor is the Information thereon to be misused in any way.	
TRACED BY	DATE		
CHECKED BY	DATE		
REVISIONS			
No.	DATE	PARTICULARS	

YARD No. S453/4

TITLE: GENERAL ARRANGEMENT (As Fitted)

SCALE: 1/4" TO ONE FOOT

DRG. No. 4525/E.718

© 2020 Lloyd's Register Foundation

EMPIRE FACILITY S453. A/MS.749

EMPIRE FARAWAY S454. A/MS.750

002659-002666-0032

1

General Airt - Deck

27 NOV 1944

R Dunston Ltd

H. Scarr Ltd L. 453.

EMPIRE FACILITY NOW FLEXITY.



© 2020 (2)  
S 453  
Lloyd's Register  
Empire Facility  
Foundation

002659-002666-0032