

SCALE :- $\frac{1}{2}" = \text{ONE FOOT.}$

DIMENSIONS :- 238'-0" L.W.L. x 38'-1" BREADTH MLD. x 18'-6" DEPTH MLD. TO U.D.K. (+ 4'-3" R.Q.D.K.)

BLOCK COEFF. ----- .766

TO LLOYDS SURVEY : CLASS + 100 A.I. WITH FREEBOARD CORRESPONDING

TO A MOULDED DRAFT OF 16' - 6 1/4" (NEW LOAD LINE RULES)

ALL B. As ARE N.B.S.

EQUIPMENT NUMERAL

$$\underline{L \times (B + D)} = 13,466$$

FORECASTLE (22.125 x 6 x .75) 99.5


BRIDGE (15.75 x 7 = 75) 82.5

RAISED QUARTER DK. (145-125 x 4.25) 617

CASINGS &c. _____ 138

14,403

EQUIPMENT LETTER "P" 1 5/8" CABLE + 1/16" PER OWNERS

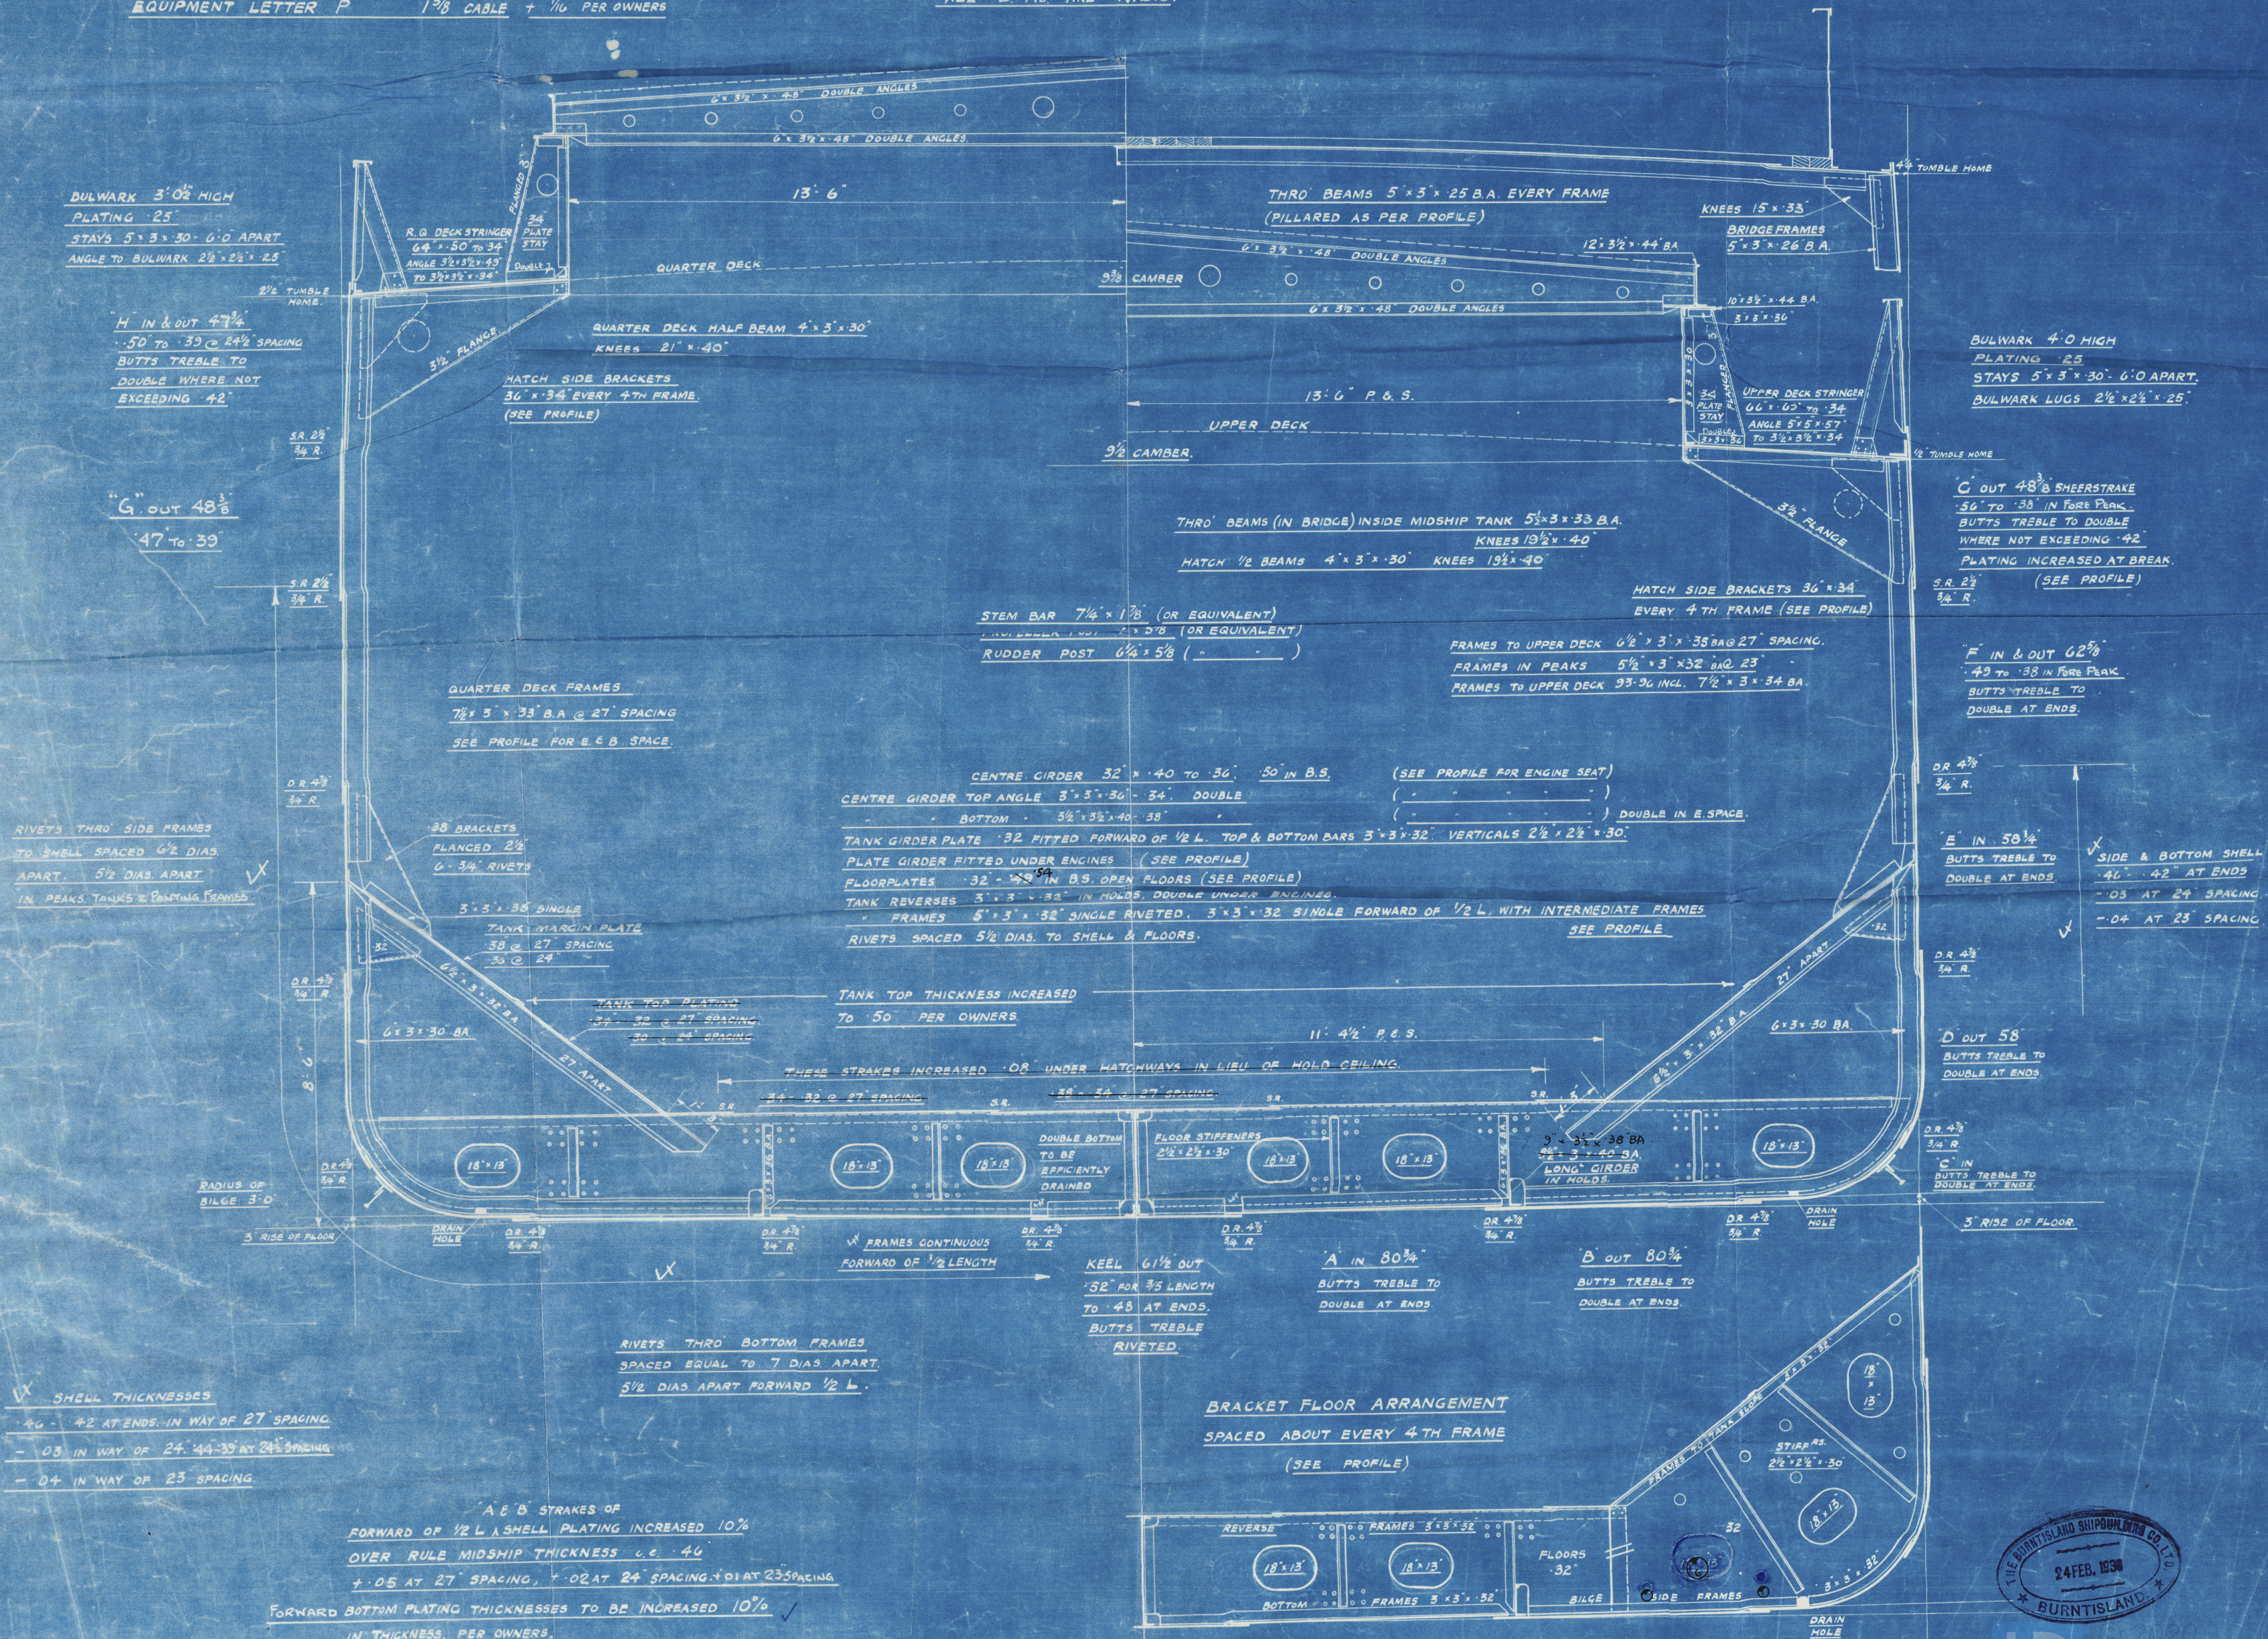

A circular blue ink stamp from The Burntisland Shipbuilding Co. Ltd. The outer ring contains the company name. The center features the date "24 FEB. 1938" flanked by two horizontal lines. Two small stars are positioned at the bottom of the circle.

© 2020 Lloyd's Register
002654 002666-0067

THE BURNTISLAND S.B.C. & C.
N^o 193

MIDSHIP SECTION
"showing View as built"

"Fulham"

S^r B. Fulham

Lth Rpt. No 19016

© 2020

Lloyd's Register
Foundation

002659-002666-0067