


allows no battery P.S. to be in  
same transverse plane

5.4.37.  
15.12.37 - 112617  
2.11.38 - 112622

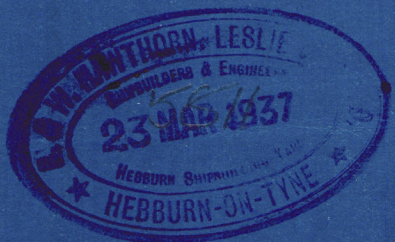

N<sup>os</sup> 611-12

OUTLINE MIDSHIP SECTION

SCALE:  $\frac{1}{2}$ " = 1 FT.

ENCLOSURE TO

LLOYDS

FROM R. & W. HAWTHORN, LESLIE & CO.  
HEBBURN-ON-TYNE.

hatchway P.S. to be in  
same transverse plane.



IN 617. .77 PER LLOYDS LETTER 15/12/37  
IN 611-12. .75 PER LLOYDS LETTER 10/5/37

IN 617. .74 PER LLOYDS LETTER 15/12/37  
IN 611-12. .73 PER LLOYDS LETTER 10/5/37

611-12. .72 PER LLOYDS LETTER  
10/5/37. (617. .72 PER LLOYDS LETTER 10/5/37)

STRINGER PLATE 90" .75 .44  
.84 AT ENDS OF BRIDGE  
.85 AT FRONT OF POOP

86" .58 .36

85" .75 .36

81" .58 .36

65" .74 .36

81" .74 .36

1.00  
K OUT  
56" .37 .50 IN WELLS.  
62 1/2" .87 .9050 IN WAY  
OF POOP, BRIDGE & FGLE.  
1.20 AT ENDS OF BRIDGE  
& FRONT OF POOP.

J IN.  
82 3/4" .76 .50

H OUT  
64 .50

G IN.  
64 .50

F OUT  
64 .50

E IN.  
64 .50

D CLINKER  
64 .50

C CLINKER  
64 .50

B CLINKER  
66 .53

A CLINKER  
67 .53

HEEL OUT  
87" .86" .78



002659-002666-0119



ENCLOSURE TO

LLOYDS

41/02102

FROM R. & W. HAWTHORN, LESLIE & CO.  
HEDDINGTON-TYNE.

IN 617.

74 PER LLOYDS LETTER 15/12/37.

16-6/10/12


73 PER LLOYDS LETTER 10/5/37

*Delalib*  
SHIP No. 611-612-617-622

R. & W. HAWTHORN, LESLIE  
& CO. LTD.

OUTLINE MIDSHIP SECTION

(3)

M.V. "Daphnella" 

NEWCASTLE ON TYNE.

Report No. 96399.

M.V. "Doryssa"


NEWCASTLE ON TYNE.

Report No. 96601.

M.V. "Doronia"

NEWCASTLE ON TYNE.

Report No. 97224.

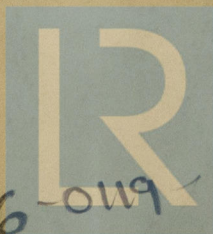

© 2020

Lloyd's Register  
Foundation

002659-002666-0119