
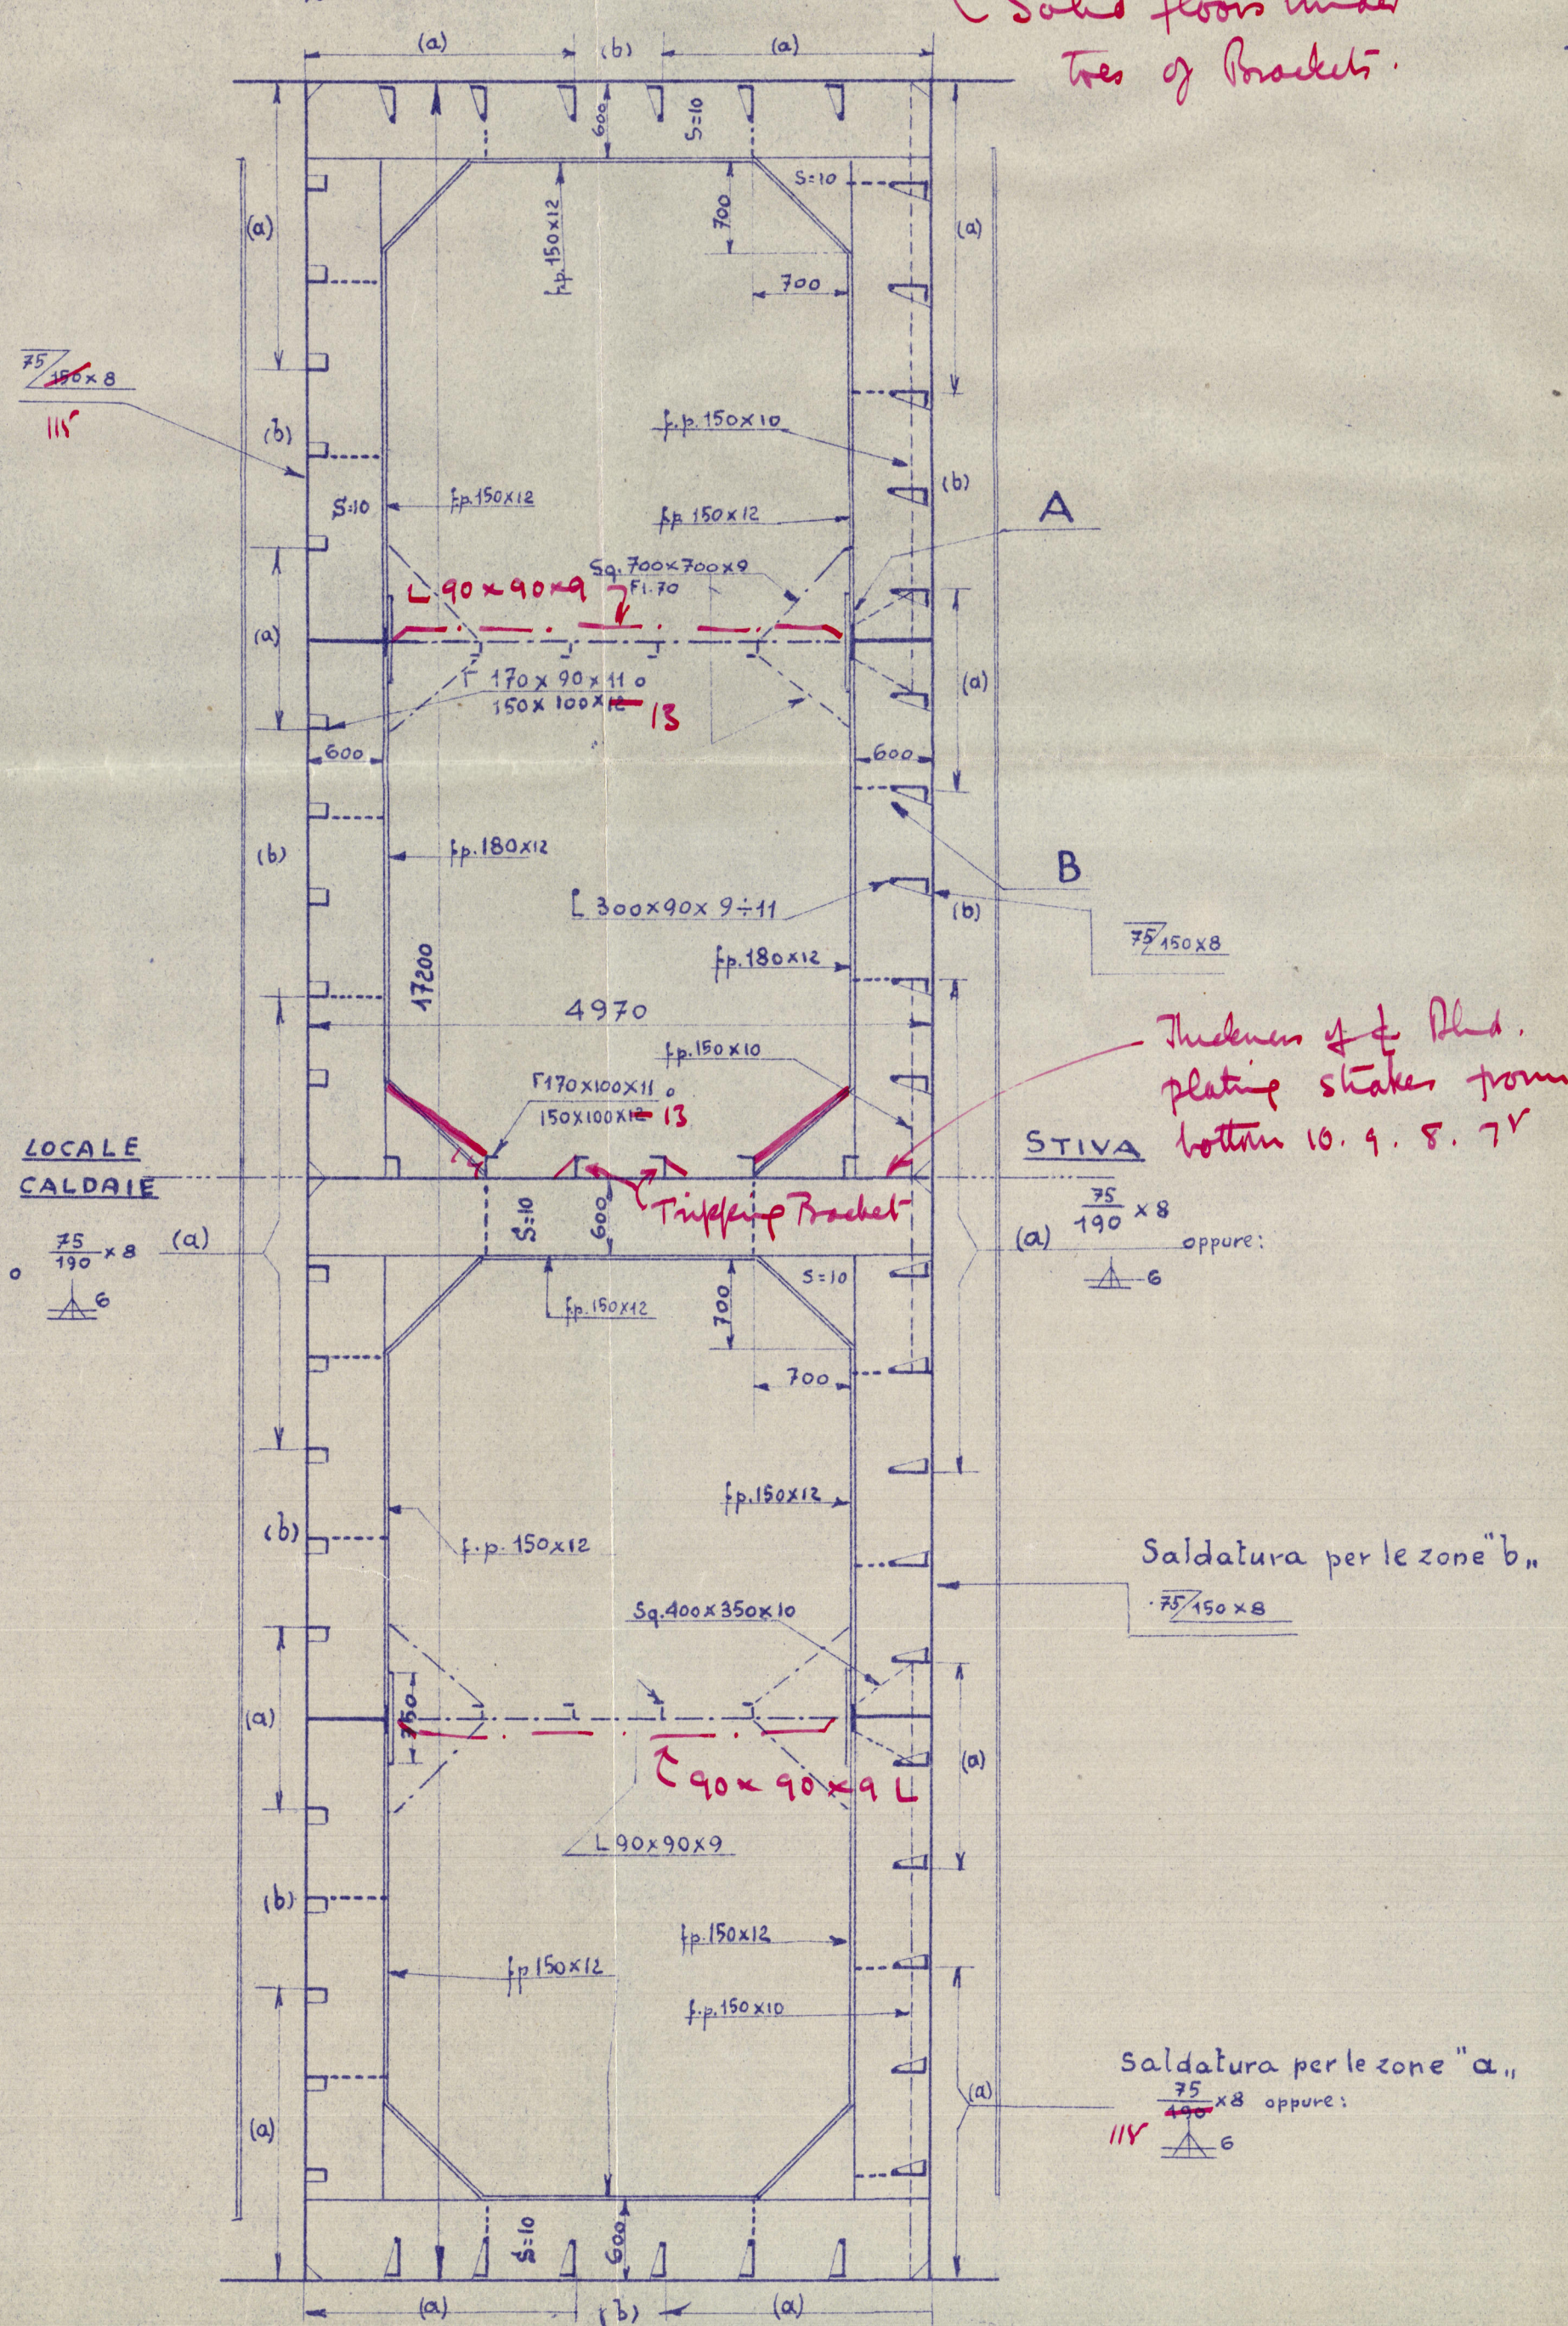
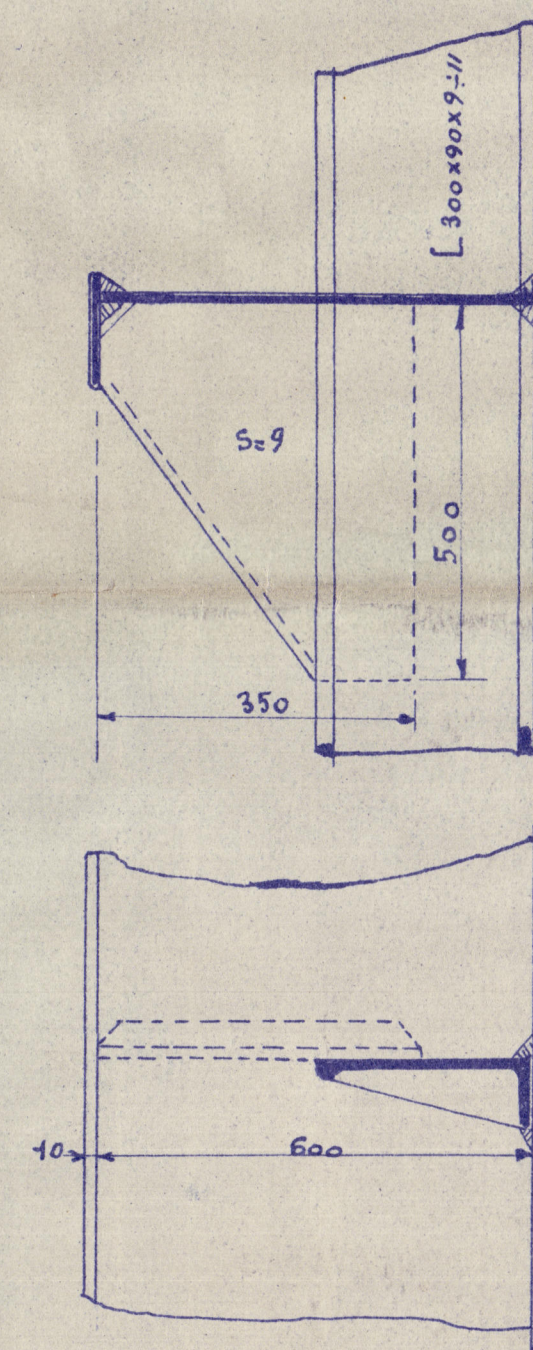


Paratia ord. 96  
guard. AD


Paratia ord. 103  
guard. AV

Particolare A

Particolare B

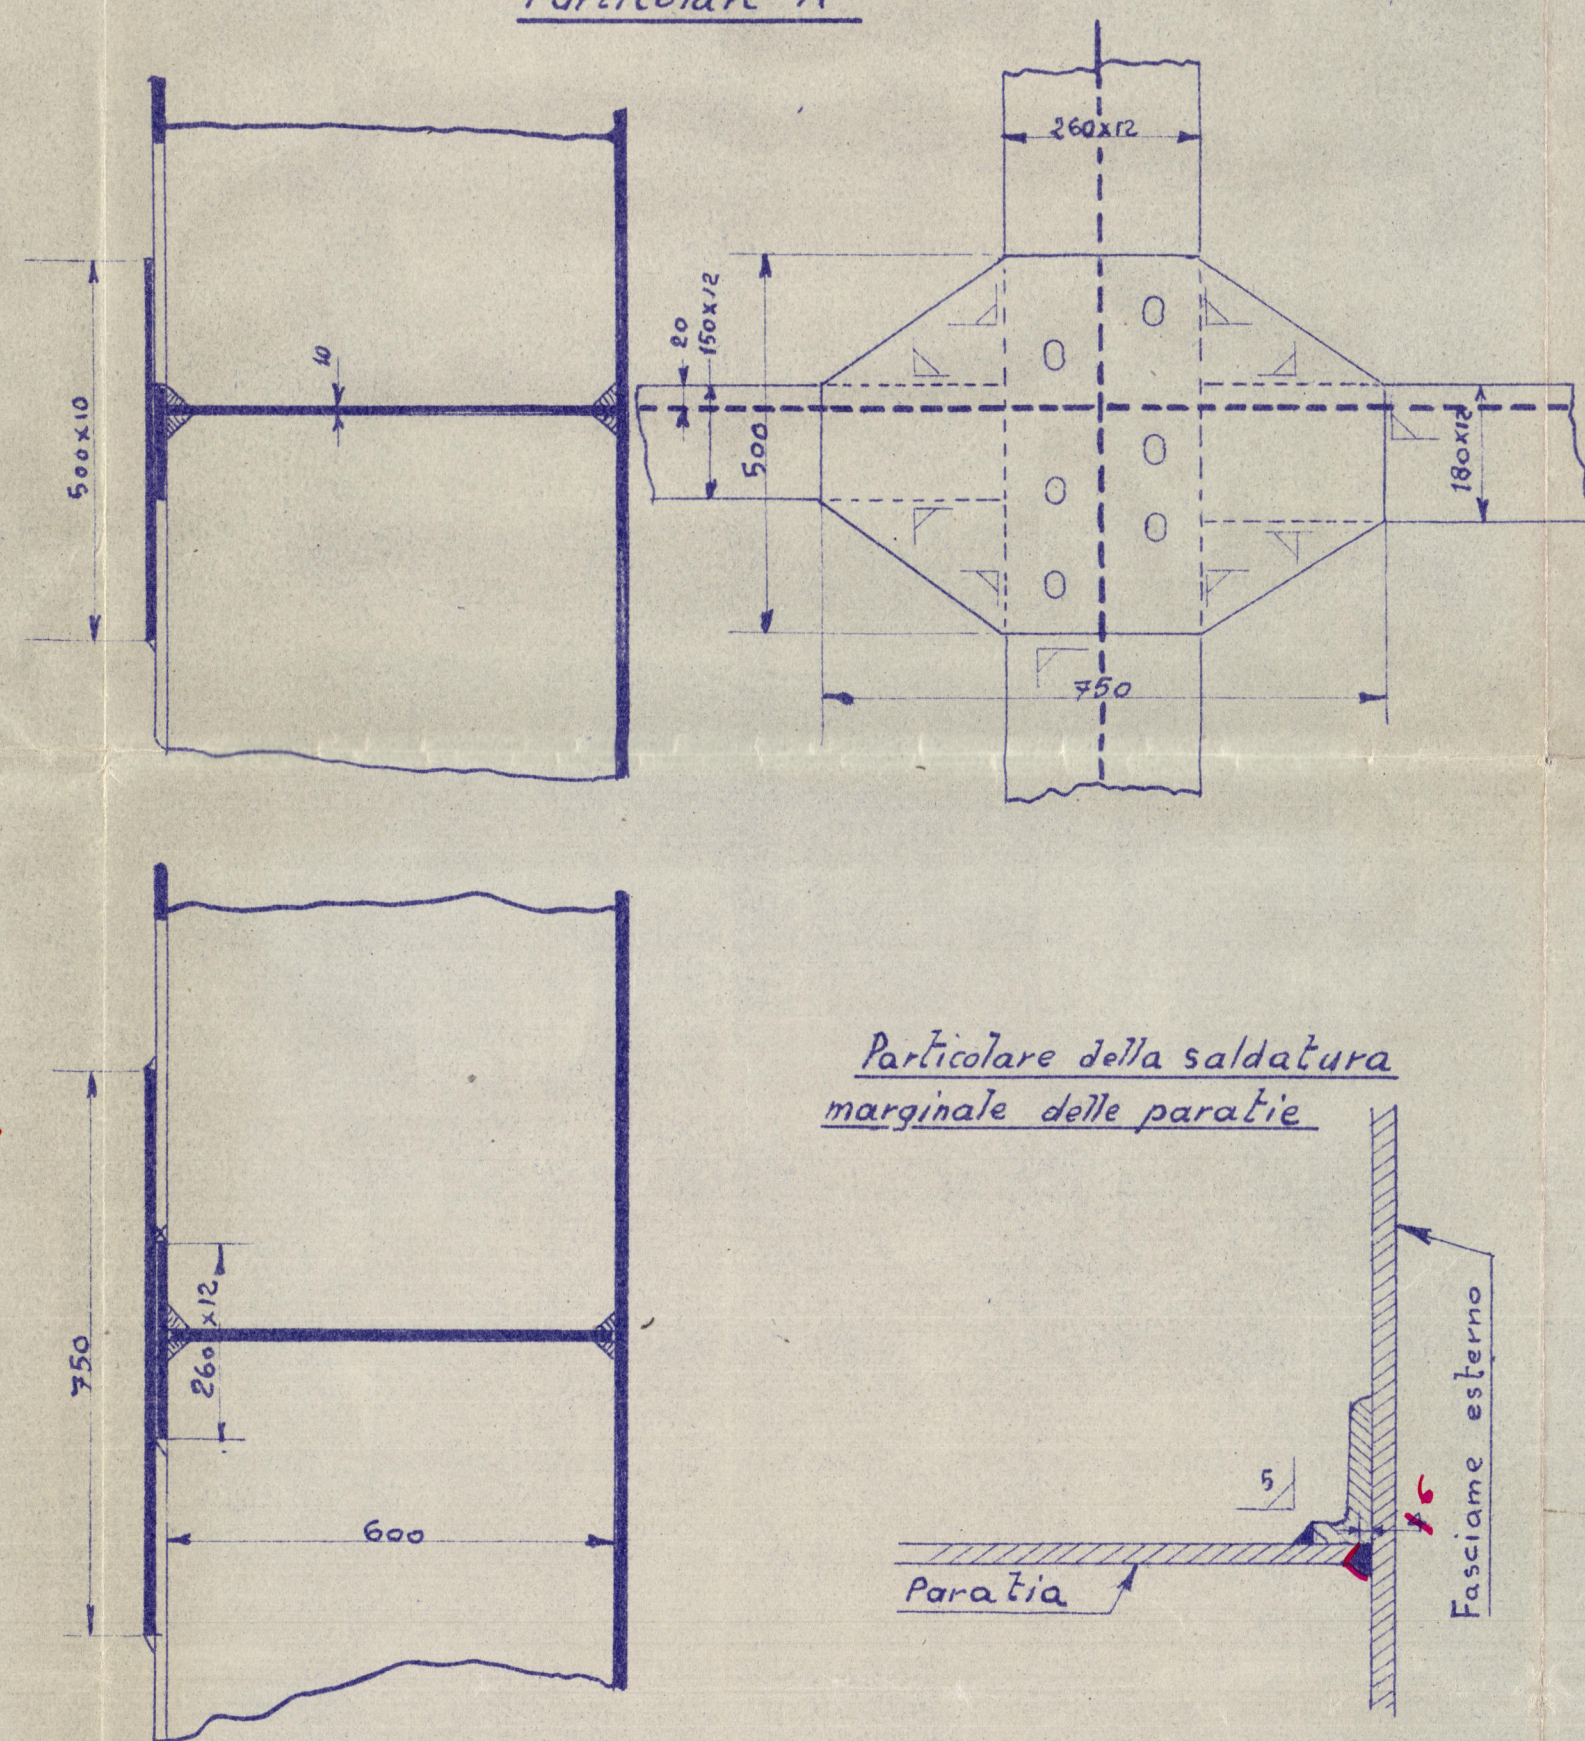

Particolare della saldatura marginale delle paratie

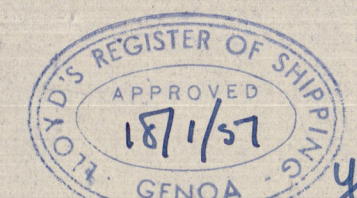

FLASH POINT OF OIL FUEL TO BE ABOVE 65.5° C. AND REMAINING REQUIREMENTS OF SECTION 20 OF THE RULES, WHERE APPLICABLE, TO BE COMPLIED WITH.

SAN GIORGIO DEL PORTO  
GENOVA

3% CAMPANIA Gen. 18050	DIS N° 468	DIS. SMITH CONTR. LINE.	13.1.1954
STRUTTURA DEPOSITI NAFTA	Scale 1:50 1:10	Lloyd's Register Foundation	

002659-002666-0169

4-XXXX1