


# S. S. 'Aldecoa'.

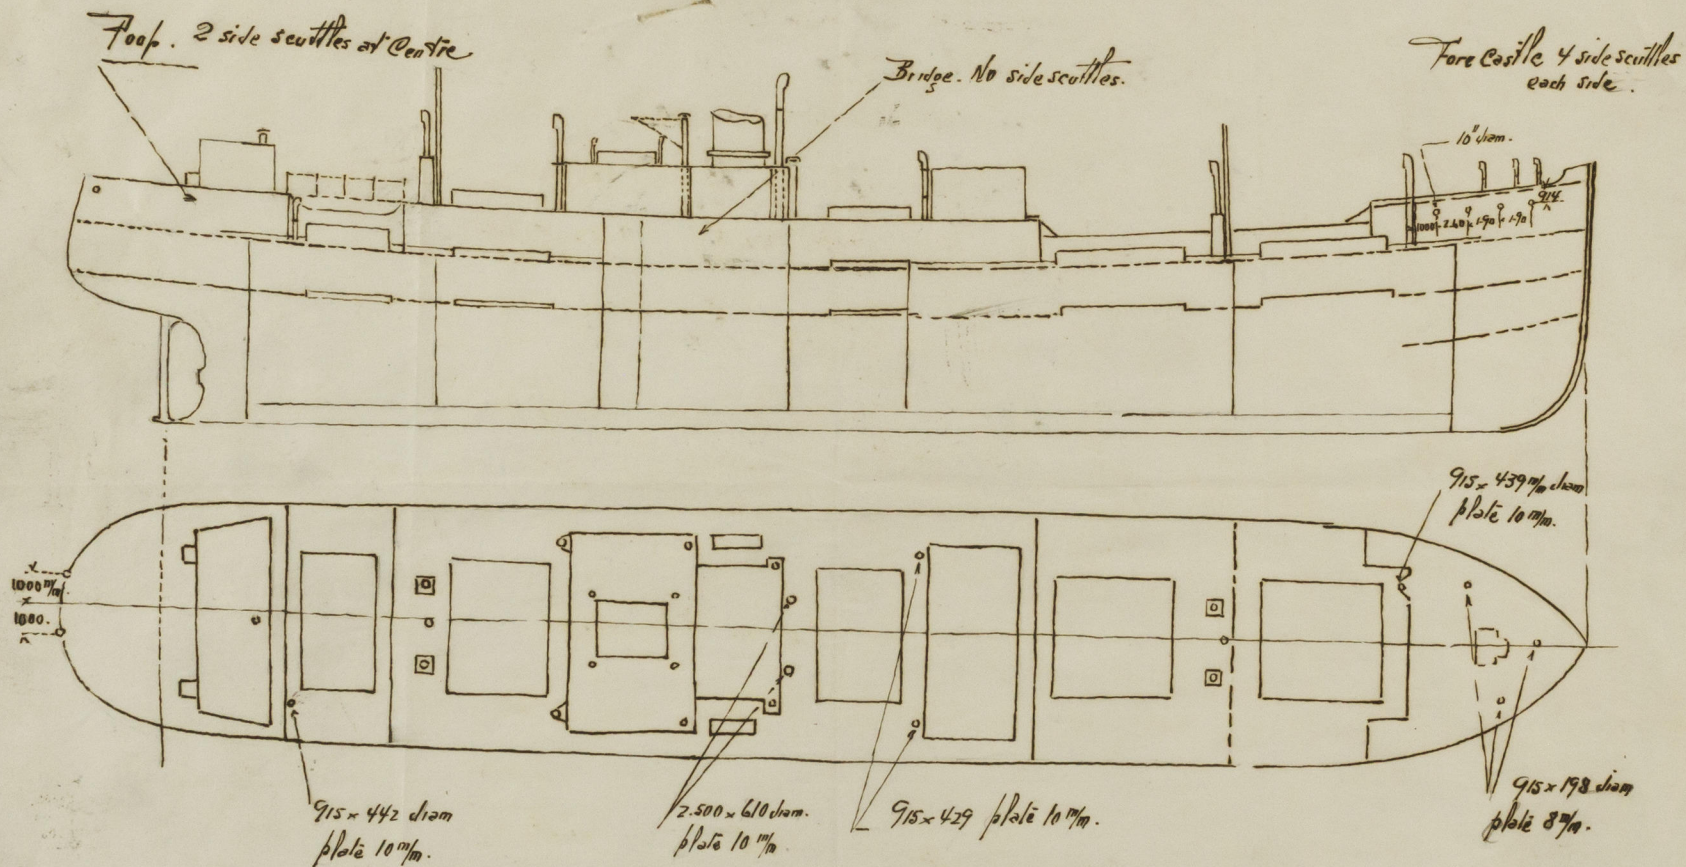

All ventilator Coamings are provided of wood and  
 Side scuttles are provided of strong Canvas Covers.  
 dead light Covers.