

Bull angles assumed
1924 Standard.

FUNNEL SUPPORTED TO
SURVEYORS SATISFACTION

OWNERS INCREASES (NOT INCLUDED)
STEAKS BELOW SHEERSTRAKE .02" THICKER FOR 1/2 LENGTH
COLLISION W.T. BULKHEAD AT AFT END OF HOLD TO BE
.04" THICKER FOR ABOUT 6'0" UP FROM TOP OF CEILING
FLOORS, INTERCOSTALS & REVERSE FRAMES IN BOILER ROOM
TO BE .04" THICKER.

SUPPORT OF MAST, WINDLASS, WINCHES AND
STEERING GEAR TO SURVEYORS SATISFACTION

ENGINE - BOILER CASING
COMING .30" PLATING .26" STIFFENERS 3" x 2 1/2" x 30"
SPACED 30" APART

DETAIL OF BREAK TO
BE SUBMITTED

when diaphragm
arrangements will be
considered

End coamings to
be stiffened and
supported

FORE END STIFFENING
TO BE SUBMITTED



When arrangements
will be considered

Common Store
to be submitted

Sec 16
par 7

Continuity of strength
to be maintained w.p. ceiling

Bottom strengthening as
per Sec 11

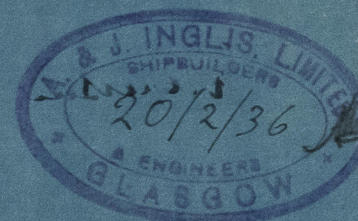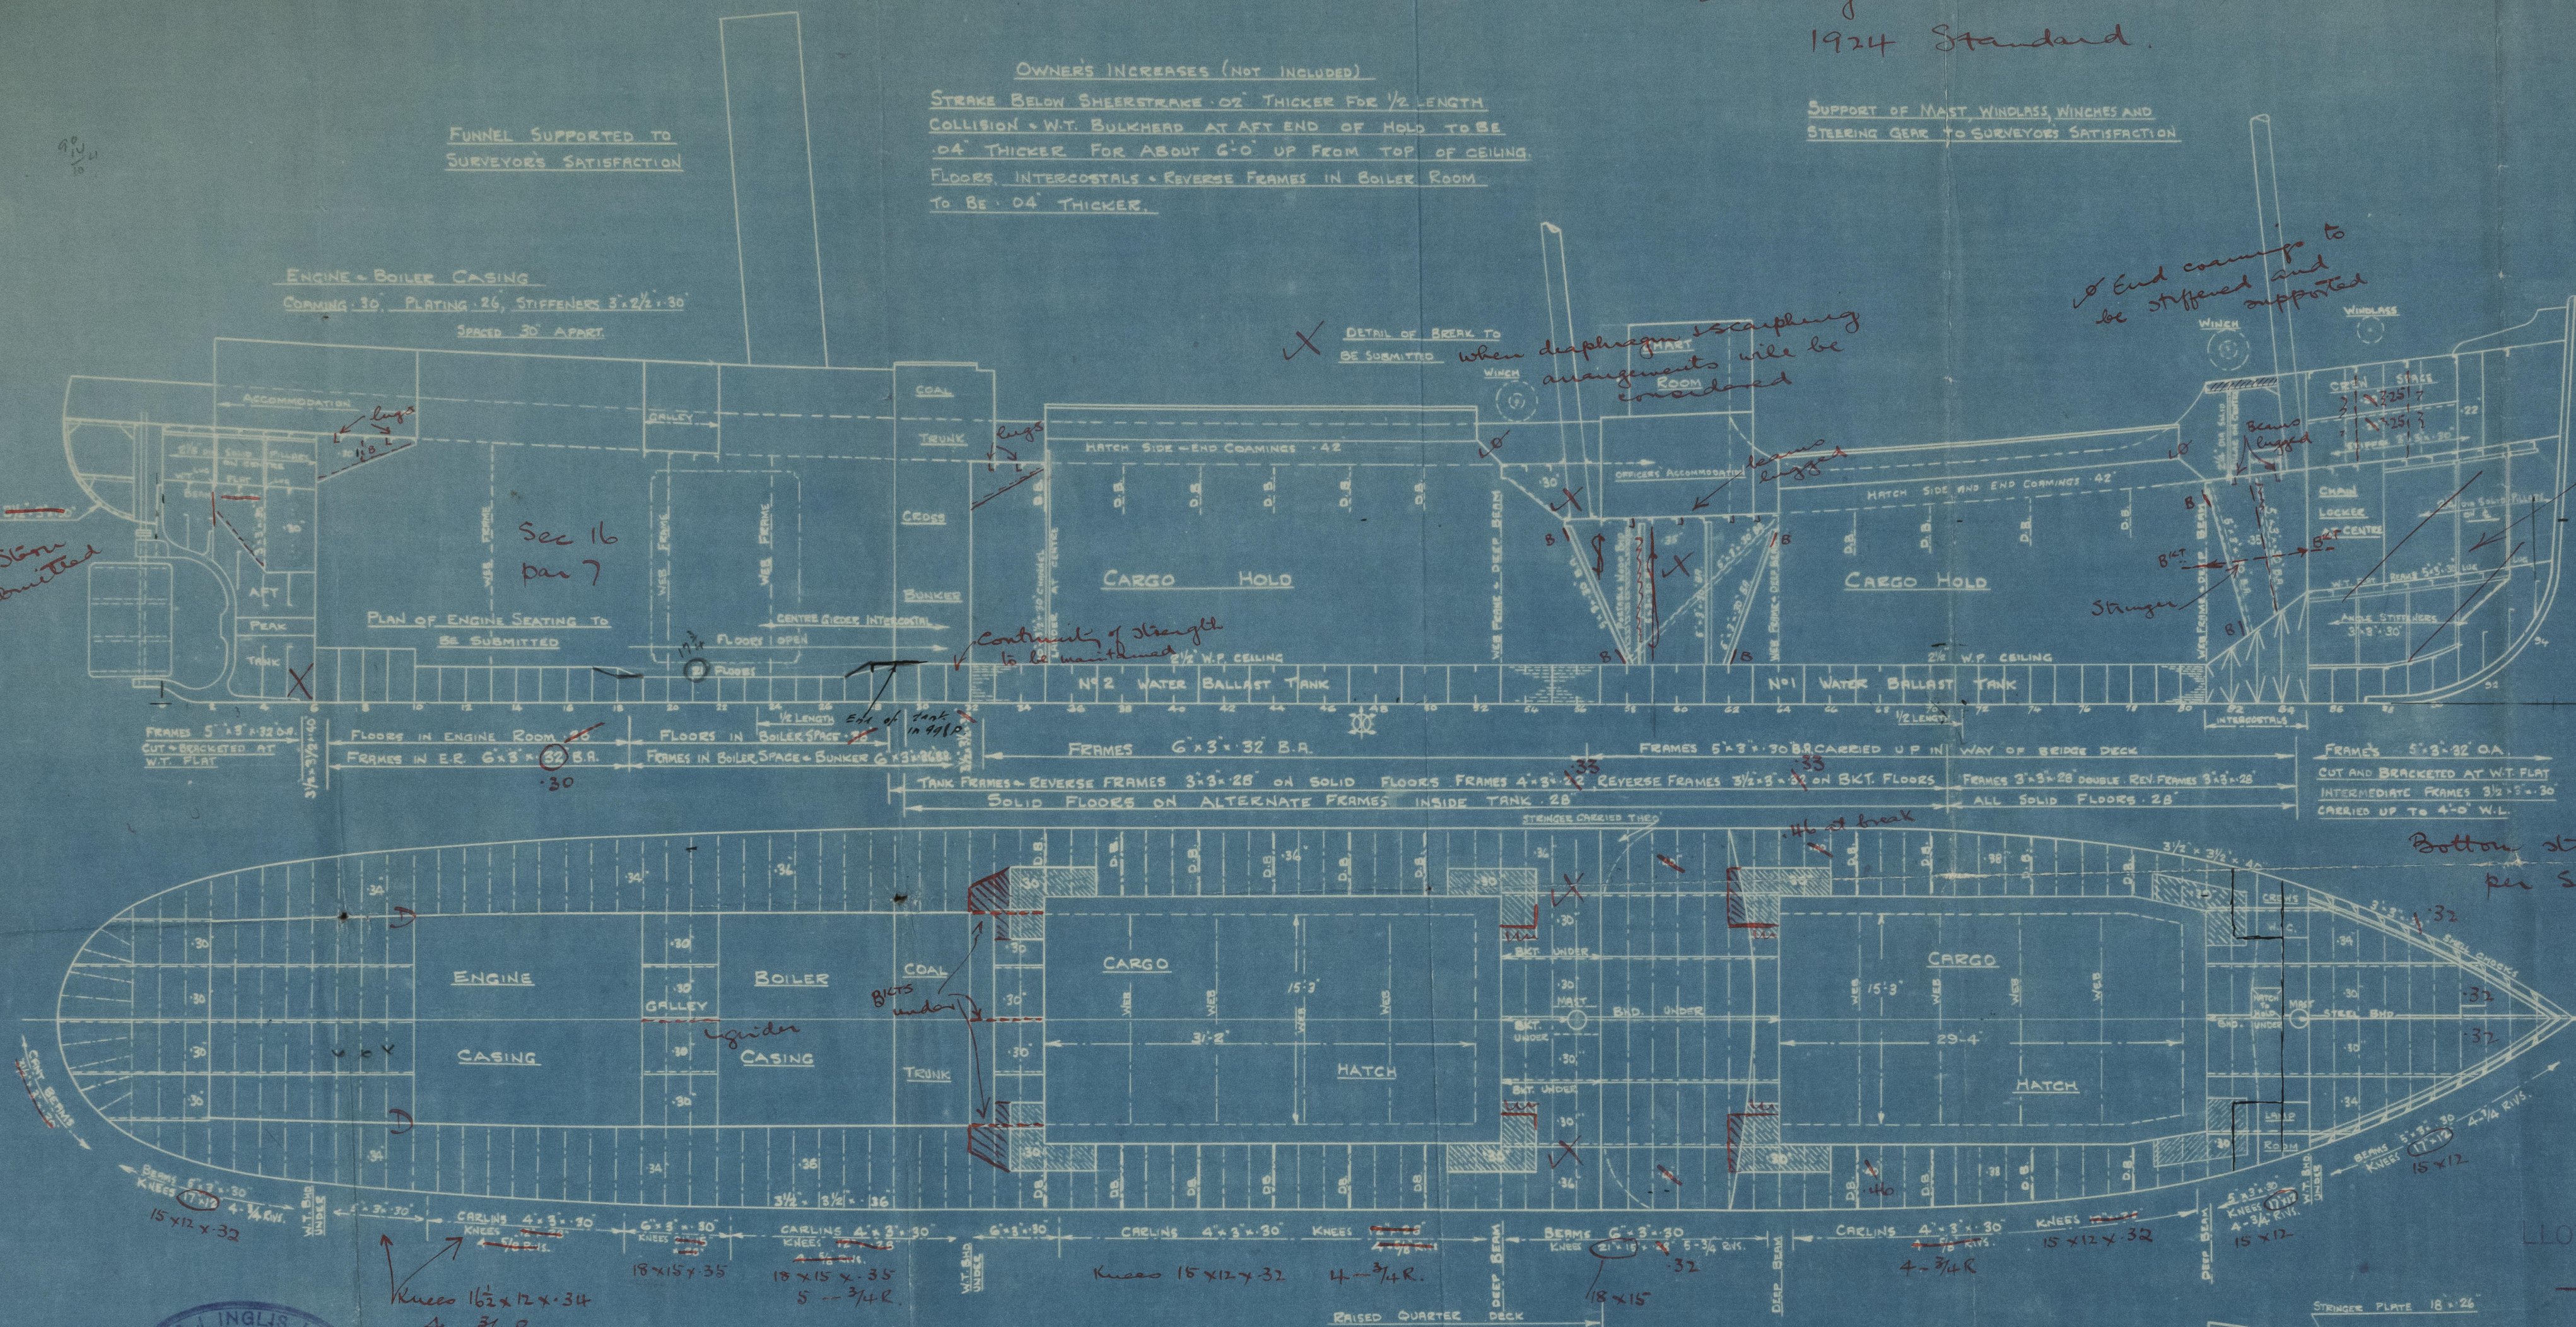


No 988P / 998P

LONGITUDINAL SECTION AND DECKS

SCALE: 1/8" = 1 FOOT

DIMENSIONS:- 175'0" B.P. x 27'9" MLD. BREADTH x 13'4 1/2" DEPTH MLD. TO UPPER DK. 17'4 1/2" TO QUARTER DK.

d	UPPER DECK	10.625
d	QUARTER DECK	14.625
L/D	UPPER DECK	13.08
L/D	QUARTER DECK	10.07
L x D		2340.63
L x (B + D)		7196.88

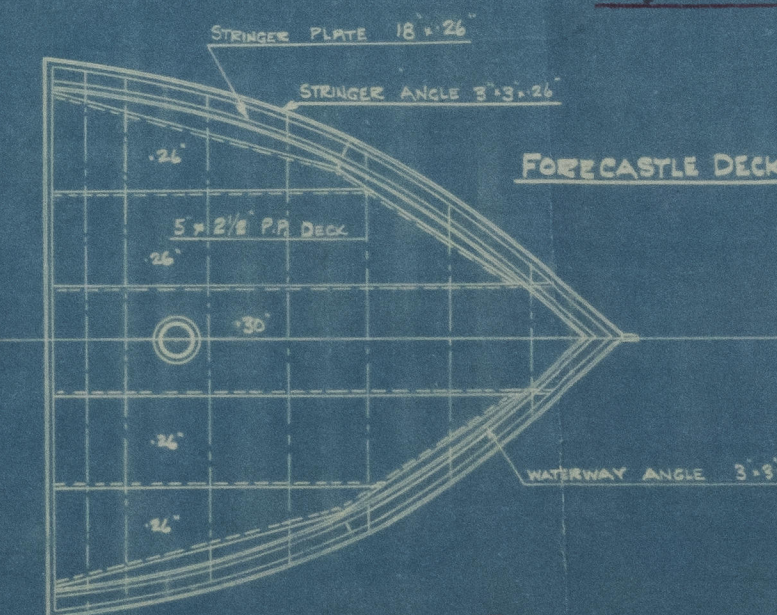

APPROVED for 998P
LLOYD'S REGISTER OF SHIPPING

Heckers

DATE 26/11/36

APPROVED

LLOYD'S REGISTER OF SHIPPING

Heckers

DATE 27/2/36

002667-002673-0083

2

Glasgow

Messrs. A. & J. Inglis & Co

Yard 10988 P. / 998 P

longitudinal section and becks.

Yld

GLASGOW REPORT No. 57669

Crossgar (988)

GLASGOW REPORT No. 57753

Yld
GLASGOW REPORT No. 58570

998 Donaghadee
GLASGOW REPORT No. 58845

Lloyd's Register
Foundation

002667-002673-0083