


N^o 988^o / 998P
 STERNFRAME & RUDDER
 SCALE 1"=1'-0"

NOTE To BE BEST FORGED SCRAP IRON TO LLOYD'S TESTS
 RIVET HOLES TO BE BORED 1/16" MORE THAN DIA. OF RIVET

LLOYD'S PARTICULARS

2ND LONGITUDINAL H ^o	7197
TOTAL AREA OF RUDDER	57.9 sq. ft.
C.G. OF ABOVE (AHEAD CENTRE)	1.57
SPEED NOT EXCEEDING 10 KNOTS	

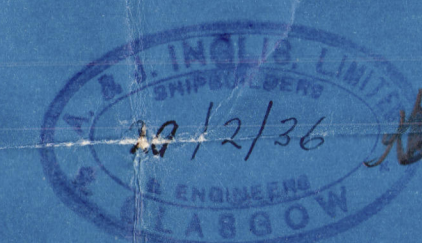

N^o 988P



APPROVED for 998P
 LLOYD'S REGISTER OF SHIPPING
 H. Williams
 DATE 26/11/36

APPROVED
 LLOYD'S REGISTER OF SHIPPING
 H. Williams
 DATE 28.2.36


3

Glasgow

Messrs. A. J. Inglis Ltd

Yard No 988P / 998P

Stemframe Rudder

 Crossgar (988)
GLASGOW REPORT No 57753

998 DONAGHADEE
GLASGOW REPORT No 58845



© 2020

Lloyd's Register
Foundation

002667-002673-0084