


N. 10.30

Nº 1465.

PROFILE & DECKS.

Dims: 485'0BP x 65'5" B.M. x 36'9" DM.

Scale: $\frac{1}{16}$ = 1 foot.

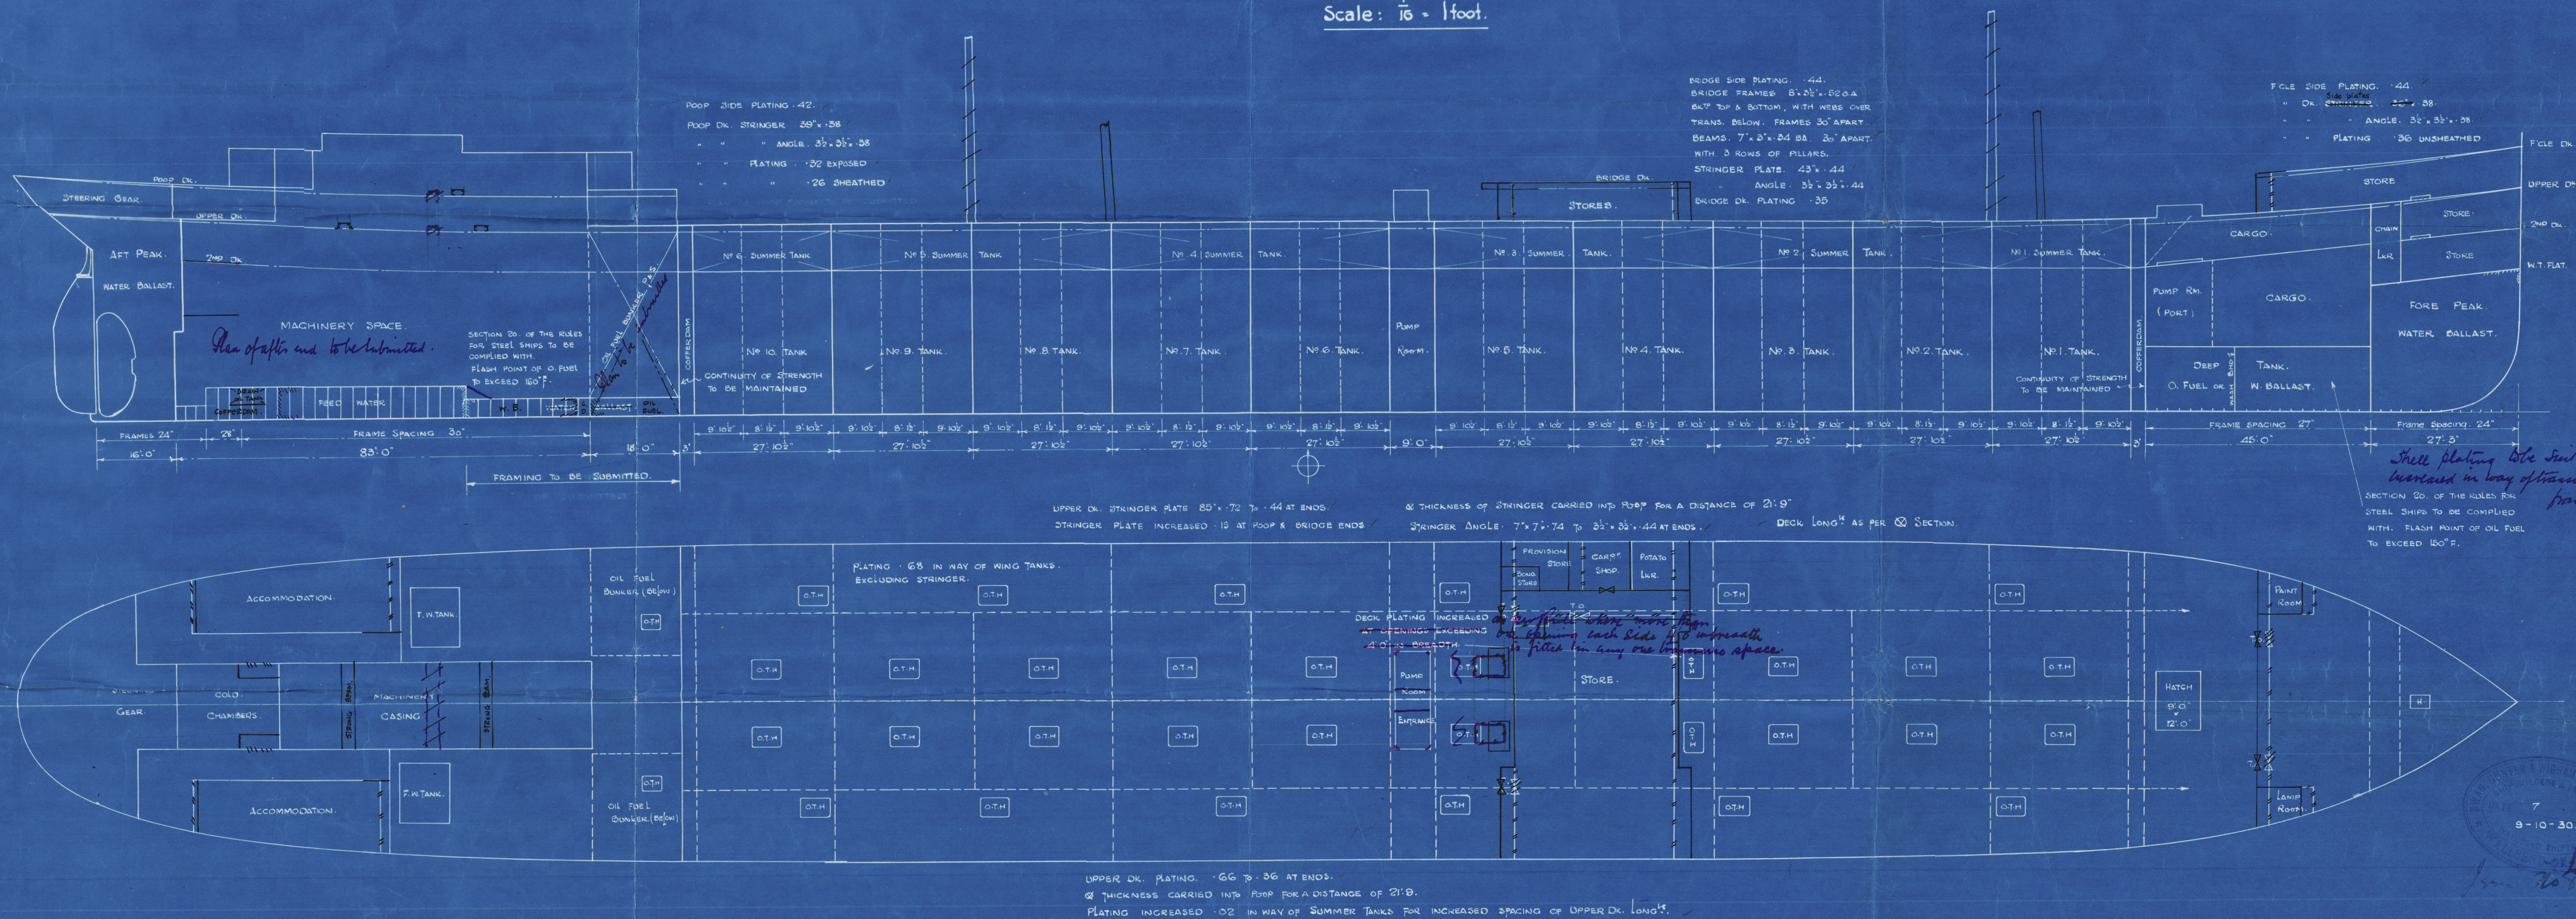

(2)

CAPTAIN JOHN

Swan Hunter.

No. 1465-


Profile & decks.

Eso Aruba

M.V. "PAN BOLIVAR"

NEWCASTLE ON TYNE.

Report No. 8735A

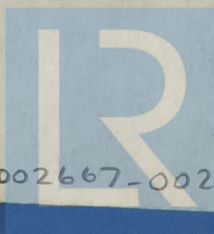

© 2020

Lloyd's Register
Foundation

002667-002673-0145

