


Nº 1465,
AFTER END FRAMING.

DIMENSIONS:- 483'0" x 65'3" MLD x 36'9" MLD

HALF SECTION AT FRAME № 14

INTERCOSTALS UNDER ENGINES
TO BE ARRANGED TO SUIT ENGINEERS
& SURVEYORS REQUIREMENTS.
to be submitted

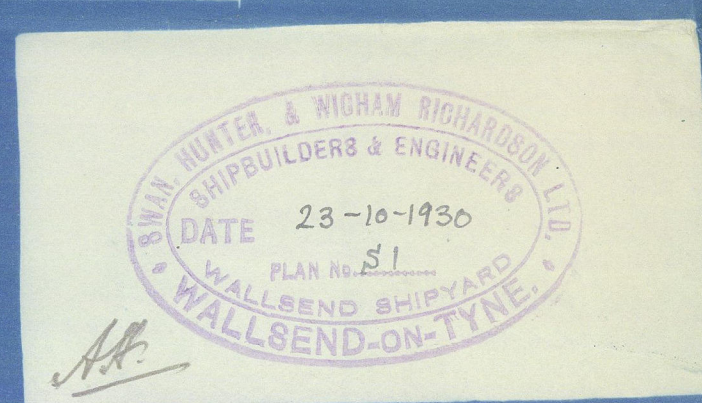

(4)

Swan Hunter.


No 1465-
" "

Aft end framing.
" "

M.V. "PAN BOLIVAR"

NEWCASTLE ON TYNE.

Report No. 87354

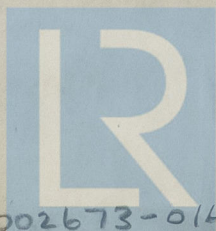

© 2020

Lloyd's Register
Foundation

002667-002673-0147