

8

Stem & Sternframe

Howdedge Ironworks Co.

No. 4170.

22-6-21.

" $\frac{1}{2}$ " BEN SADLER"



© 2020


Lloyd's Register
Foundation

002667-002673-0229

Item of Stern frame

Rowledge H40.

bag.

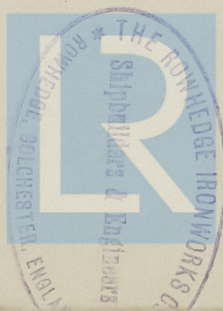

© 2020

Lloyd's Register
Foundation