
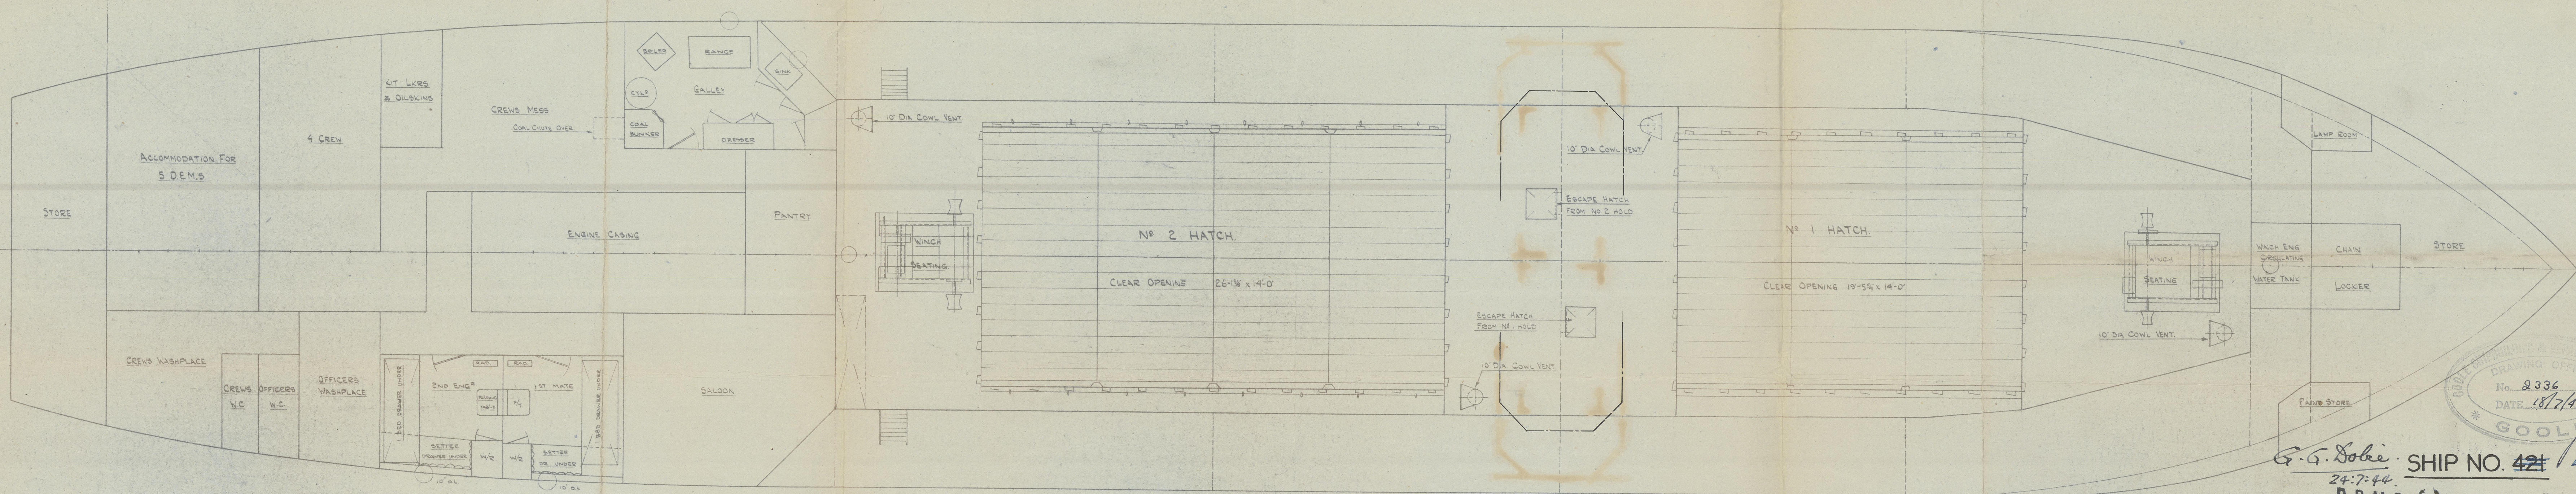


FOR GENERAL DETAILS SEE GENERAL ARRANGEMENT  

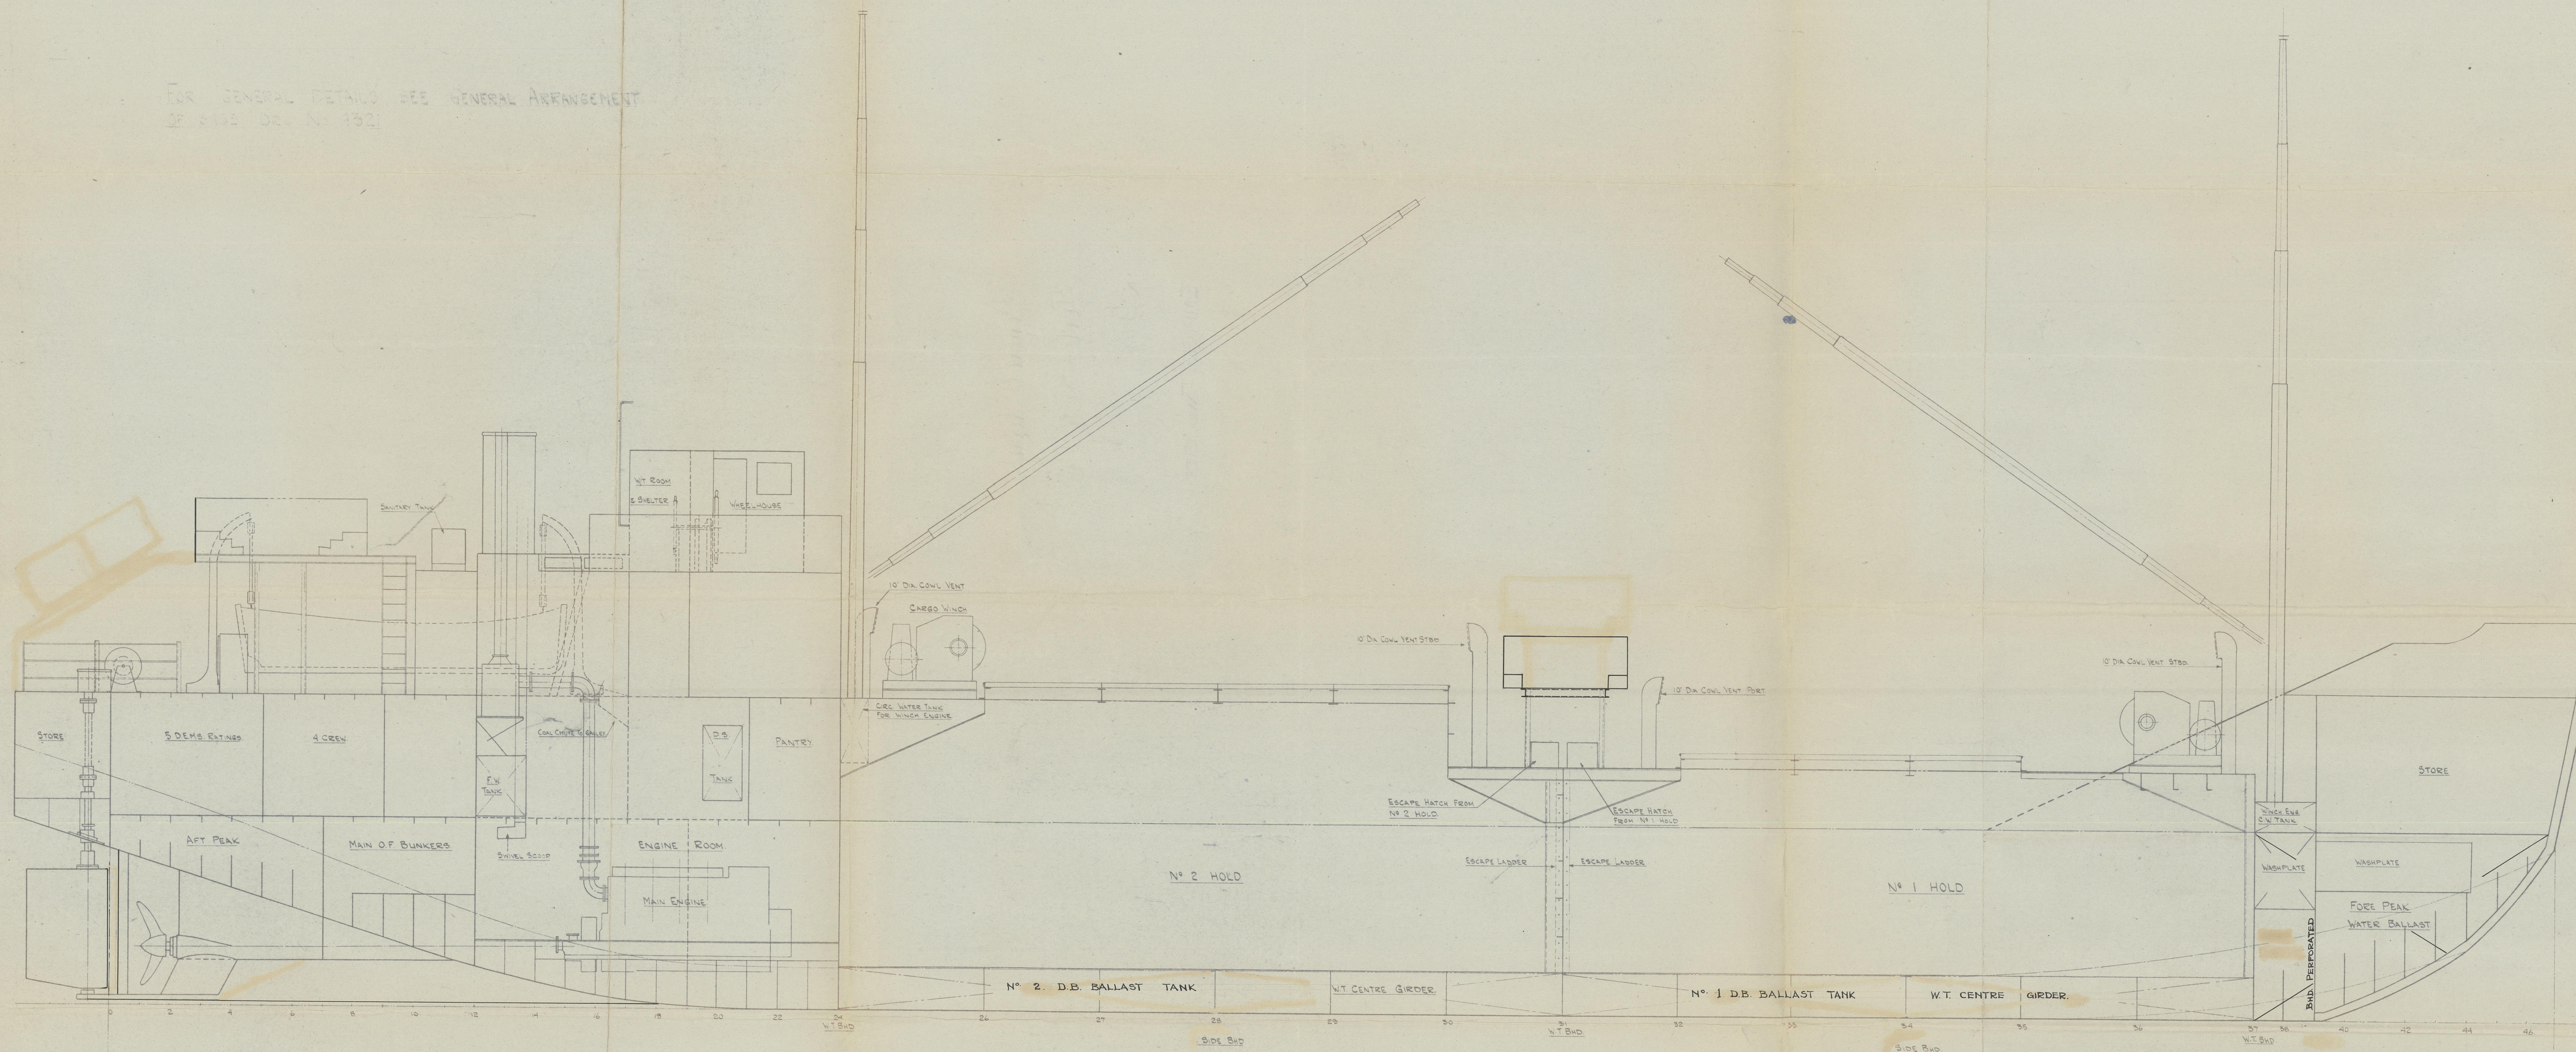

DDm.p.  
DRAWING OFFICE  
No. 2336  
DATE 18/7/44  
SHIP NO. 421 419  
D.D.M.B. (H)

GOOLE SHIPBUILDING & REPAIRING CO. LTD.

GOOLE. YORKSHIRE.

DRY CARGO CARRIERS.  
YARD Nos. 417/424 & 430/434.

GENERAL ARRANGEMENT.

SCALE 1/4" = TO ONE FOOT

002682-002689-0013

© 2021 Lloyd's Register  
BCT



1.

General Wright  
Goole Dr R Co.

No 419.

✓

EMPIRE FAVOURITE <sup>now</sup> FORMALITY



Empire Favourite  
© 2021 G.A.  
Lloyd's Register  
Goole 419  
Foundation