


S.S. N° 100.
• STEEL SCREW TRAWLER •
- PROFILE & DECK -
GLASS LLOYDS 100.A.1 STEAM TRAWLER
- SCALE 1/4" = 1 FOOT -

DIMENSIONS

LENGTH. B.P. 115' 0"
BREADTH. M^d 22' 0"
DEPTH. M^d 12' 9"

FRAME SPACING

FR N°s 0 to 12 SPACED 21" APART
FR N°s 12 to 63 " 21 1/2" "

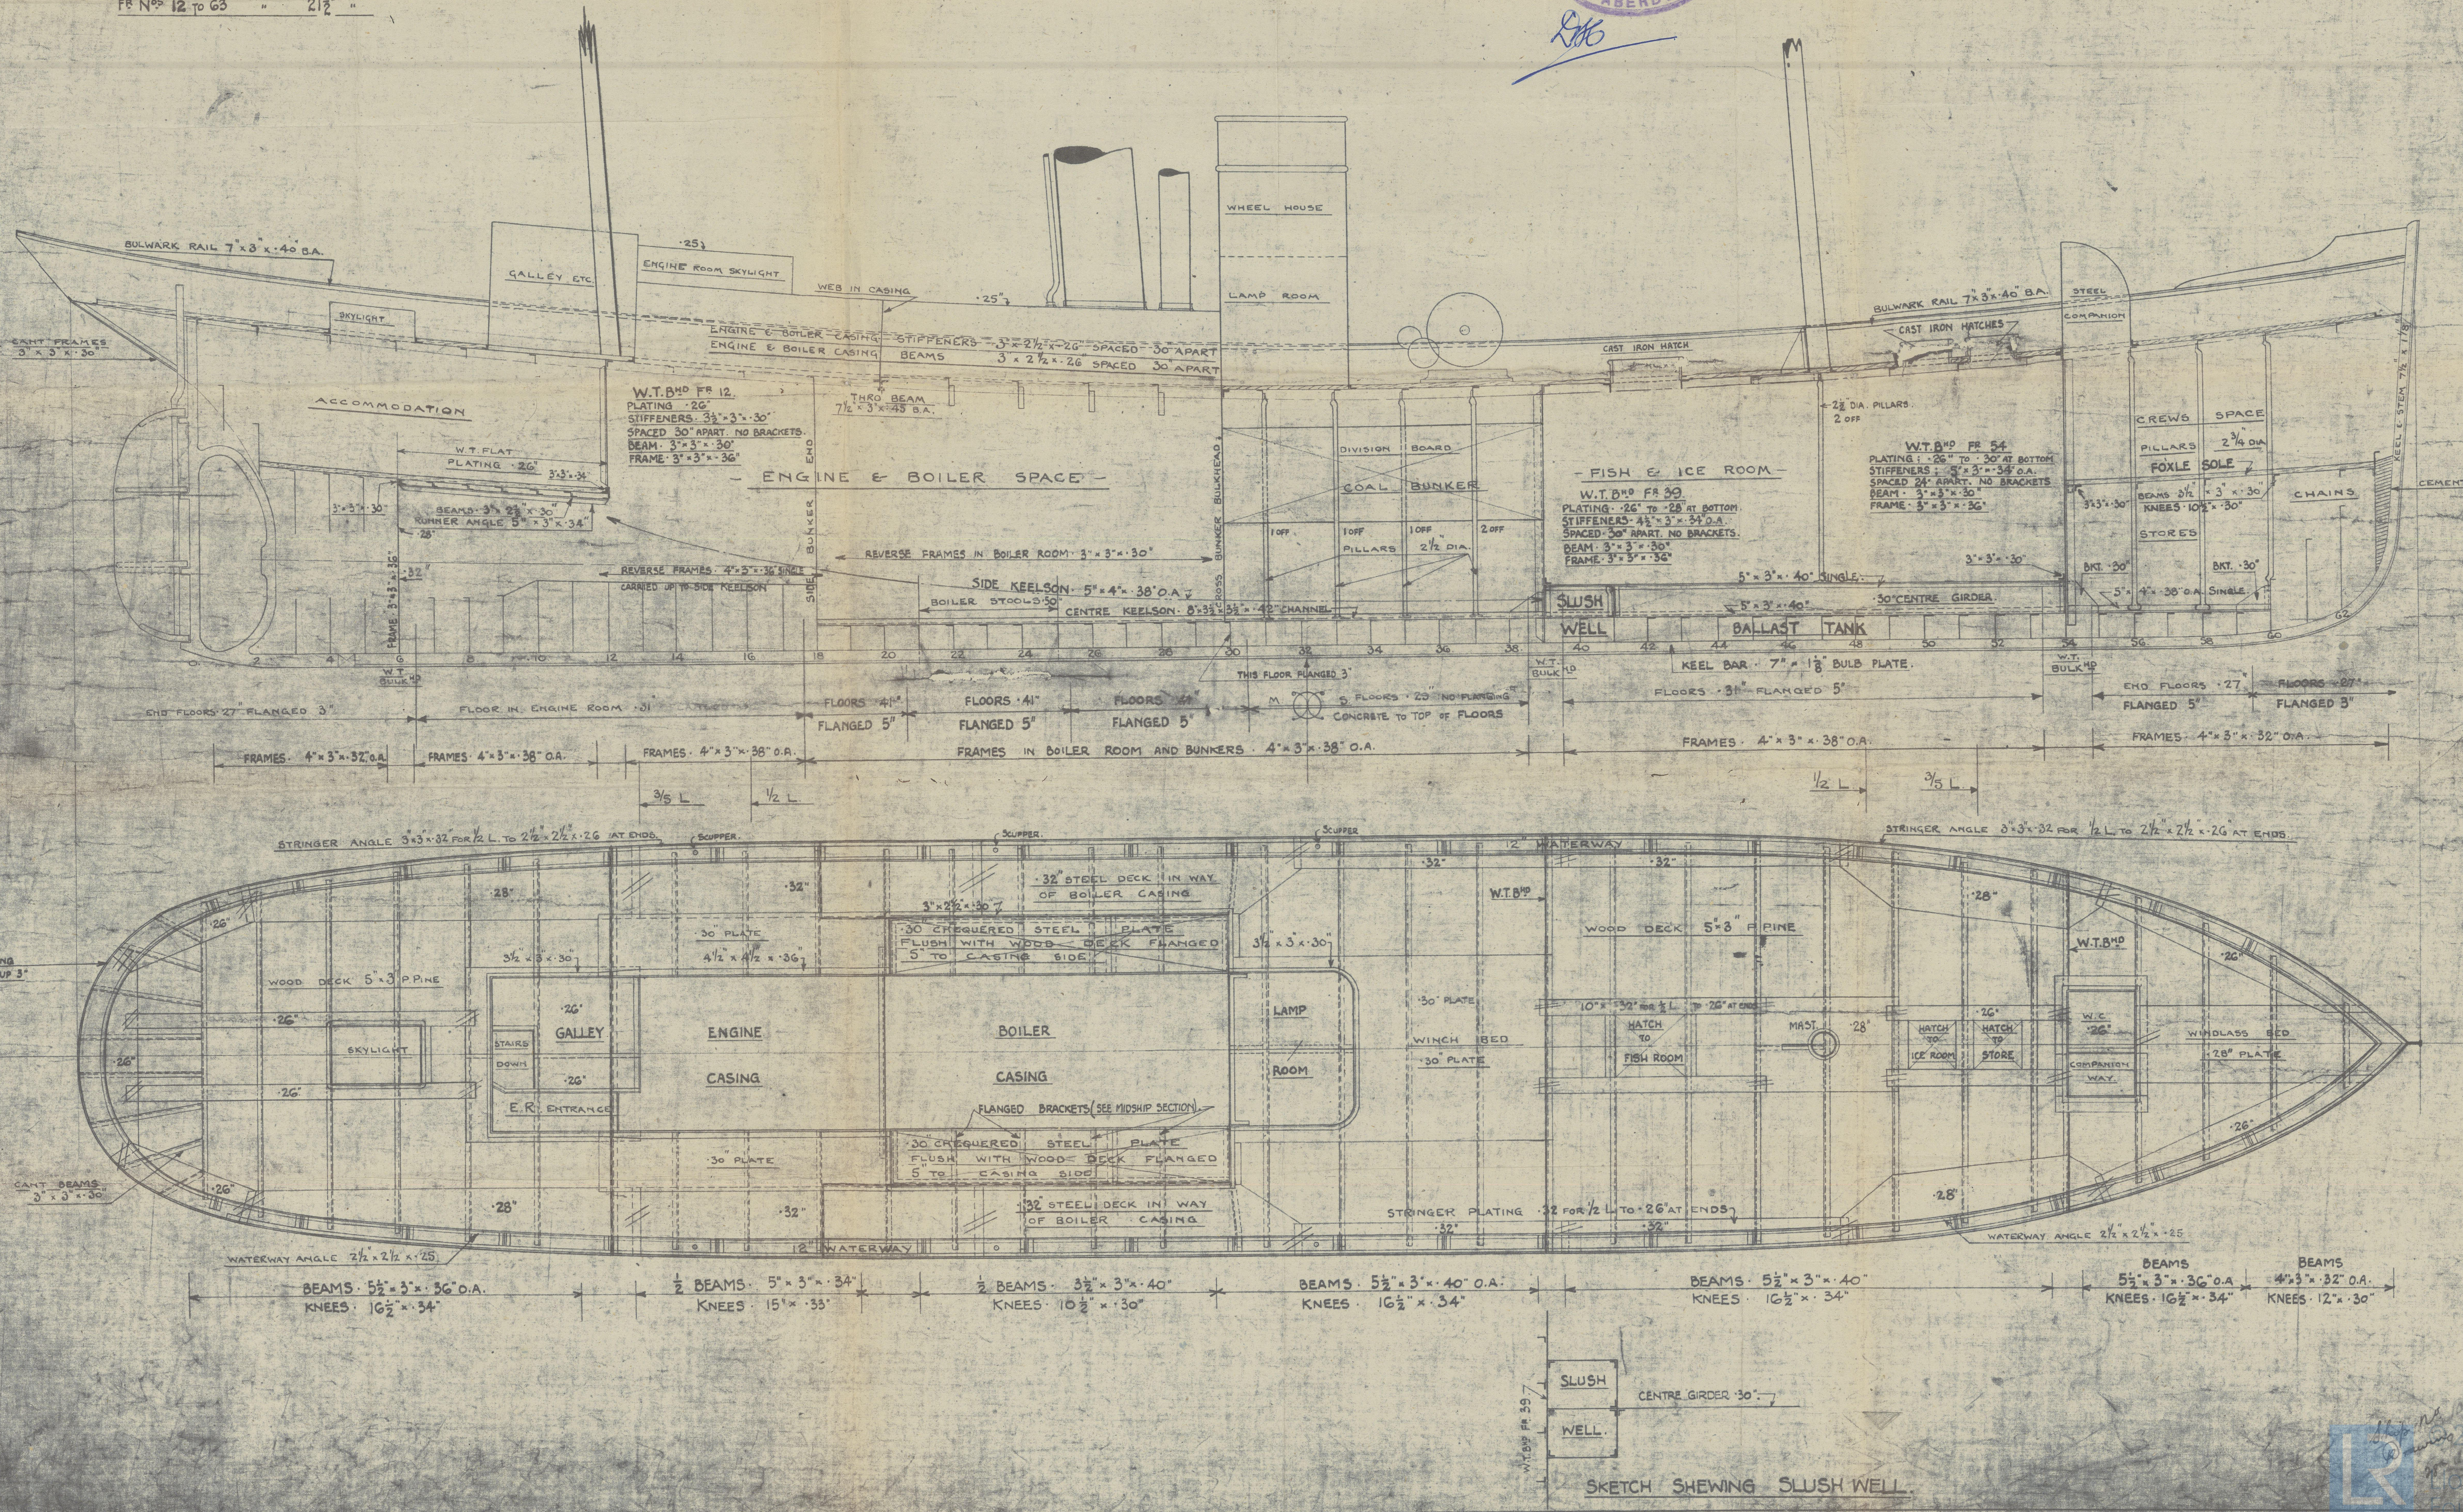

SKETCH SHewing SLUSH WELL

Bay




© 2021

Lloyd's Register
Foundation

Profile & Deck

Steel Screw Trawler

Joint

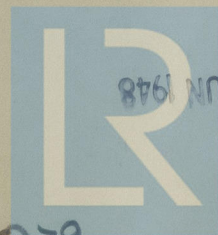

© 2021

Lloyd's Register
Foundation

002682-002689-0079

2

Profile & Deck

5/2 FORT DEK

Lewis & Sons. 25.6.18.



© 2021

Lloyd's Register
Foundation

002682-002689-0079