


for S/S N^o 81.
15-12-98.

S.S. N^o 78 & 81.

N^o 81. - approved by letter Sec. M. 15 December 98
S.I. N^o 78. 240'-0, 42'-6, 21'-10 - approved on 29 November 98
1/8" = 1' engl meas.

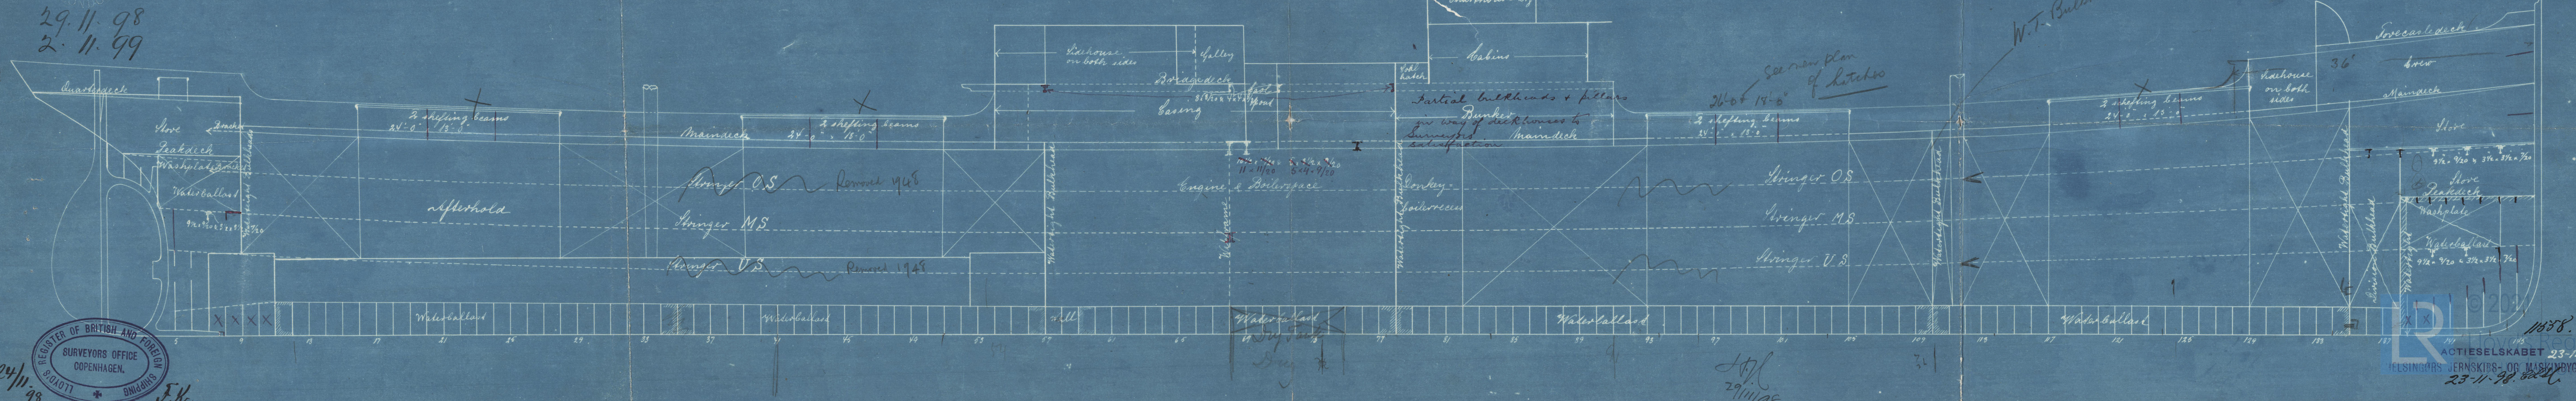

1958.
Aktieselskabet 23-11-98.
Helsingørsk Jernskibs- og Maskinbyggeri.
23-11-98.

"LAILA"

Profile plan.

Elmore 5/8 N^o 78481



24/11.98 15/12.98

Sd. Erika



Chn 1285.

Grand Book



© 2021

Lloyd's Register
Foundation