
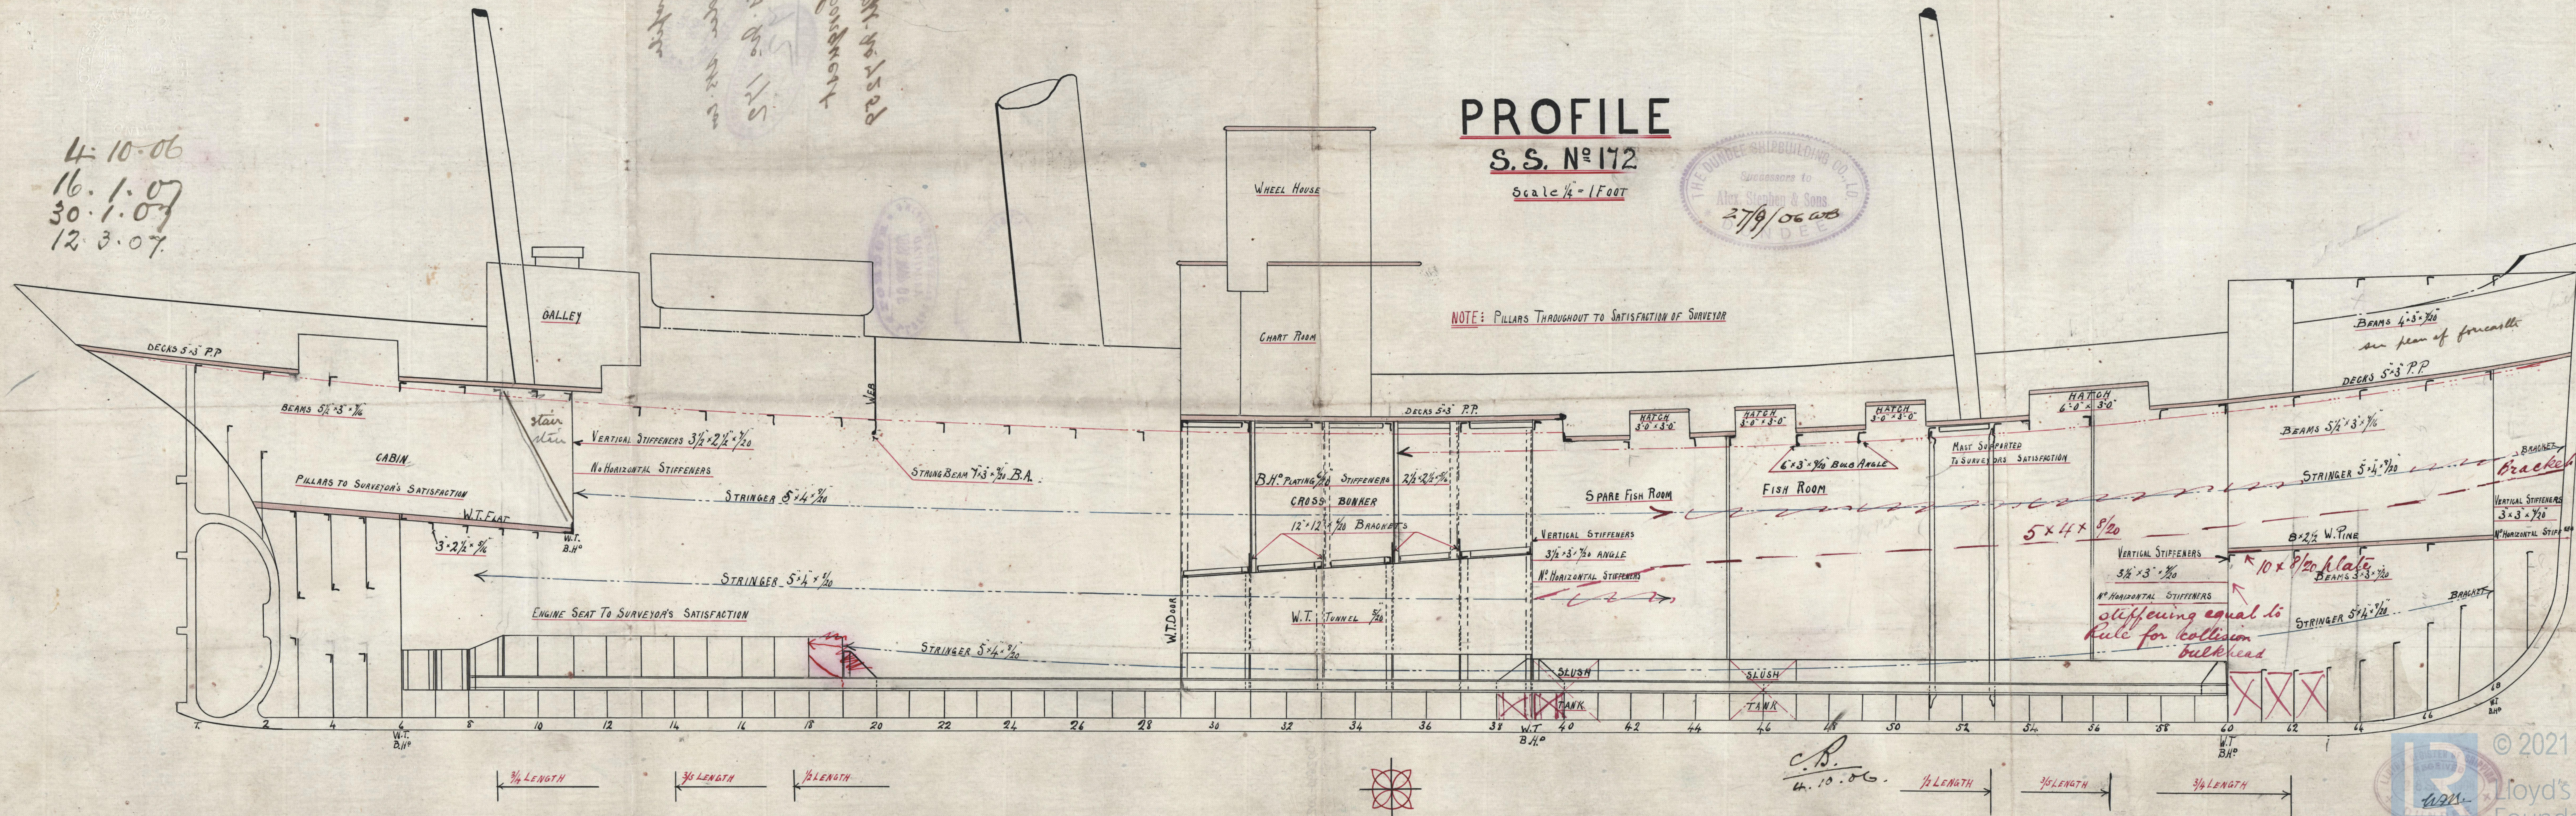


[illegible]

Scale $\frac{1}{4}'' = 1 \text{ FOOT}$

NOTE: PILLARS THROUGHOUT TO SATISFACTION OF SURVEYOR

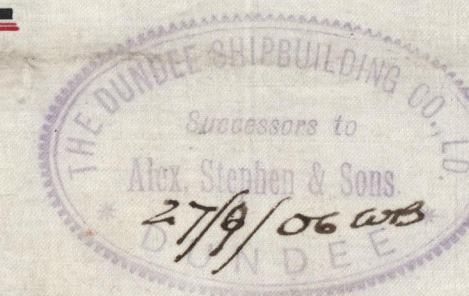

Profile

Stunden 273. Cor

ss. no 172
172

S. S. Conquest

Sum Apts. no. 7259

