

(260) 14.4.14
9.1.15.

MIDSHIP SECTION,
S.S.N^{os} 256 & 7

SCALE 1/2" = ONE FOOT.

DIMENSIONS 180'-0" x 28'-6" x 13'-6" MOULDED

TO CLASS 100 A.I.

Alterations in Blue
as filled in ship



SECTION IN WAY OF QUARTER DECK.

SECTION IN WAY OF MAIN DECK.

BRIDGE DECK



BEAMS 5" x 3" x 34" ON ALT. FRAMES
STRINGER BAR 3" x 3" x 26"
STRINGER PLATE 31" x 26"
TIE PLATES 7" x 26" 18 ft. x 2.8
SIDE PLATING 26" x 28"
WOOD DECK 5" x 2 1/4" PITCH PINE

FORECASTLE DECK

BEAMS 5 1/2" x 3" x 34" ON ALT. FRAMES. KNEE 15" x 30"
STRINGER BAR 3" x 3" x 26"
STRINGER PLATE 31" x 26"
PLATED IN WAY OF HINDRANCE 66" x 30"
SIDE PLATING 26" x 28"
WOOD DECK 5" x 3" PITCH PINE

SECTION IN WAY OF BOILER SPACE

FRAMES 6" x 3" x 38" BULB ANGLE SPACED 22" APART.
REVERSE FRAMES 3" x 3" x 32" DOUBLE
FLOORS 16 1/2" x 4 1/2"

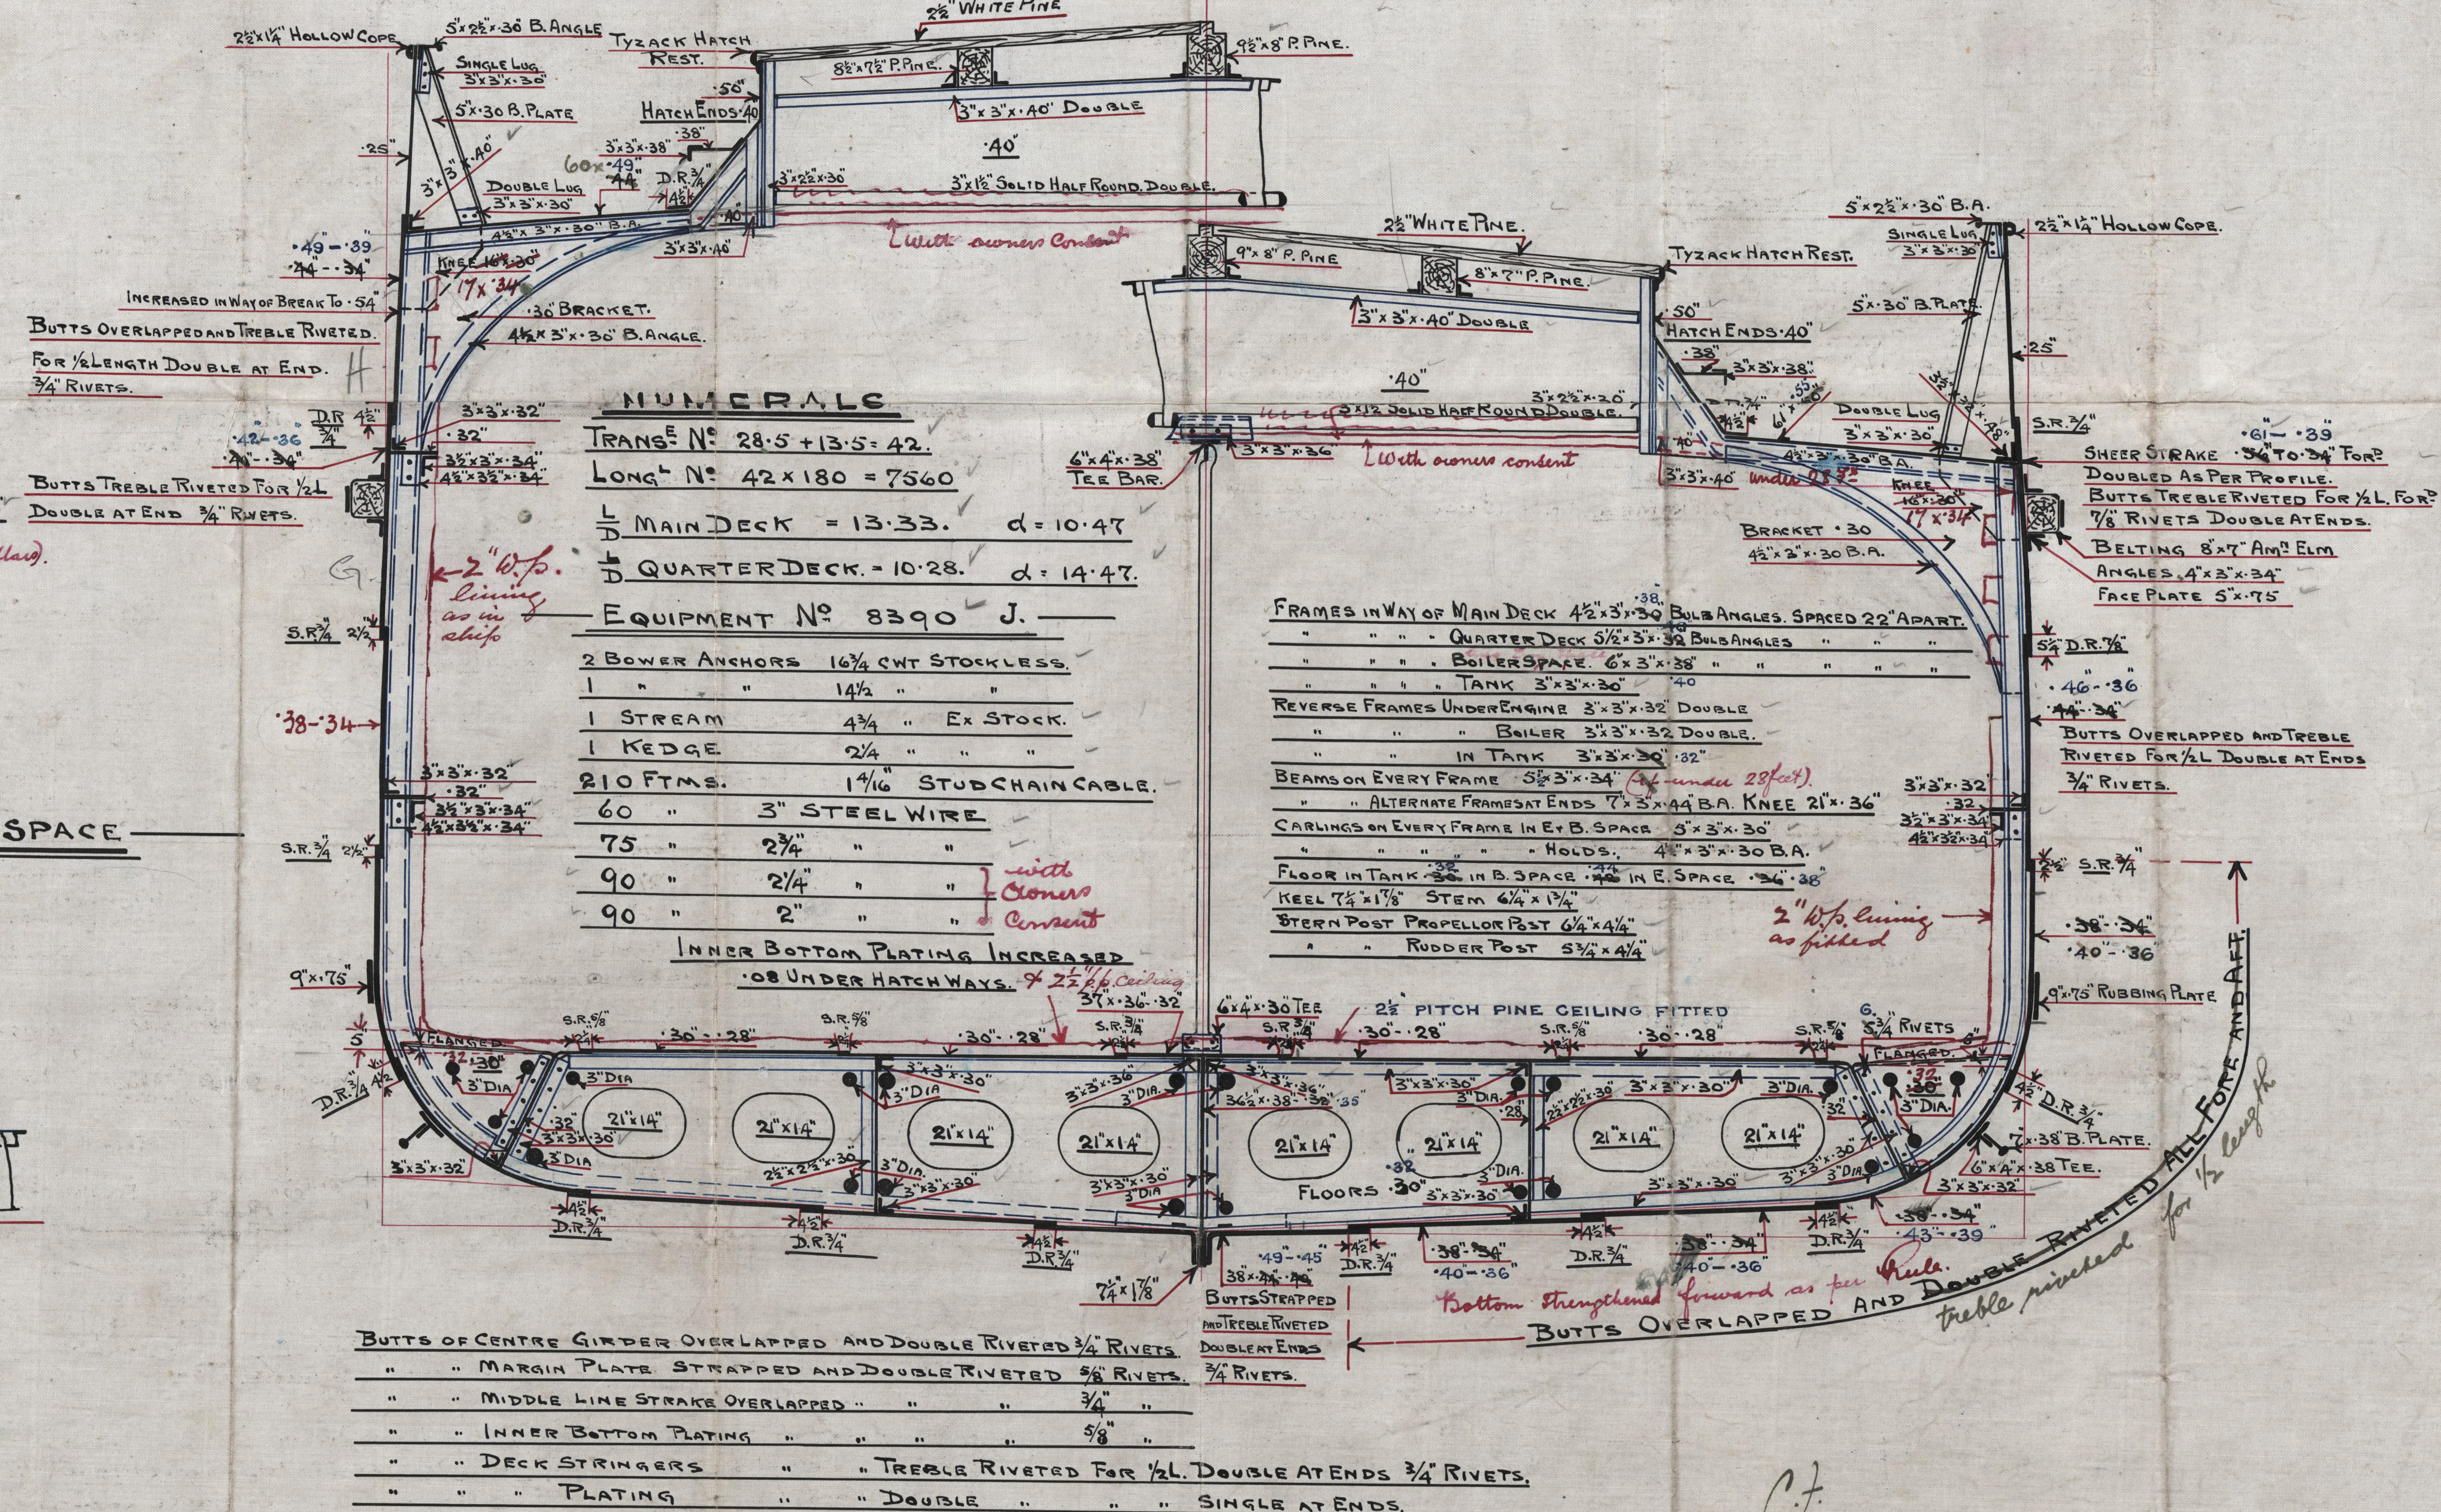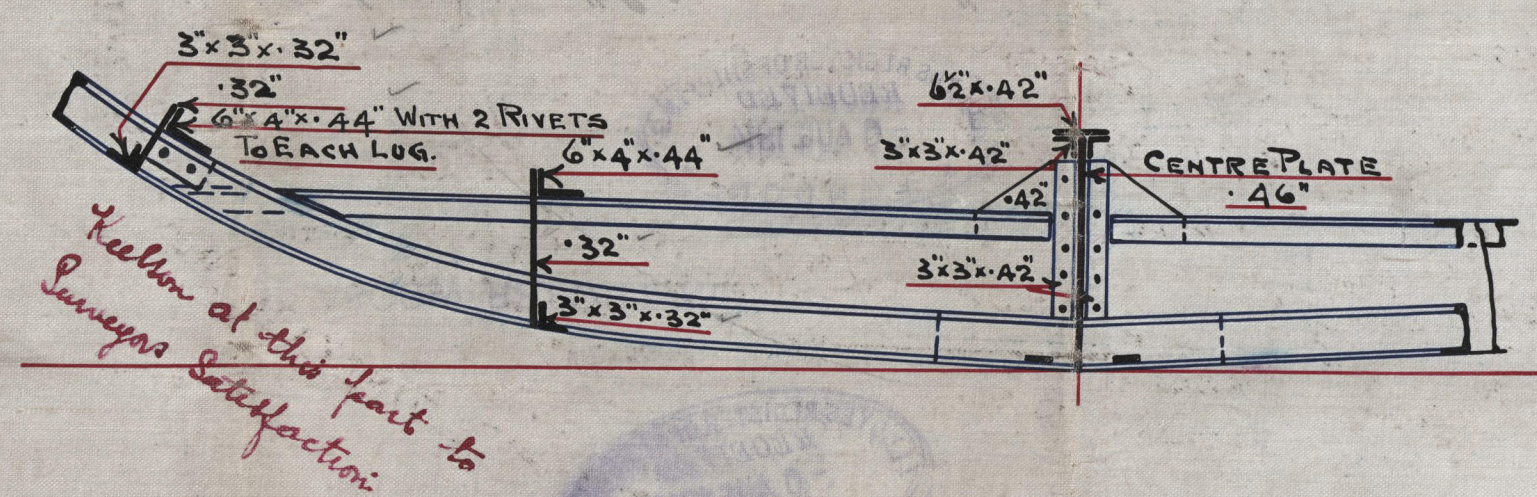

NUMERALS

TRANS^E N^o 28.5 + 13.5 = 42

LONG^E N^o 42 x 180 = 7560

L MAIN DECK = 13.33. d = 10.47

L QUARTER DECK = 10.28. d = 14.47

EQUIPMENT N^o 8390 J.

- 2 BOWER ANCHORS 16 1/2 CWT STOCKLESS.
- 1 " " 14 1/2 " " "
- 1 STREAM 4 3/4 " " Ex STOCK.
- 1 KEDGE 2 1/4 " " "
- 210 FTMS. 1 1/4" STUBCHAIN CABLE.
- 60 " 3" STEEL WIRE
- 75 " 2 3/4 " " "
- 90 " 2 1/4 " " "
- 90 " 2 " " "

INNER BOTTOM PLATING INCREASED
TO 1/8" UNDER HATCHWAYS.


- BUTTS OF CENTRE GIRDER OVERLAPPED AND DOUBLE RIVETED 3/4 RIVETS.
- " " MARGIN PLATE STRAPPED AND DOUBLE RIVETED 3/4 RIVETS.
- " " MIDDLE LINE STRAKE OVERLAPPED " " 3/4 "
- " " INNER BOTTOM PLATING " " 5/8 "
- " " DECK STRINGERS " " TREBLE RIVETED FOR 1/2 L. DOUBLE AT ENDS 3/4 RIVETS.
- " " PLATING " " DOUBLE " " SINGLE AT ENDS.

C.F.
14.4.14


Scott & Sons

No 256-7 + 60

Underwriting Section

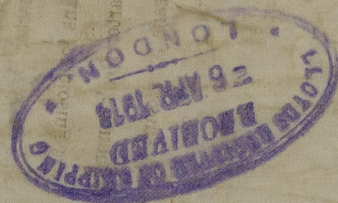

GLASGOW REPORT No.

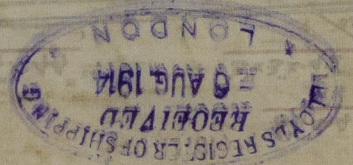

No 256 "Clarecastle"

No 257 "Clareisland"

GLASGOW REPORT No. 35476.

GLASGOW REPORT No. 37235

5/5 Claremorris



© 2020

Lloyd's Register
Foundation

002701-002710-0021