


— PROFILE AND DECK PLAN —



STANDARD VESSELS C.5 TYPE

DIMENSIONS 240'-0" B.P. x 36'-0" M.D. x 21'-3" M.D.



SCALE $\frac{1}{8}$ INCH = 1 FOOT.

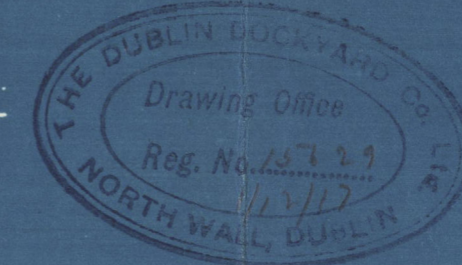

see also Midships section
for modified scantlings

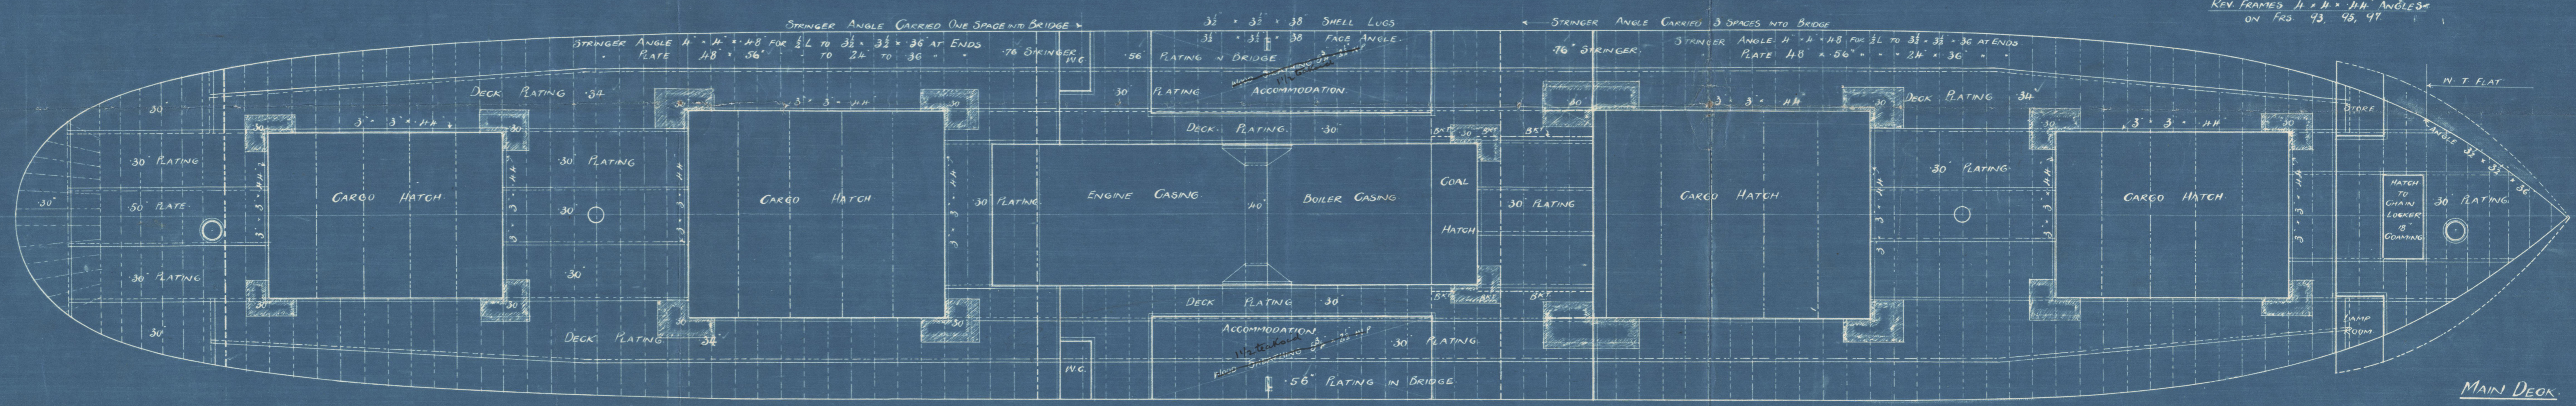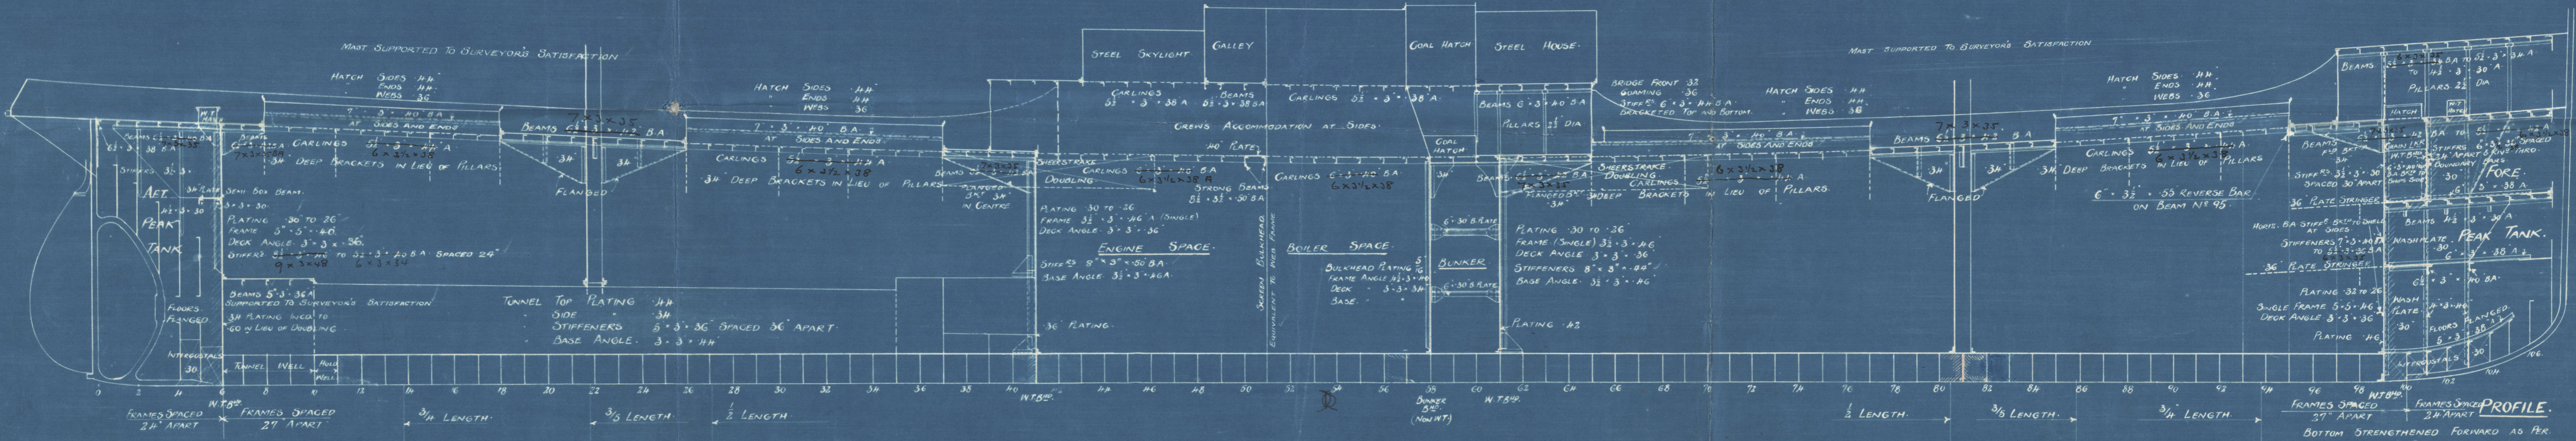

APPROXIMATE PARTICULARS FOR FREEBOARD
 REGISTERED DIMENSIONS 240'-2" x 36'-2" x 18'-8"
 UNDER DECK TONNAGE (APPROX.) 1295 TONS
 SHEER AT STEM = 5'-3", AT $\frac{1}{8}$ L. FROM STEM = 2'-7"
 " " STERN = 4'-3" " " STERN = 2'-9"
 BRIDGE, LOOSE PLATE DOORS AT FORE END.
 BRIDGE CLOSED AT AFTER END.
 FORECASTLE, OPEN DOORWAY CLOSED WITH WOOD PLANKS.

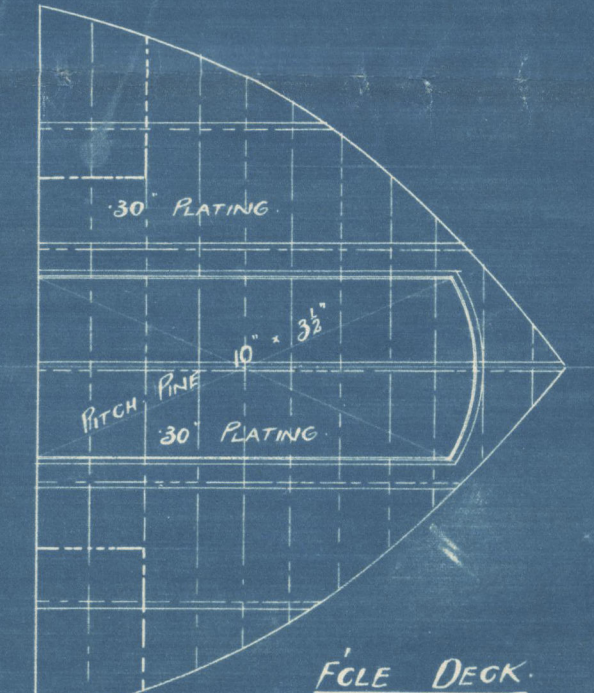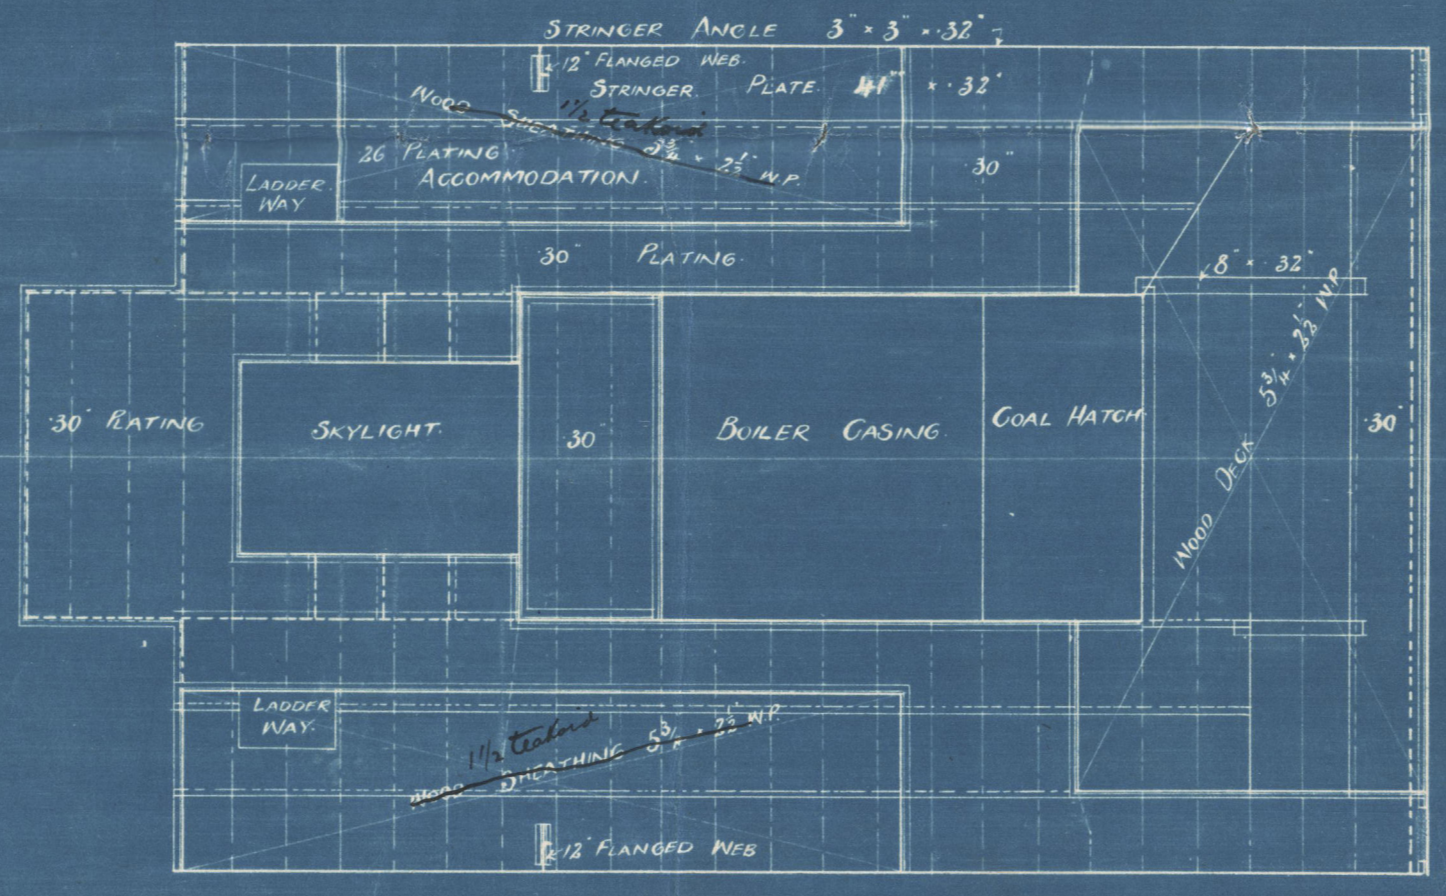

669

855

002701-002710-0044



© 2020

Lloyd's Register
Foundation

PROFILE & DECK

STANDARD VESSELS "C.S. TYPE."

DUNDEE S. B. Co., LD.

Y.O. N^o 314


S. S. "CHALDON"

DUN. PORT. No. 8198.


Now.

ELPIS. *

2

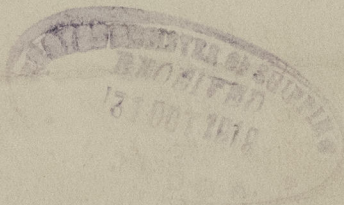

RECORDS DEPT.
LONDON.

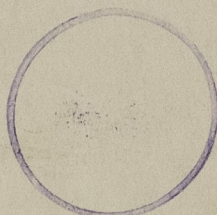

© 2020

Lloyd's Register
Foundation

002701-002710-0044